



CITY OF WOODCREEK

(HAYS COUNTY, TX.)

REHABILITATION OF DEERFIELD DR.


CIVIL SITE PACKAGE

DEERFIELD DRIVE
WOODCREEK TEXAS, 78676

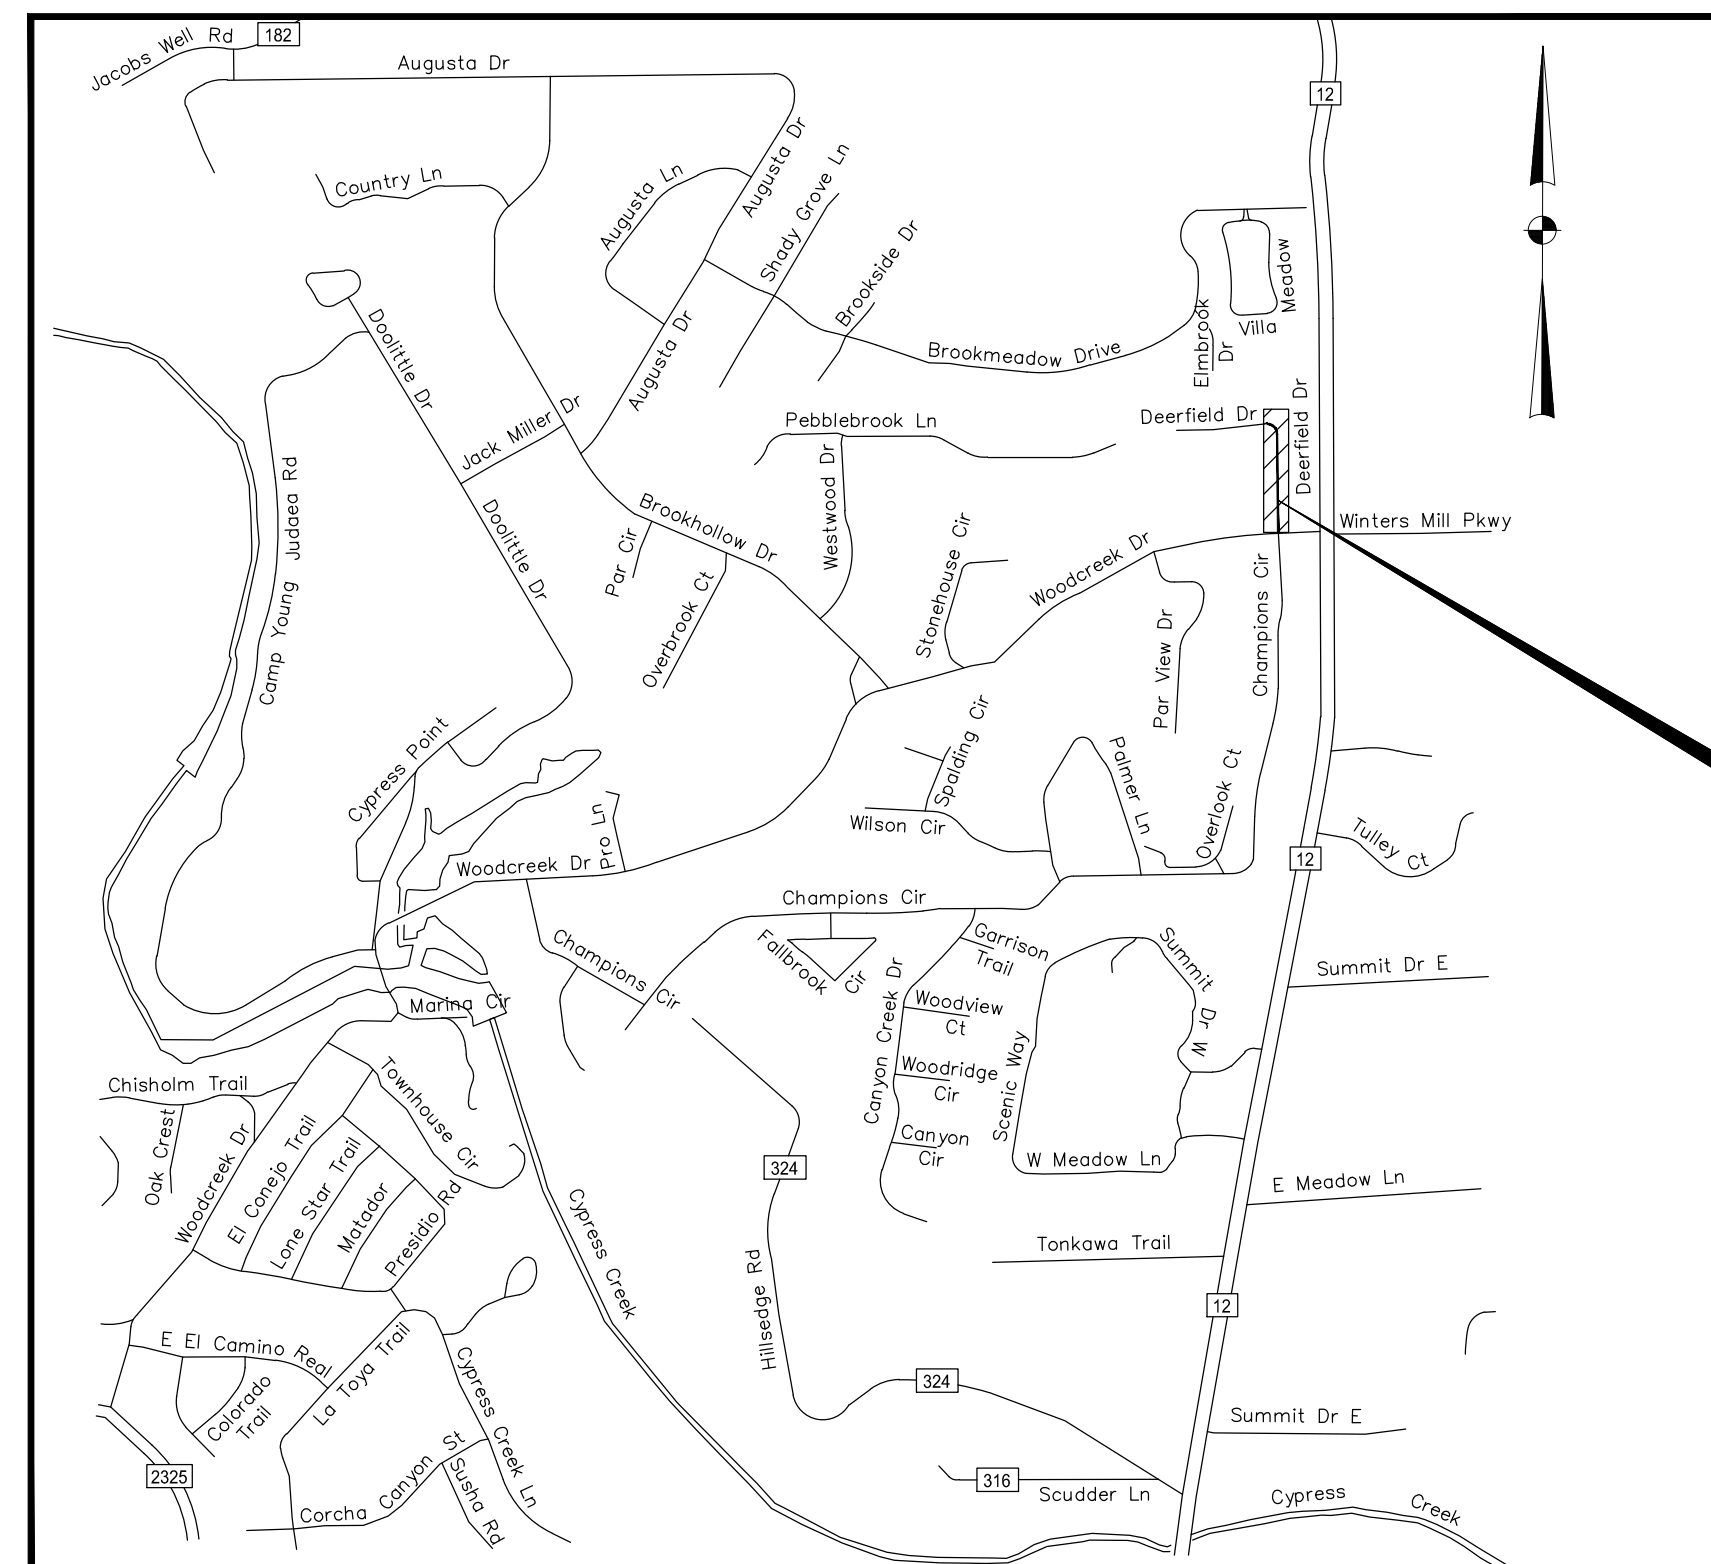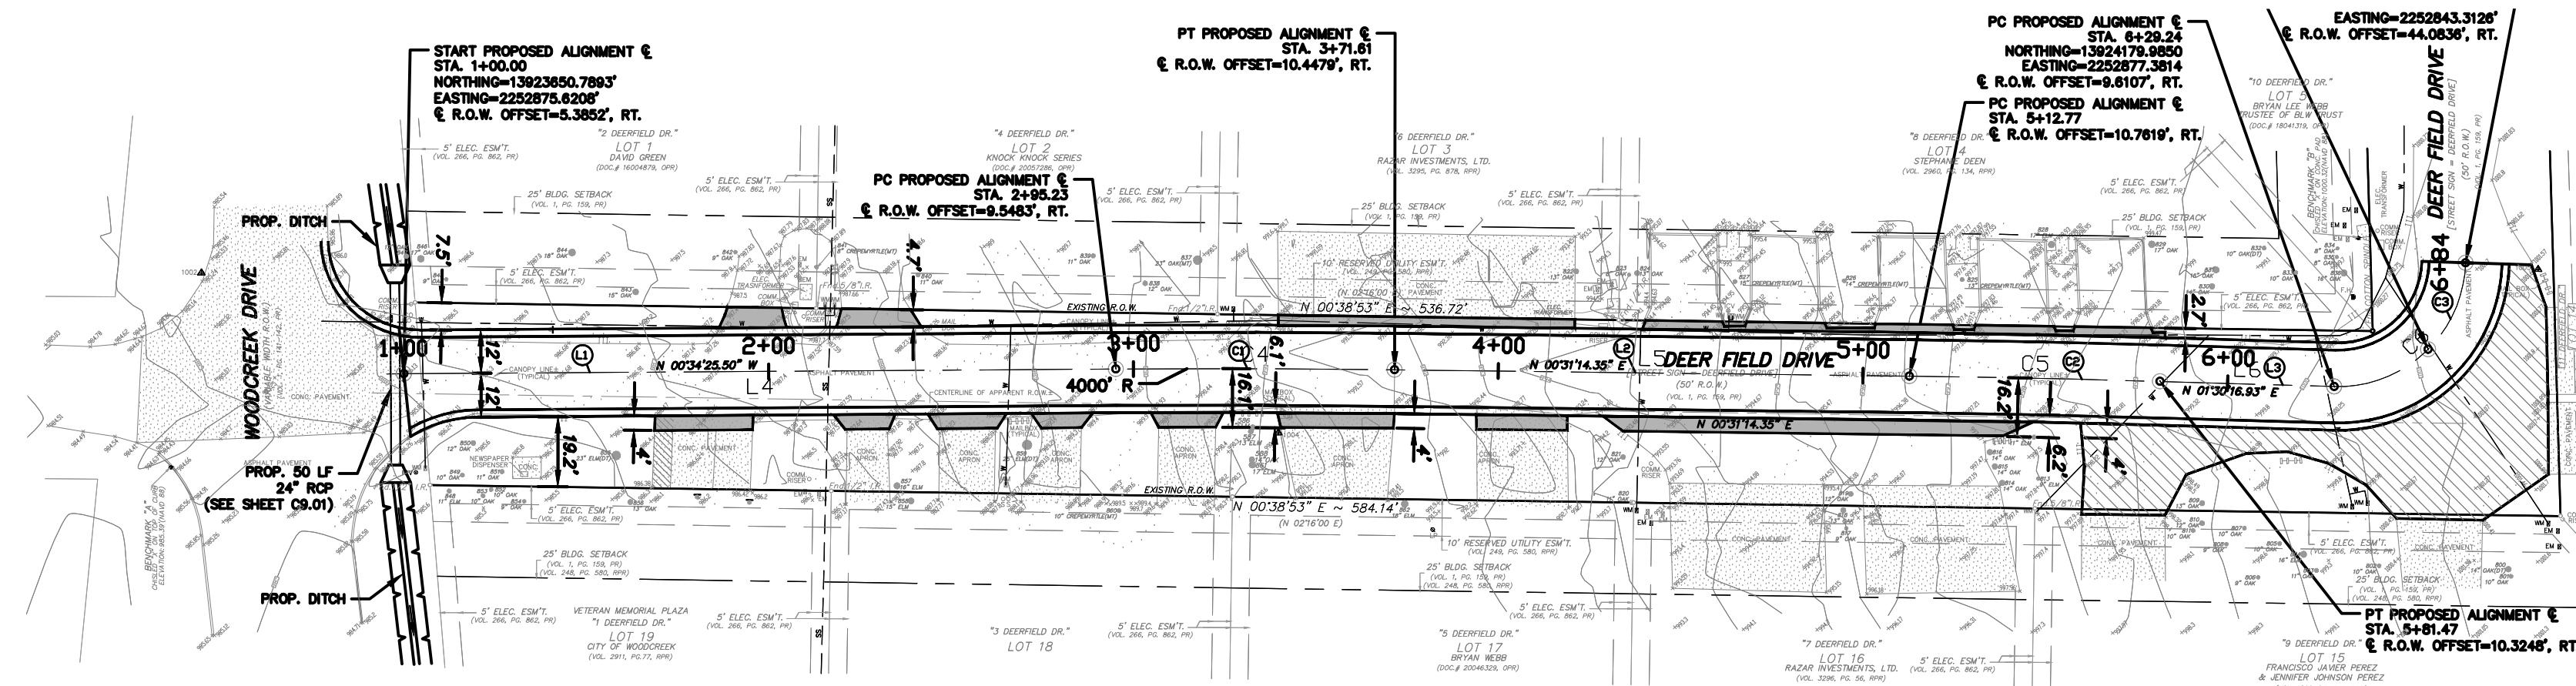


LOCATION MAP

PROJECT LOCATION

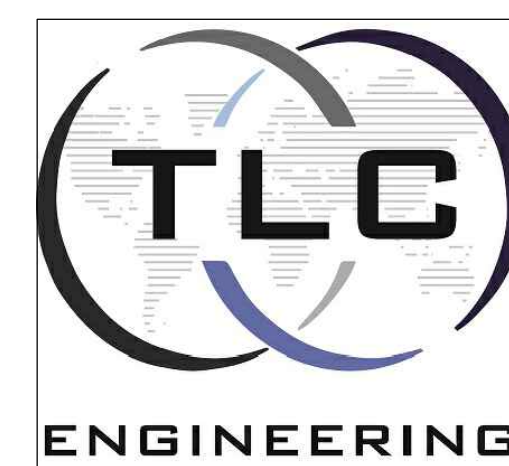

8204 WESTGLEN DRIVE
HOUSTON, TEXAS 77063
Phone: 713-868-6900 Fax: 713-868-0001
www.tlceng.com

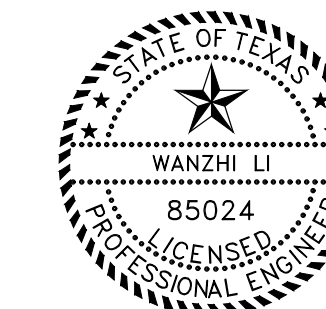

100% SUBMITTAL

REV. NO.	DATE		P.E. APPR.

(Design Engineer)
(Design Firm)

_____, P.E.
Director of Engineering

DATE: _____

DATE: _____

INDEX OF SHEETS


SHEET NUMBER	SHEET TITLE	SHEET NUMBER	SHEET TITLE
C0.00	COVER	C6.04	CROSS SECTIONS - STA 4+25.00 TO STA 6+00.00
C0.01	INDEX SHEET	C6.05	CROSS SECTIONS - STA 6+25.00 TO STA 6+75.00
C0.02	DESIGN NOTES	C7.01	PAVING NOTES AND DETAILS SHEET (1 OF1)
C0.03	GENERAL NOTES AND LEGEND	C7.02	DRIVEWAY NOTES AND DETAILS
C0.04	SUMMARY OF QUANTITIES	C7.03	SWPPP SHEET
C1.01	TOPOGRAPHIC SURVEY (1 OF 1)	C7.04	SWPPP NOTES AND DETAILS
C2.01	DEMOLITION PLAN	C7.05	CONSTRUCTION SEQUENCE SHEET
C3.01	PLAN AND PROFILE 1 OF 2	C7.06	TREE PROTECTION DETAIL
C3.02	PLAN AND PROFILE 2 OF 2	C8.01	PAVEMENT MARKINGS AND SIGNAGE
C4.01	DETAIL SHEET	C8.02	PAVEMENT MARKINGS DETAILS
C5.01	SITE GRADING PLAN	C8.03	SIGN MOUNTING DETAILS
C6.01	TYPICAL SECTIONS	C9.01	CULVERT EXHIBIT
C6.02	CROSS SECTIONS - STA 0+25.00 TO STA 2+00.00	C9.02	CULVERT DETAILS
C6.03	CROSS SECTIONS - STA 2+25.00 TO STA 4+00.00		

NOTE:
 CONTRACTOR TO CONTACT CITY OF WOODCREEK CITY ADMINISTRATOR, JIM BURTON MIN. 48 HOURS PRIOR TO CONSTRUCTION @ 512-847-9390

FOR PERMITTING ONLY



ENGINEERING
 8204 Westglen Drive
 Houston, Texas 77063
 713.868.0001 WWW.TLCeng.com
 E-4066

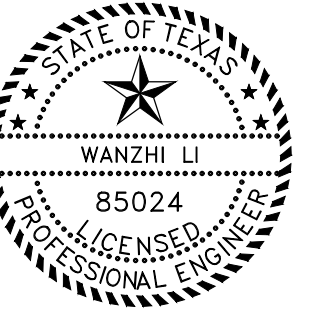

100% SUBMITTAL

CITY OF WOODCREEK
 DEERFIELD DRIVE
 WOODCREEK Texas, 78676

REVISION	
NO.	DATE

PROJECT #
 ISSUE:
 DATE:
 DRAWN BY:

INDEX SHEET
C0.01

DESIGN NOTES:

1. ALL MEASUREMENTS ARE CALLED OUT IN AMERICAN UNIT, FEET AND INCHES.
2. DESIGN SHOULD ABIDE BY TXDOT STANDARD SPECIFICATIONS, ROADWAY DESIGN MANUAL, PAVEMENT MANUAL AND RELATED STANDARDS.
3. ACCORDING TO CITY OF WOODCREEK REQUEST, THE TRAVEL LANE WIDTH LIMITS TO TEN FEET (10'-0").
4. THE ROADWAY SHOULD FURNISH TWO FEET (2'-0") SHOULDERS ALONG THE BOUNDARIES OF BOTH EAST AND WEST TRAVEL LANES.
5. THE ROADWAY ALIGNMENT WAS FORMED FOLLOWING THE EXISTING PAVEMENT ROUTE AND BOUNDARIES TO PROVIDE SIX FEET (6'-0") CLEARANCE BETWEEN THE EAST TRAVEL LANE AND THE EXISTING TREES FOR BYPASSING TREE REMOVAL AND FOUR FEET (4'-0") CLEARANCE BETWEEN THE WEST TRAVEL LANE AND EXISTING COMMUNICATION RISERS FOR SHELTERING THE RISERS.
6. BASED ON THE SURVEY DATA REPORTED, THE ROADWAY PROFILE ACCOMMODATES THE SCATTERED ELEVATIONS OF THE EXISTING ROADWAY PAVEMENT BY MEANS OF CURVE FITTING.
7. EXISTING PAVEMENT EXCAVATION AND STABILIZATION TREATMENT UPGRADING:
 - A DEMOLITION WIDTH SHOULD BE A MINIMUM OF TWENTY-FIVE FEET (25'-0") CONSISTING OF TWO TEN FEET (2 X 10'-0") TRAVEL LANES, A COMBINED FOUR FEET (4'-0") SHOULDERS, AND ONE-FOOT WORKING SPACE.
 - DEMOLITION DEPTH SHOULD REACH TO THE TOP OF THE EXISTING STABILIZATION TREATMENT LAYER.
 - REMOVE ALL LOOSE MATERIALS, DEBRIS, AND BLOW OUT DUST.
 - THE EXISTING STABILIZATION TREATMENT LAYER SHOULD BE INSPECTED AND ASSESSED.
 - CONFIRM THAT THE EXISTING STABILIZATION TREATMENT LAYER IS CONSOLIDATED AND FIRM WITH ADEQUATE STRENGTH FOR CAPABLE OF SUSTAINING THE NEW PAVEMENT DEADLOAD AND VEHICULAR TRAFFIC LOADS CONFORM TO TXDOT PAVEMENT MANUAL AND CST_TIPS_053QTR TABLE-1.
 - IF NECESSARY, EXISTING STABILIZATION TREATMENT LAYER MODIFICATION OR UPGRADING SHOULD BE CONDUCTED TO ENHANCE THE STRENGTH OF THE EXISTING TREATMENT LAYER OR TO INCREASE THE THICKNESS OF THE TREATMENT LAYER FOR ATTAINING THE DESIGNED ROADWAY ELEVATION.
 - BASED ON THE TOTAL DESIGNATED ASPHALT PAVEMENT THICKNESS OF FOUR AND HALF INCHES (4 1/2"), THE TOP ELEVATION OF THE STABILIZATION TREATMENT SHOULD NOT BE HIGHER THAN THE SPECIFIED LEVEL THAT EQUALS TO THE DESIGNATED ROADWAY ELEVATION MINUS FOUR AND HALF INCHES (4 1/2").
 - EITHER LIME STABILIZATION TREATMENT OR CEMENT STABILIZATION TREATMENT CAN BE USED FOR STABILIZATION TREATMENT MODIFICATION OR UPGRADING PER CONTRACTOR'S PREFERENCE UPON APPROVAL BY THE DESIGN ENGINEER.

8. EXISTING SUBGRADE INVESTIGATION AND MODIFICATION:

IT IS MANDATORY TO INVESTIGATE THE EXISTING SUBGRADE CONDITION TO FIND OUT WHETHER THE EXISTING SUBGRADE COVERS THE FULL WIDTH OF THE TWENTY-FIVE FEET (25'-0") PAVEMENT, AS WELL AS THE AREA WHERE THE ROADWAY TURNS NORTHWARD TO WESTWARD, TO DETERMINE WHETHER A SUBGRADE MAKE-UP CONSTRUCTION IS NECESSARY.

OPTION-ONE: CONDUCT SITE BORING AND TEST RIGHT AFTER THE 60% DESIGN SUBMITTAL TO DETERMINE WHETHER SUBGRADE MAKE-UP IS NECESSARY, ESPECIALLY IN THE SCOPE BEYOND THE TWENTY FEET (20'-0") TRAVEL LANES. THEN, INCLUDE THE SUBGRADE MAKE-UP DESIGN IN THE 100% DESIGN SUBMITTAL, IF REQUIRED.

OPTION-TWO: INVESTIGATE THE SUBGRADE CONDITION DURING EXISTING PAVEMENT EXCAVATION OR DEMOLITION CONSTRUCTION TO DETERMINE WHETHER SUBGRADE MAKE-UP IS NECESSARY ON CONDITION THAT SUBGRADE MAKE-UP MATERIALS AND MACHINERY PRESERVED FOR USE WHEN NECESSARY TO PREVENT DELAY OF PROJECT CONSTRUCTION.

9. APPLY 3/16" TACK COAT ATOP THE STABILIZATION TREATMENT LAYER RIGHT BEFORE DEPLOYING THE FIRST COURSE OF ASPHALT FOR BONDING PURPOSE BETWEEN THE STABILIZATION TREATMENT LAYER AND THE FIRST COURSE OF ASPHALT. APPLICATION OF TACK COAT MAY BE ELIMINATED BASED ON ENGINEERING JUDGMENT PERTAINING TO SURFACE ROUGHNESS OF THE STABILIZATION TREATMENT, THE WEATHER DURING CONSTRUCTION AND WORKABILITY OF ASPHALT.

10. HOT MIXTURE AND COLD LAID ASPHALT CONCRETE (HMAC) SHALL BE IMPLEMENTED TO REPAVE THE ROADWAY THAT CONSISTS OF TWO ASPHALT COURSES:

- 2", MAXIMUM OF 2 1/2", SUB-COURSE AS THE BASE LAYER OF THE PAVEMENT.
- 3/16" TACK COAT IN BETWEEN THE TWO COURSES FOR EMULSIFICATION PURPOSE.
- 2", MINIMUM 1 1/2", TOP COURSE AS THE SURFACE OF THE PAVEMENT.

11. IF THE ROADWAY REPAVING CONFLICTS WITH THE EXISTING UTILITIES AND FACILITIES, ESPECIALLY THOSE PRIVATE FACILITIES SUCH AS MAILBOXES BUILT INSIDE THE ROW OF DEERFIELD DRIVE, THE SPECIFIED FACILITIES SHOULD BE DEMOLISHED OR RELOCATED AT THE OWNER'S COST.

12. STORM DRAINAGE DESIGN PERTAINING TO ENVIRONMENTAL ASSESSMENT AND DRAINAGE DESIGN WITH THE FOLLOWING CONSTRUCTION:


- FURNISH A 24" CULVERT, AS SHOWN IN SHEET C9-01, AT THE SOUTH END OF DEERFIELD RD.
- ANY EXISTING SUBSURFACE WATER/SEWER LINE CONFLICT WITH THE CULVERT ALIGNMENT OR ELEVATION SHOULD BE RESOLVED DURING CULVERT CONSTRUCTION.
- OPEN DITCH ALONG THE NORTH EDGE OF WOODCREEK DRIVE, FLOWING WEST TO EAST WITHIN DEERFIELD RD. R.O.W..

IF UTILITIES NEED TO BE RELOCATED, THIS COULD HAVE LONG LEAD AND CREATE PROJECT DELAYS. DESIGN ENGINEER SHOULD COORDINATE/DESIGN TO MINIMIZE DELAY POTENTIAL



ENGINEERING

8204 Westglen Drive
Houston, Texas 77063
713.868.0001 WWW.TLCeng.com
E-4066

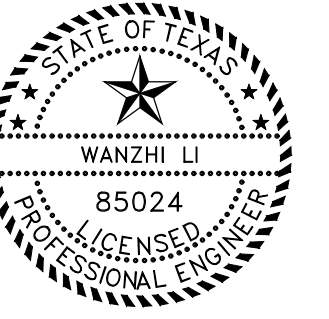

100% SUBMITTAL

**CITY OF WOODCREEK
DEERFIELD DRIVE
WOODCREEK Texas, 78676**

REVISION	
NO.	DATE

PROJECT #
ISSUE:
DATE:
DRAWN BY:

DESIGN NOTES

C0.02

CONSTRUCTION NOTES

1. THE CONTRACTOR SHALL FIELD VERIFY EXISTING CONDITIONS BEFORE BEGINNING CONSTRUCTION.
2. THE CONTRACTOR IS RESPONSIBLE FOR PROVIDING SECURITY TO PROTECT THE PROJECT SITE, CONTRACTOR PROPERTY, EQUIPMENT, AND WORK.
3. THE CONTRACTOR IS RESPONSIBLE FOR CLEANING STREETS OF CONSTRUCTION DIRT AND DEBRIS AT CLOSE OF EACH WORK DAY.
4. THE CONDITION OF THE ROAD AND/OR RIGHT-OF-WAY, UPON COMPLETION OF THE JOB SHALL BE AS GOOD AS OR BETTER THAN PRIOR TO STARTING WORK.
5. PRIOR TO CONSTRUCTION, THE CONTRACTOR, ALONG WITH CONCURRENCE FROM THE FIELD ENGINEER, SHALL DETERMINE HIS/HER LAY-DOWN AND/OR STAGING AREA LOCATIONS.
6. THE CONTRACTOR SHALL NOTIFY ALL PROPERTY OWNERS A MINIMUM OF 24 HOURS PRIOR TO BLOCKING DRIVEWAYS OR ENTERING UTILITY EASEMENTS.
7. TRAFFIC INGRESS AND EGRESS FOR DRIVEWAYS AND PEDESTRIAN ACCESS FACILITIES SHALL BE MAINTAINED THROUGHOUT CONSTRUCTION.
8. THE CONTRACTOR SHALL REMOVE ANY FENCES, POSTS, MAILBOXES, PLANTERS, PERMANENT TRASH CONTAINERS, CULVERTS, ETC. OR SECTIONS THEREOF, THAT ENCR OACH WITHIN THE COUNTY'S RIGHT-OF-WAY. NOTE: PRIOR TO CONSTRUCTION, THE PROPERTY OWNER WAS PAID TO RELOCATE OR REPLACE THESE ITEMS OUTSIDE OF THE COUNTY'S RIGHT-OF-WAY. IF THE OWNER HAS FAILED TO DO SO, THE CONTRACTOR WILL REPLACE THEM WITH THE MINIMUM LEVEL OF QUALITY NEEDED TO SECURE THE PROPERTY AND/OR MAINTAIN MAIL DELIVERY. IN THAT CASE, PAYMENT FOR THESE INSTALLATIONS WILL BE INCLUDED AS EXTRA WORK ITEMS OR AS OVERRUNS TO EXISTING PAY ITEMS.

 ANY DAMAGE CAUSED BY THE CONTRACTOR TO SUCH ITEMS LOCATED OUTSIDE OF THE COUNTY'S RIGHT-OF-WAY, SHALL BE REPLACED WITH LIKE-KIND OR BETTER AT THE CONTRACTOR'S EXPENSE.

 ALSO, IF THESE ITEMS ARE LOCATED WITHIN THE PROJECT RIGHT-OF-WAY AND ARE DESIGNATED TO REMAIN, ANY DAMAGE CAUSED BY THE CONTRACTOR TO SUCH ITEMS, SHALL BE REPLACED WITH LIKE-KIND OR BETTER AT THE CONTRACTOR'S EXPENSE.

 TREES, BUSHES, SHRUBBERY AND OTHER DAMAGED PLANTINGS DESIGNATED TO REMAIN SHALL BE REPLACED WITHIN 72 HOURS OF REMOVAL AND ARE TO BE THOROUGHLY WATERED-IN. NO SEPARATE PAY.
9. PAVED SURFACES, PAVEMENT MARKERS AND MARKINGS SHALL BE PROTECTED FROM DAMAGE BY TRACKED EQUIPMENT.
10. IRON RODS DISTURBED DURING CONSTRUCTION ARE TO BE REPLACED BY A REGISTERED PROFESSIONAL LAND SURVEYOR FOR THE ORIGINAL PROPERTY OWNER AT NO SEPARATE PAY.
11. CONSTRUCTION STAKING WILL BE PROVIDED BY THE CONTRACTOR. TWO COPIES OF STAKING NOTES TO BE PROVIDED TO THE ENGINEER PRIOR TO CONSTRUCTION.
12. THE COUNTY OR THE COUNTY'S SURVEYOR SHALL PROVIDE A BENCHMARK OR TEMPORARY BENCHMARK AND SURVEY CONTROLS.
13. THE CONTRACTOR SHALL MAINTAIN UPDATED RED-LINED RECORD DRAWINGS ON SITE FOR INSPECTION BY THE ENGINEER.
14. MOWING, MAINTENANCE, AND CLEAN-UP OF THE PROJECT SHALL MEET THE REQUIREMENT OF SPECIFICATION TXDOT ITEM 580 (NO SEPARATE PAY). MOWING, MAINTENANCE, AND CLEAN-UP IS REQUIRED FOR THE PROJECT LIMITS AND DURATION, REGARDLESS OF THE CONTRACTOR'S SCOPE OF ACTIVITIES WITHIN THE PROJECT LIMITS.
15. THE REMOVAL OF ANY ABANDONED UTILITIES REQUIRED TO COMPLETE THE WORK SHALL BE INCIDENTAL AND NO SEPARATE PAYMENT SHALL BE MADE.
16. IT IS THE CONTRACTOR'S RESPONSIBILITY TO STOCKPILE NECESSARY MATERIAL ON-SITE OR AT A SECURED OFF-SITE LOCATION AT NO ADDITIONAL EXPENSE TO THE CONTRACTED FEE. ANY SUITABLE EXCAVATED MATERIAL ON THE PROJECT WHICH IS AVAILABLE AT THE TIME OF NEED; WHETHER FROM STORM SEWER, ROADWAY, AND/OR CHANNEL EXCAVATION, SHALL BE USED BEFORE BORROW IS BROUGHT ON-SITE.
17. MANHOLES, JUNCTION BOXES, INLETS, AND RISERS ARE TO BE PRE-CAST OR CAST IN PLACE.


TRAFFIC CONTROL

1. THE CONTRACTOR SHALL PROVIDE AND INSTALL TRAFFIC CONTROL DEVICES IN CONFORMANCE WITH PART VI OF THE MOST RECENT EDITION OF THE MANUAL ON UNIFORM TRAFFIC CONTROL DEVICES AND THE TRAFFIC CONTROL PLANS ARE APPROVED BY THE CITY OF WOODCREEK.
2. THE CONTRACTOR SHALL MAINTAIN AT LEAST ONE LANE OF TRAFFIC IN EACH DIRECTION DURING WORKING HOURS EXCEPT DURING FLAGGING OPERATION OR PROVIDE DETOURS AROUND THE CONSTRUCTION SITE AND PROVIDE PUBLIC NOTIFICATION.
3. LANE CLOSURES SHALL PROVIDE CONVENIENCE FOR RESIDENTS ACCESS TO AND EXIT FROM THEIR PROPERTIES.
4. DETOURS REQUIRE PRIOR APPROVAL OF THE FIELD ENGINEER AND PRECINCT. DETOUR PLANS, IF ALLOWED, MUST INCLUDE APPROPRIATE DETOUR SIGNAGE, PUBLIC NOTICE VIA SIGNAGE TWO WEEKS IN ADVANCE STATING THE DATES OF THE AGREED UPON DATE OF CLOSURE AND DATE THE ROAD WILL RE-OPEN TO TRAFFIC. CONTRACTOR TO USE (WITH PRIOR APPROVAL OF THE FIELD ENGINEER) HIGH EARLY STRENGTH CONCRETE AND OTHER RELATED CONSTRUCTION METHODS TO MINIMIZE THE DURATION OF THE DETOUR AND TO ENSURE THAT THE ROADWAY IS OPEN ON, OR PRIOR TO, THE AGREED UPON DATE.
5. ONE DAY PRIOR TO THE IMPLEMENTATION OF A TRAFFIC CONTROL PLAN PHASE OR STEP, OR THE IMPLEMENTATION OF AN ADDITIONAL, REVISED, OR NEW TRAFFIC CONTROL ELEMENT, THE CONTRACTOR SHALL MEET WITH THE ENGINEER TO GIVE A DETAILED DESCRIPTION OF THE CONTRACTOR'S PLAN AND PREPARATIONS. THE CONTRACTOR SHALL OBTAIN WRITTEN CONCURRENCE FROM THE ENGINEER THAT ADEQUATE PROJECT PROGRESS HAS BEEN ACHIEVED AND THAT ADEQUATE PREPARATIONS ARE IN PLACE PRIOR TO SWITCHING TRAFFIC. IF, IN THE OPINION OF THE ENGINEER, REQUIRED PROGRESS AND ADEQUATE PREPARATIONS ARE NOT COMPLETE, THE CONTRACTOR SHALL NOT IMPLEMENT THE NEXT PHASE, STEP, OR ELEMENT OF TRAFFIC CONTROL UNTIL INCOMPLETE CONSTRUCTION ITEMS OR PREPARATIONS ARE COMPLETED. TIME EXTENSIONS WILL NOT BE GRANTED FOR DELAYS CAUSED BY THE INCOMPLETE CONSTRUCTION ITEMS OR INADEQUATE CONTRACTOR PREPARATIONS REQUIRED TO IMPLEMENT TRAFFIC CONTROL.
6. TRAFFIC CONTROL PER THE CONTRACT IS REQUIRED FOR THE ENTIRE DURATION OF THE PROJECT, INCLUDING THE PUNCHLIST PERIOD. PAYMENT FOR TRAFFIC CONTROL THAT IS PROPERLY INSTALLED FOR LESS THAN A FULL MONTH SHALL BE BASED ON A PERCENTAGE BASIS OF THE TIME INSTALLED. TRAFFIC CONTROL PAYMENTS TO THE CONTRACTOR SHALL END 10 DAYS AFTER SUBSTANTIAL COMPLETION, ALTHOUGH PROPER TRAFFIC CONTROL MUST BE MAINTAINED UNTIL PUNCHLIST COMPLETION.
7. THE PURPOSE OF THE CONSTRUCTION SEQUENCE AND TRAFFIC HANDLING OUTLINED HEREIN IS TO DOCUMENT A VIABLE TCP THAT CAN BE UTILIZED TO CONSTRUCT THE PROJECT. IT IS THE BASIS OF ESTIMATION FOR THE TRAFFIC CONTROL BID ITEMS, AND IS TO BE UTILIZED AND IMPLEMENTED, UNLESS OTHERWISE DIRECTED BY THE ENGINEER.

 IF THE CONTRACTOR CHOOSES TO USE A DIFFERENT TCP, HE/SHE SHALL PREPARE AND SUBMIT THE ALTERNATIVE TCP TO THE COUNTY FOR APPROVAL NO LESS THAN 10 WORKING DAYS PRIOR TO THE PROPOSED IMPLEMENTATION DATE. THE TCP SHALL BE DRAWN TO SCALE AND SIGNED & SEALED BY A PROFESSIONAL ENGINEER LICENSED TO PRACTICE IN THE STATE OF TEXAS. UPON APPROVAL BY HAYS COUNTY, THE ALTERNATIVE PLAN SHALL BECOME THE BASIS FOR A "CHANGE IN CONTRACT" TO REVISE THE TRAFFIC CONTROL BID ITEMS ACCORDINGLY AND BECOME PART OF THE CONTRACT DOCUMENTS.



ENGINEERING
 8204 Westglen Drive
 Houston, Texas 77063
 713.868.0001 WWW.TLCeng.com
 F-4068

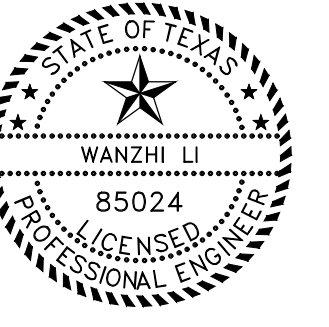

100% SUBMITTAL

CITY OF WOODCREEK
DEERFIELD DRIVE
WOODCREEK Texas, 78676

REVISION	
NO.	DATE

PROJECT #
 ISSUE:
 DATE:
 DRAWN BY:

GENERAL NOTES

C0.03

SUMMARY OF ROADWAY QUANTITIES - DEERFIELD DRIVE						
P & P SHEET NO.	STATION TO STATION		EXCAVATION (ROADWAY) (5")	HMAC SURFACE (5")	2ND HMAC SURFACE (2")	LIME TRT (SUBGRADE)
			CY	CY	CY	SY
PAVEMENT						
C3.01 - C3.02	1+00.00	6+84.22				
TOTAL			19.0270	19.9148	4.6326	1571.0220
PAVEMENT APRON						
C3.02	5+59.85	6+84.22				
TOTAL			5.0851	5.0851	2.0340	165.1974

SUMMARY OF DEMOLITION QUANTITIES										
ITEM NO.	DESC. CODE	STATION TO STATION	REMOVE STRIPING	REM STAB BASE & ASPH	REMOVE (SIGN)	REMOVE (MAILBOX)	REMOVE "BLUE" REF MARKER	REMOVE DRIVEWAY CURB	REMOVE CONC CURB BLOCKS	REMOVE WOODEN CURB
			LF	SY	EA	EA	EA	EA	LF	LF
PAVEMENT										
C2.01		1+00.00 6+84.22								
TOTAL			0	1571.0220	1	(4)= 16	1	1	120	101
PAVEMENT APRON										
C2.01		5+59.85 6+84.22								
TOTAL			0	165.1974						

SUMMARY OF TRAFFIC CONTROL QUANTITIES DEERFIELD DRIVE N&S			
ITEM NO.	DESC. CODE		
		TYPE 3 - BARRICADES	SIGNS
C7.05		EA	EA
TOTAL		3	7


SUMMARY OF SWP3 ITEMS						
SW3 PLAN SHEET	ITEM DESCRIPTION	ITEM DESCRIPTION	ITEM DESCRIPTION	ITEM DESCRIPTION	ITEM DESCRIPTION	ITEM DESCRIPTION
C7.03	TEMPORARY FILTER	REINFORCED FILTER	STABILIZED CONSTRUCTION	GRATE INLET PROTECTION	CURB INLET PROTECTION	ROCK FILTER DAM TYPE 2
	FABRIC FENCE	FABRIC FENCE	ACCESS			
UNIT	LF	LF	EA	EA	EA	EA
TOTAL	737.95	0	1	0	0	0

SUMMARY OF PAVEMENT MARKINGS ITEMS - DEERFIELD DRIVE										
ITEM NO.										
	THERMO-PLASTIC WS12 (90MIL)	THERMO-PLASTIC WS24 (90MIL)	THERMO-PLASTIC (ARROW) (90MIL)	THERMO-PLASTIC (WORD) (90MIL)	THERMO-PLASTIC YS24 (90MIL)	REFLECTIVE RAISED PAV MRKR TY II-B-B	REFLECTIVE RAISED PAV MRKR TY II-A-A	THERMO-PLASTIC WS6-R20 (60MIL)	THERMO-PLASTIC YB4 (60MIL)	THERMO-PLASTIC WS4 (60MIL)
LOCATION	LF	LF	EA	EA	LF	EA	EA	LF	LF	LF
DEERFIELD DRIVE SB Sta. 1+00.00 to Sta. 1+02		10								
DEERFIELD DRIVE CL Sta. 1+00.00 to Sta. 6+84.22				2		1	15		584.22	1168.44
PROJECT TOTALS:		10		2		1	15		584.22	1168.44

SUMMARY OF TREE PROTECTION ITEMS				
SW3 PLAN SHEET	ITEM DESCRIPTION	ITEM DESCRIPTION	ITEM DESCRIPTION	ITEM DESCRIPTION
C7.03	PLACE PROTECTIVE FENCE	REMOVE PROTECTIVE FENCE	PLACE BOUND WOOD PLANKING	REMOVE BOUND WOOD PLANKING
UNIT	LF	LF	LF	LF
TOTAL	74.00	74.00	9.86	9.86

NOTE:
CONTRACTOR TO CONTACT CITY OF WOODCREEK CITY ADMINISTRATOR, JIM BURTON MIN. 48 HOURS PRIOR TO CONSTRUCTION @ 512-847-9390

FOR PERMITTING ONLY

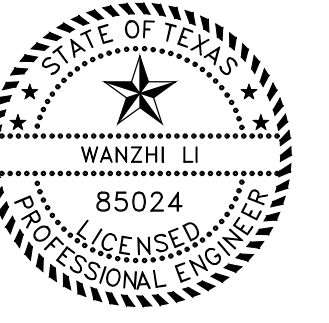

100% SUBMITTAL

CITY OF WOODCREEK
DEERFIELD DRIVE
WOODCREEK Texas, 78676



REVISION NO.	DATE

PROJECT #
ISSUE:
DATE:
DRAWN BY:


SUMMARY OF QUANTITIES

C0.04

- WM = WATER METER
- EM = ELECTRIC METER
- WV = WATER VALVE
- GV = GAS VALVE
- SP = SIGN POST
- UP = UTILITY POLE
- UG = UTILITY POLE & GUY WIRE
- LP = LIGHT POLE
- CP = CONCRETE PAVEMENT
- SS = UNDERGROUND SANITARY SEWER LINE (AS PER MARKINGS BY 811)
- WL = UNDERGROUND WATER LINE (AS PER MARKINGS BY 811)
- EA = EDGE OF ASPHALT PAVEMENT
- CC = CONCRETE CURB
- 900 = CONTOUR LINE WITH ELEVATION
- 1003 = SPOT ELEVATION
- 8" OAK = TREE TYPE AND SIZE WITH NUMBERED METAL TAG
- = CANOPY LIMITS ±
- = CENTERLINE OF APPARENT R.O.W. LINE ±
- () = RECORD OR PLAT DATA
- PR = PLAT RECORDS OF HAYS COUNTY, TEXAS.
- RRP = REAL PROPERTY RECORDS OF HAYS COUNTY, TEXAS.
- RRR = OFFICIAL PUBLIC RECORDS OF HAYS COUNTY, TEXAS.

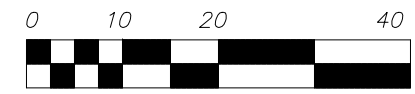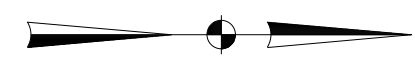

SCALE: 1" = 20'

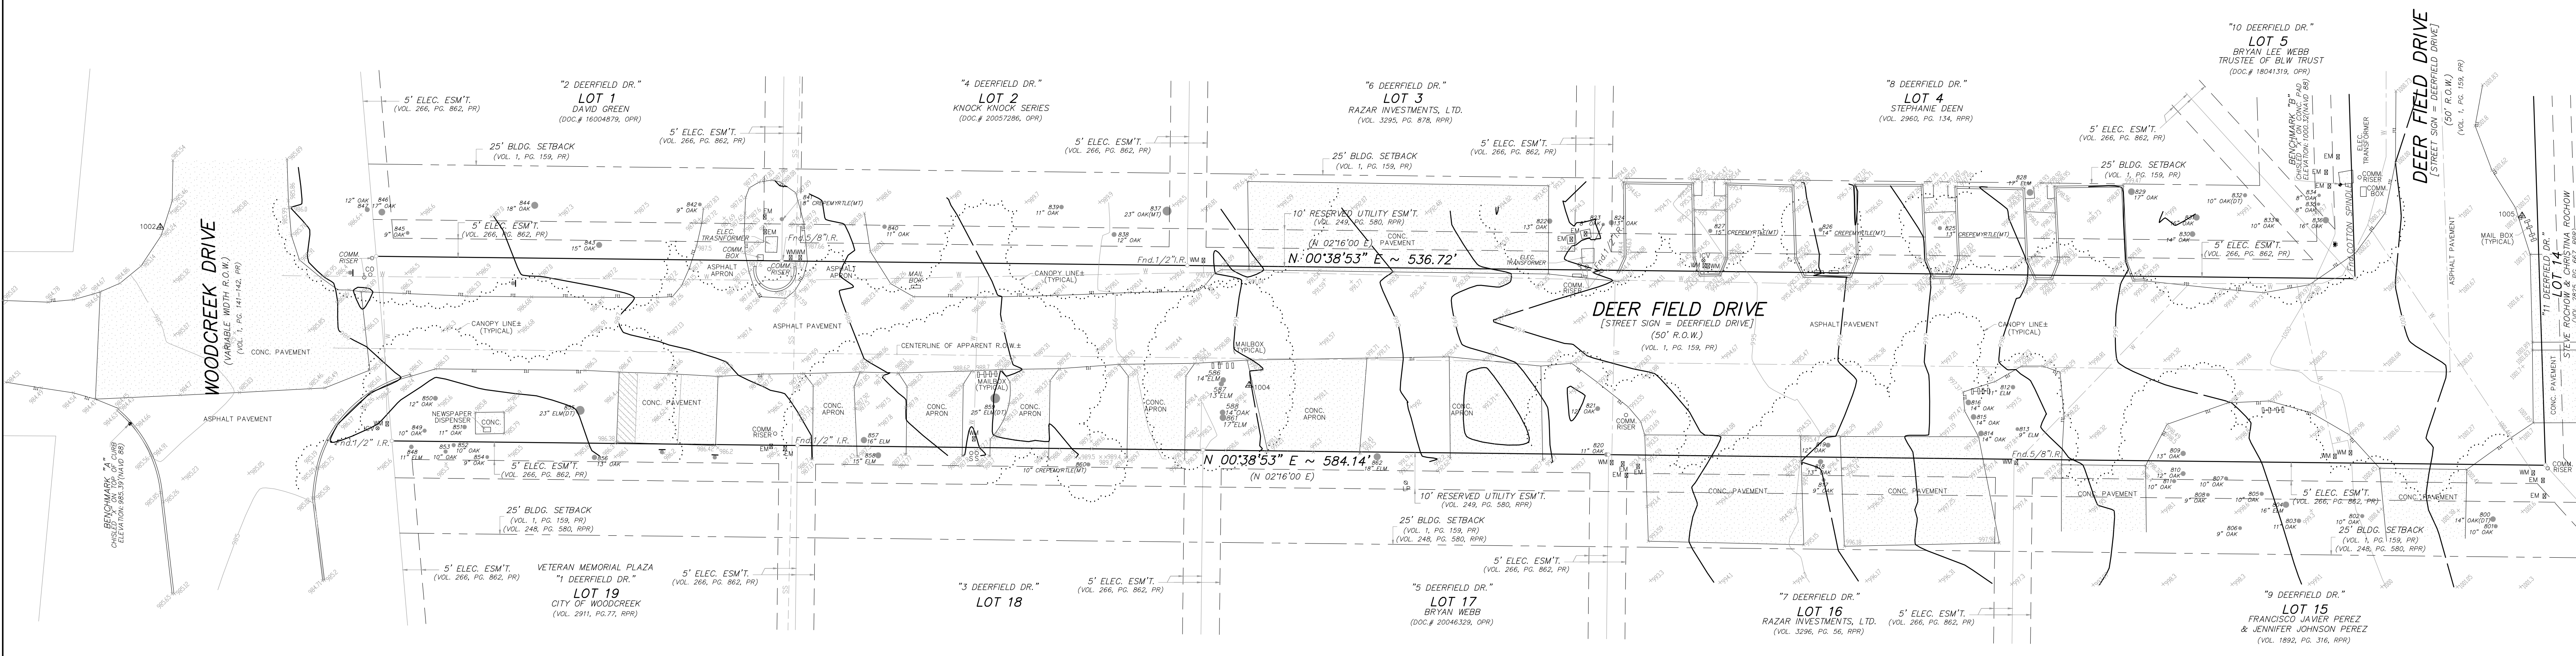

ADDRESS:
DEER FIELD DRIVE,
WOODCREEK, TEXAS

- NOTES:
1. DIRECTIONAL CONTROL LINE = D.C.L.
 2. ALL DIMENSIONS & ELEVATIONS REPRESENTED HEREON ARE IN U.S. SURVEY FEET
 3. BEARING BASIS = NAD83 TEXAS STATE PLANE COORDINATE SYSTEM, SOUTH CENTRAL ZONE 4204. SOURCE: OPUS.
 4. ELEVATIONS ARE BASED ON NAVD 88. SOURCE: GPS
 5. THIS SURVEY WAS COMPLETED WITHOUT THE BENEFIT OF A TITLE COMMITMENT. THERE MAY EXIST EASEMENTS, SETBACKS, RESTRICTIONS AND CONDITIONS THAT ARE NOT SHOWN.
 6. THE SURVEYOR MAKES NO GUARANTEE THAT THE UNDERGROUND UTILITIES SHOWN COMPRISE ALL SUCH UTILITIES IN THE AREA, EITHER IN SERVICE OR ABANDONED. THE SURVEYOR FURTHER DOES NOT WARRANT THAT THE UNDERGROUND UTILITIES SHOWN ARE IN THE EXACT LOCATION INDICATED ALTHOUGH HE DOES CERTIFY THAT THEY ARE LOCATED AS ACCURATELY AS POSSIBLE FROM INFORMATION AVAILABLE. THE SURVEYOR HAS NOT PHYSICALLY LOCATED THE UNDERGROUND UTILITIES. UNDERGROUND UTILITIES SHOWN ARE BASED ON THE LOCATION OF ABOVE GROUND PHYSICAL EVIDENCE, AVAILABLE MAPS AND/OR MARKS MADE BY RESPONDENTS OF THE TEXAS811 UTILITY LOCATE SERVICE, TEXAS 811 LOCATE REQUEST MADE JULY 29, 2024, TICKET# 2470706135.
 7. NO UNDERGROUND MARKINGS OBSERVED FOR ELECTRIC, TELEPHONE OR CABLE TV.
 8. SANITARY SEWER DEPTH NOT DETERMINED.
 9. SUBJECT TO A EASEMENT 10 FEET IN WIDTH CENTERED ON THE INSTALLED WATER PIPE PER VOL. 210, PG. 128 HAYS COUNTY REAL PROPERTY RECORDS.

PLAT REFERENCE: PLAT RECORDS (PR)
WOODCREEK, SECTION 4-A, B, C & D
VOL. 1 PAGE 159-160 DATE APRIL 3, 1972

△ CONTROL POINT TABLE

PT NO.	NORTHING	EASTING	ELEVATION (NAVD 88)	DESCRIPTION
BM"A"	13923586.9953	2252901.4720	985.39	CHISLED BOX ON CONC. CURB
BM"B"	13924186.4896	2252836.6376	1000.32	CHISLED "X" ON CONC. PAD
1002	13923595.2033	2252848.1757	985.37	SET 1/2" IRON ROD W/TRAV. CAP
1004	13923890.5521	2252891.0604	990.72	SET 1/2" IRON ROD W/TRAV. CAP
1005	13924235.7696	2252845.1127	1001.67	SET 1/2" IRON ROD W/TRAV. CAP

COORDINATES ARE NAD83 TEXAS STATE PLANE COORDINATE SYSTEM SOUTH CENTRAL ZONE 4204 ADJUSTED TO GROUND USING A SCALE FACTOR OF 1.0001070247 FROM (0,0).

NO.	DATE	BY	REVISION	CKD.	APPD.

Maverick Land Surveying Co.
1856 Lockhill-Seimo, Suite 105
San Antonio, Texas 78213
PH. 210-342-9455
FAX 210-342-9524
©1990-2024, Maverick Land Surveying Co.
TBBSS FIRM No. 10132700


IMPROVEMENTS, TREE AND TOPOGRAPHIC SURVEY OF:
**A PORTION OF DEER FIELD DRIVE
WOODCREEK, SECTION 4
A, B, C & D**
CITY OF WOODCREEK, HAYS COUNTY, TEXAS

DRAWN BY: J.S. FIELD BY: J.R. APPROVED BY: JMO
SCALE: 1" = 20' DATE: 7-30-2024 SHEET 1 OF 1
SHEET SIZE 24"x36" JOB NO. 59278-0001




ENGINEERING

8204 Westglenn Drive
Houston, Texas 77063
713.868.0001 WWW.TLCeng.com
E-4066

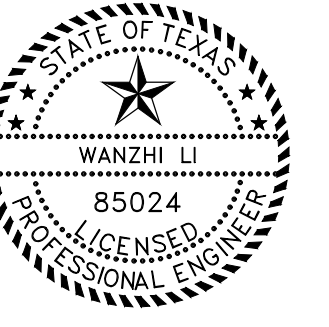

100% SUBMITTAL


CITY OF WOODCREEK
DEERFIELD DRIVE
WOODCREEK Texas, 78676

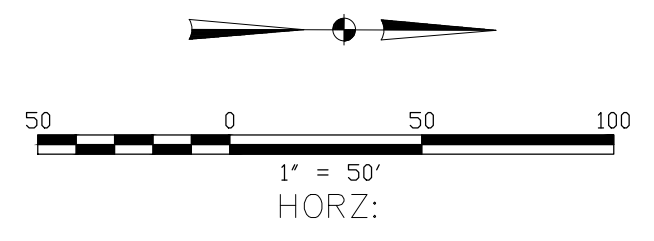

NOTES:

1. DEMOLITION TO COMPLY WITH CITY STANDARDS SHOWN ON SHEET NO. 93 TO 98.
2. FOR TREE RESTORATION: (REFER TO THE TREE ANALYSIS AND PRESERVATION) SHEET NO.

EXTENDING THIS TO LIMITS OF CULVERT INSTALLATION TO INCLUDE NEW PAVING OVER NEW CULVERT

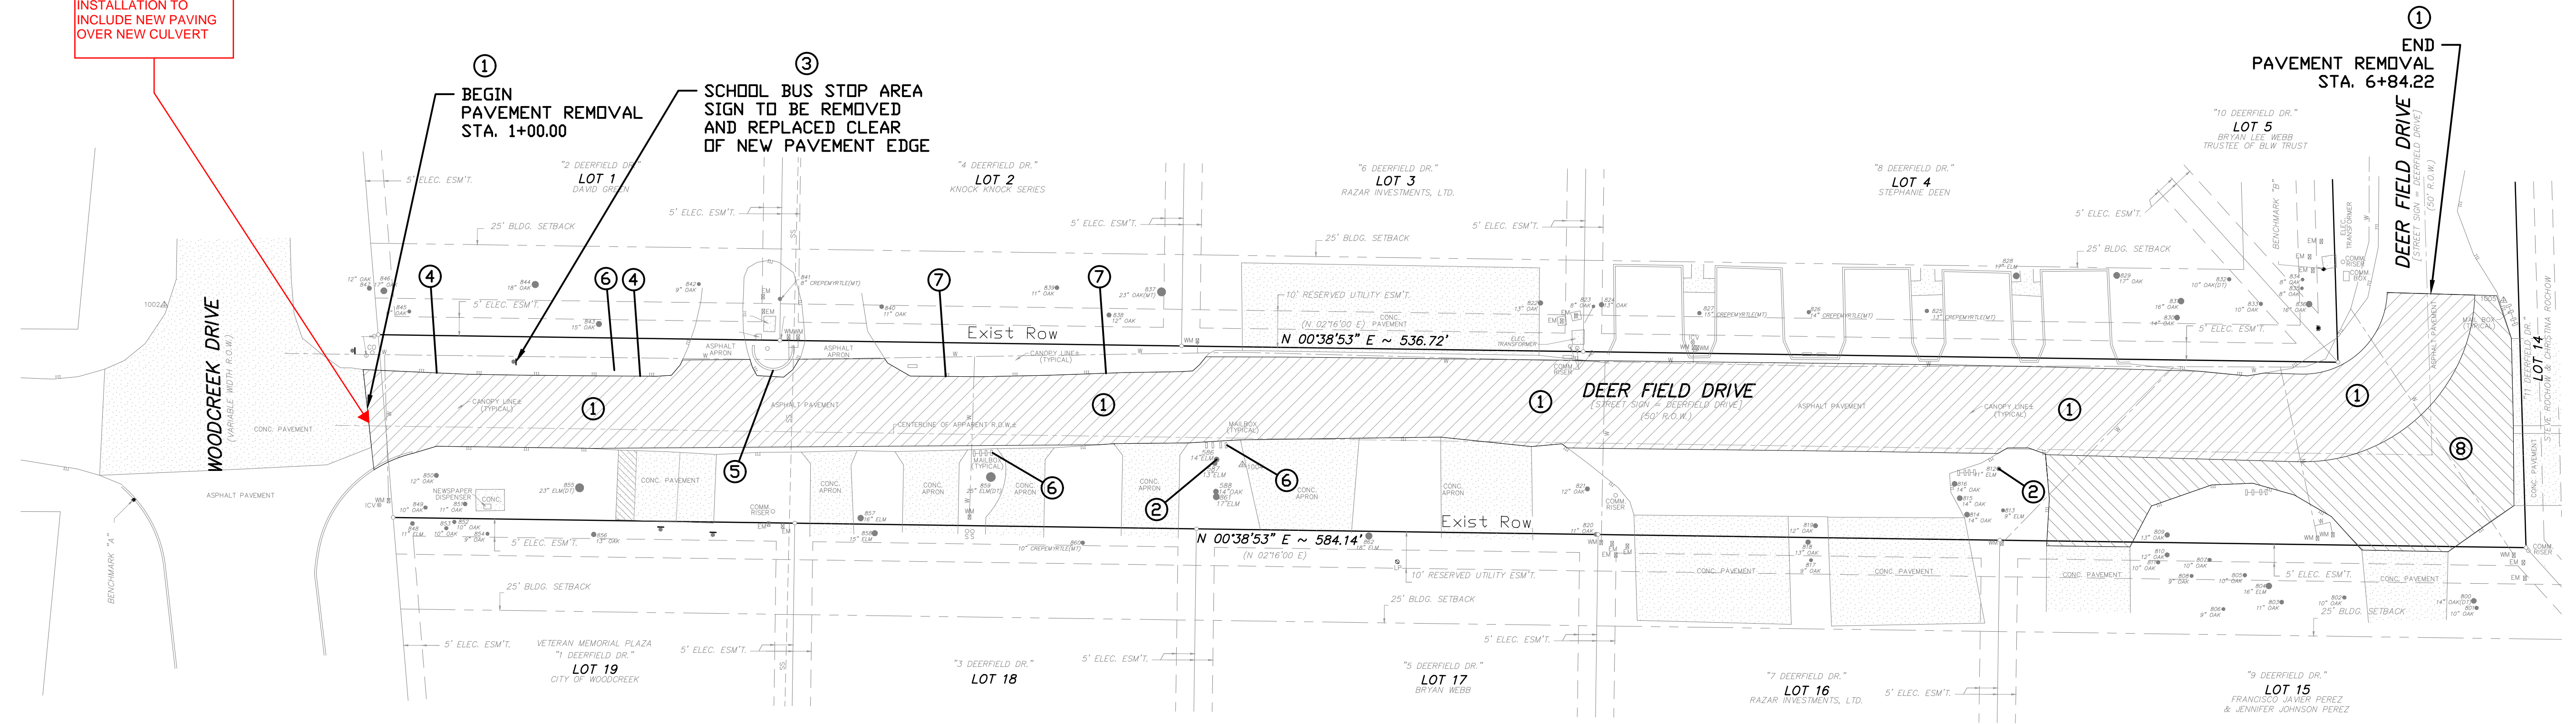

LEGEND

- ① REMOVE EXIST. PAVING
- ② TREES TO BE PRESERVED SEE TREE PROTECTION SHT. NO. C7.06
- ③ SCHOOL BUS STOP AREA SIGN TO BE REMOVED AND RELOCATED
- ④ REMOVE WOODEN LOGS CURB
- ⑤ REMOVE MEDIAN CONCRETE CURB
- ⑥ REMOVE AND REPLACE MAIL BOXES CLEAR OF NEW PAVEMENT EDGE
- ⑦ REMOVE CONCRETE BLOCKS CURB
- ⑧ REMOVE EXIST. ASPHALT APRON

REVISION NO.	DATE

PROJECT #
ISSUE:
DATE:
DRAWN BY:



DEMOLITION SHEET

C2.01


PATH: Z:\2022 Open Projects\Woodcreek, Tx Engineering Project TDA\CADD\100% Submittal\DEERFIELD DRIVE _Construct Road_Plan and Profile.dwg
 USER: Dec 31, 2024 - 3:17pm jsmart
 PLOT TAB: SHT 1 OF 2

RECOMMEND MOVING THIS SOUTH SO THAT CULVERT IS MORE PARALLEL WITH WOODCREEK AND FURTHER FROM COMM BOXES ON CORNER

PROJECT SHOULD START SOUTH OF NEW CULVERT INSTALLATION

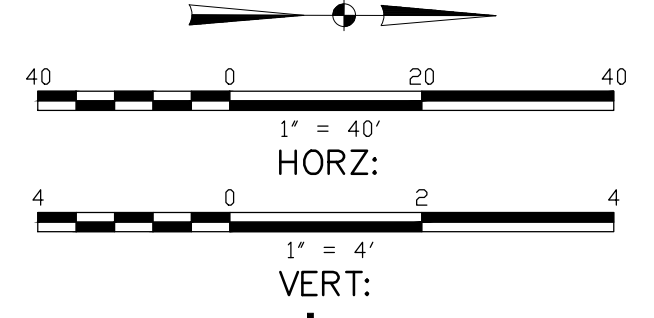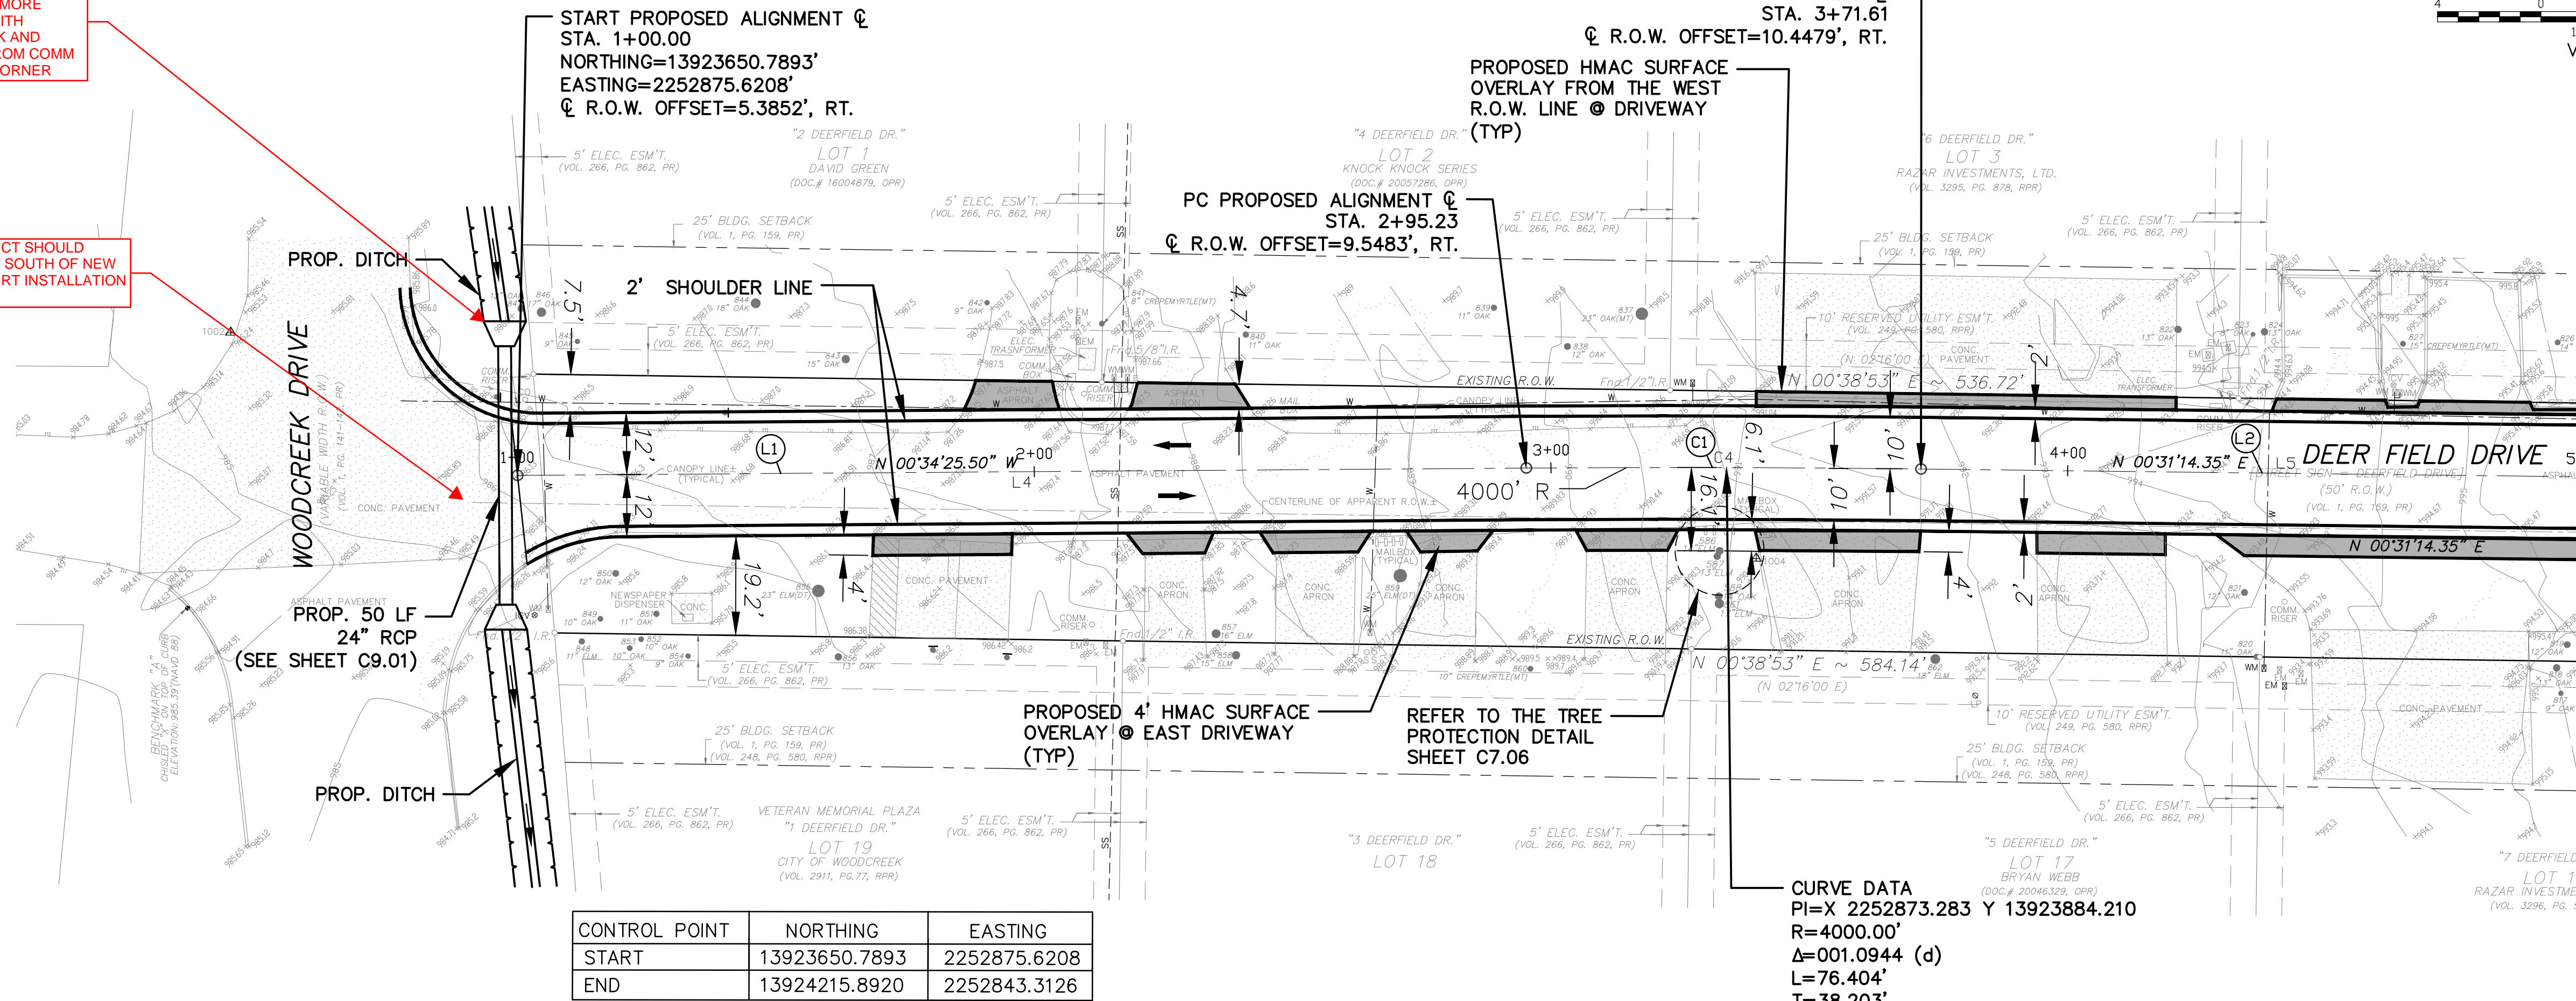


MATCH LINE STA. 5+00.00
 (SEE SHEET C3.02 2 OF 2)

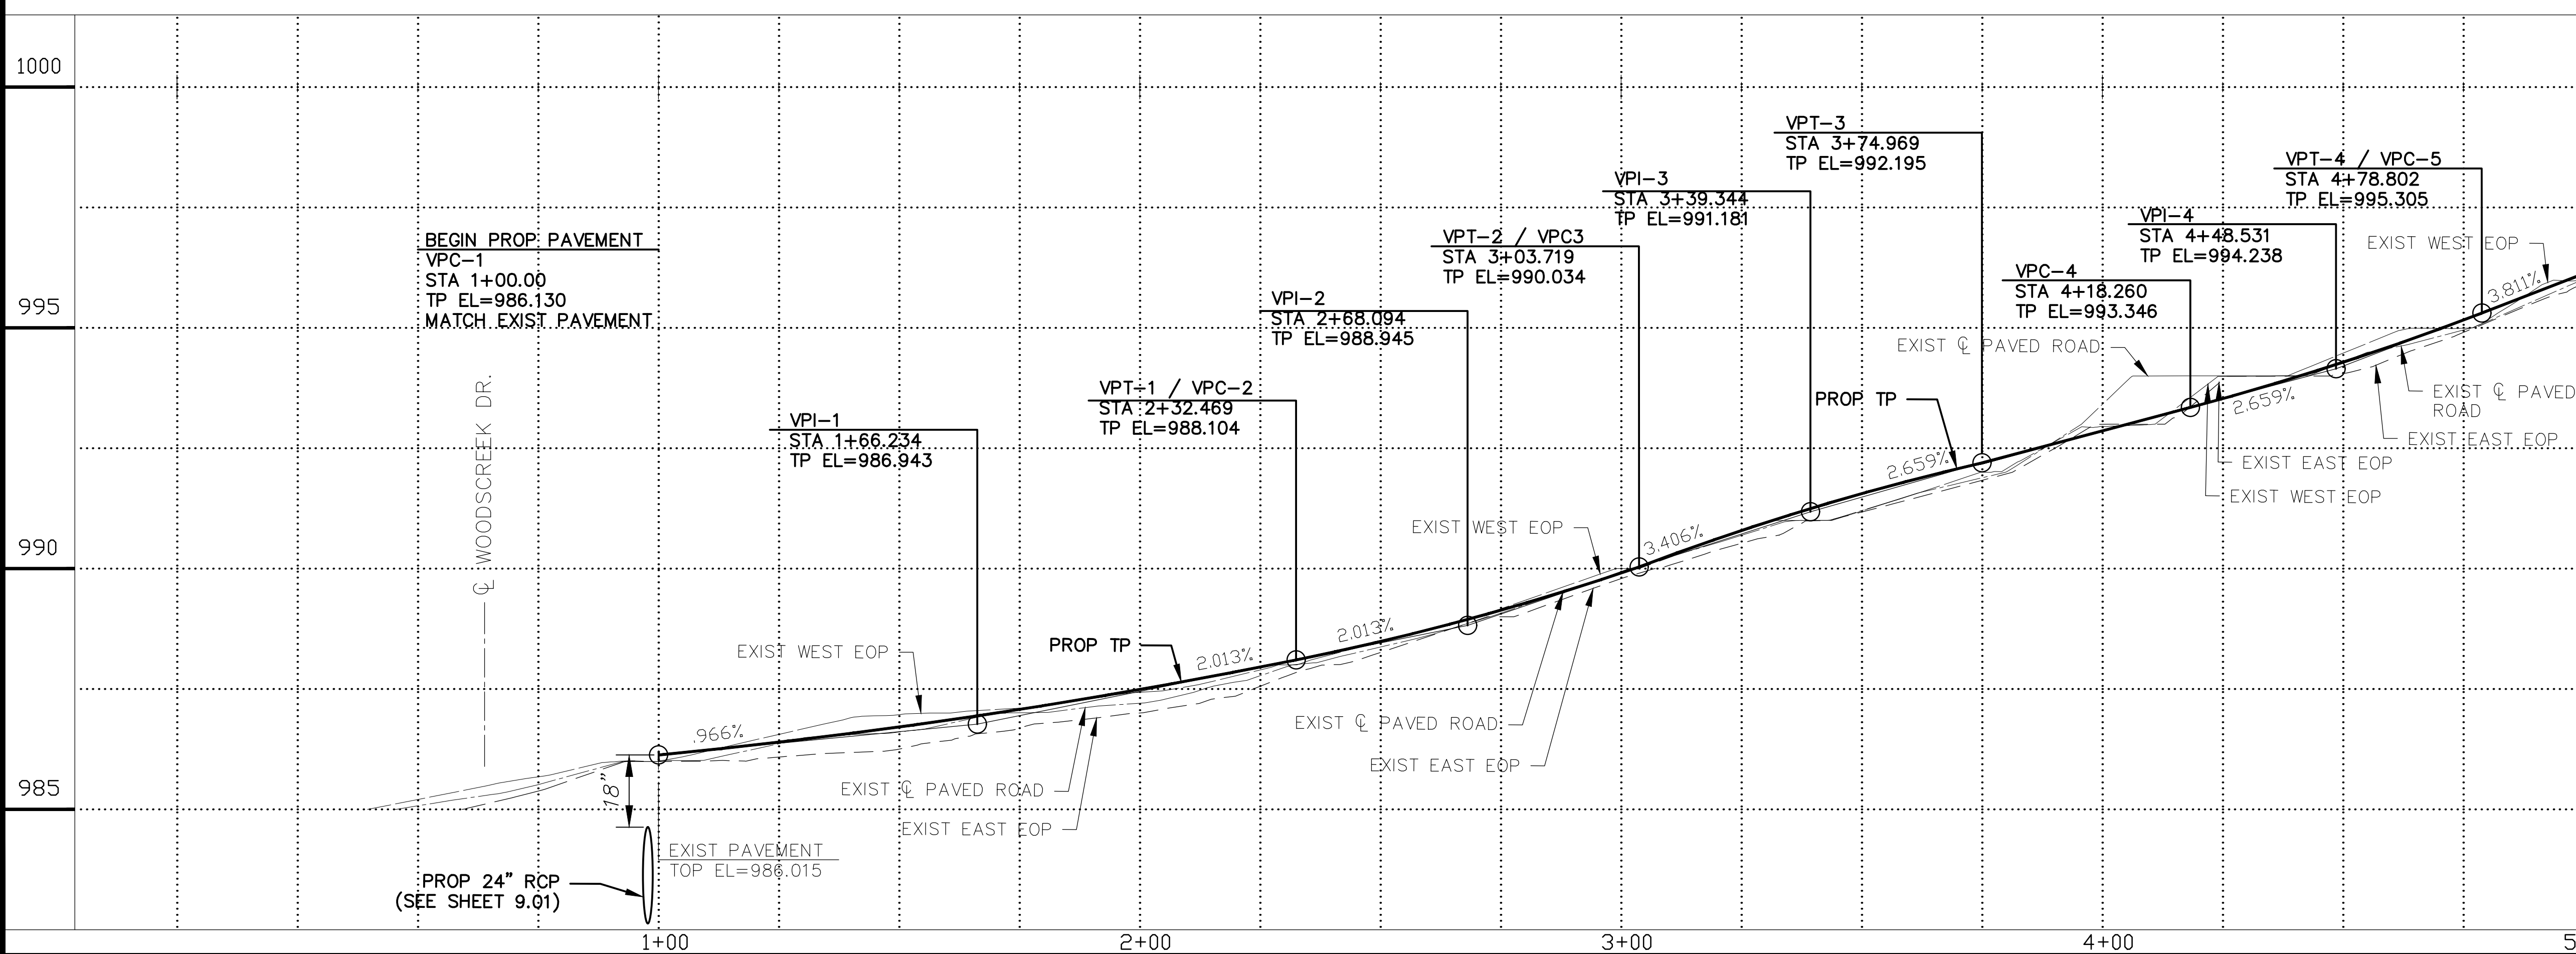

MATCH LINE STA. 5+00.00



ENGINEERING
 8204 Westglen Drive
 Houston, Texas 77063
 713.868.0001 WWW.TLCeng.com
 F-4066

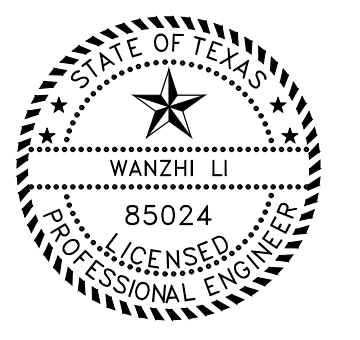

100% SUBMITTAL

CITY OF WOODCREEK
DEERFIELD DRIVE
WOODCREEK Texas, 78676



REVISION NO.	DATE

PROJECT #
 ISSUE:
 DATE:
 DRAWN BY:


PLAN AND PROFILE

C3.01
 1 OF 2

PATH: Z:\2022 Open Projects\Woodcreek, Tx Engineering Project TDA\CADD\100% Submittal\DEERFIELD DRIVE_Construct Road_Plan and Profile.dwg
 USER: Dec 31, 2024 - 10:49am jsmart
 PLOT TAB: SHT 2 OF 2

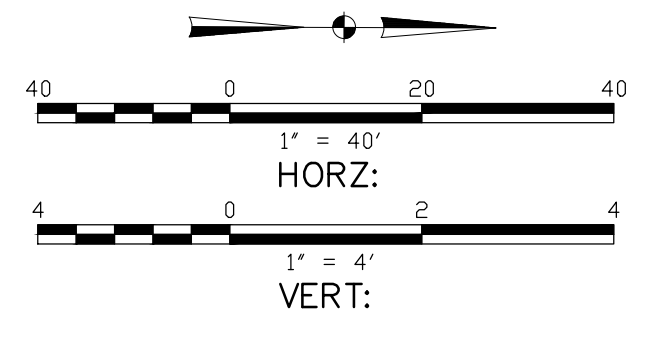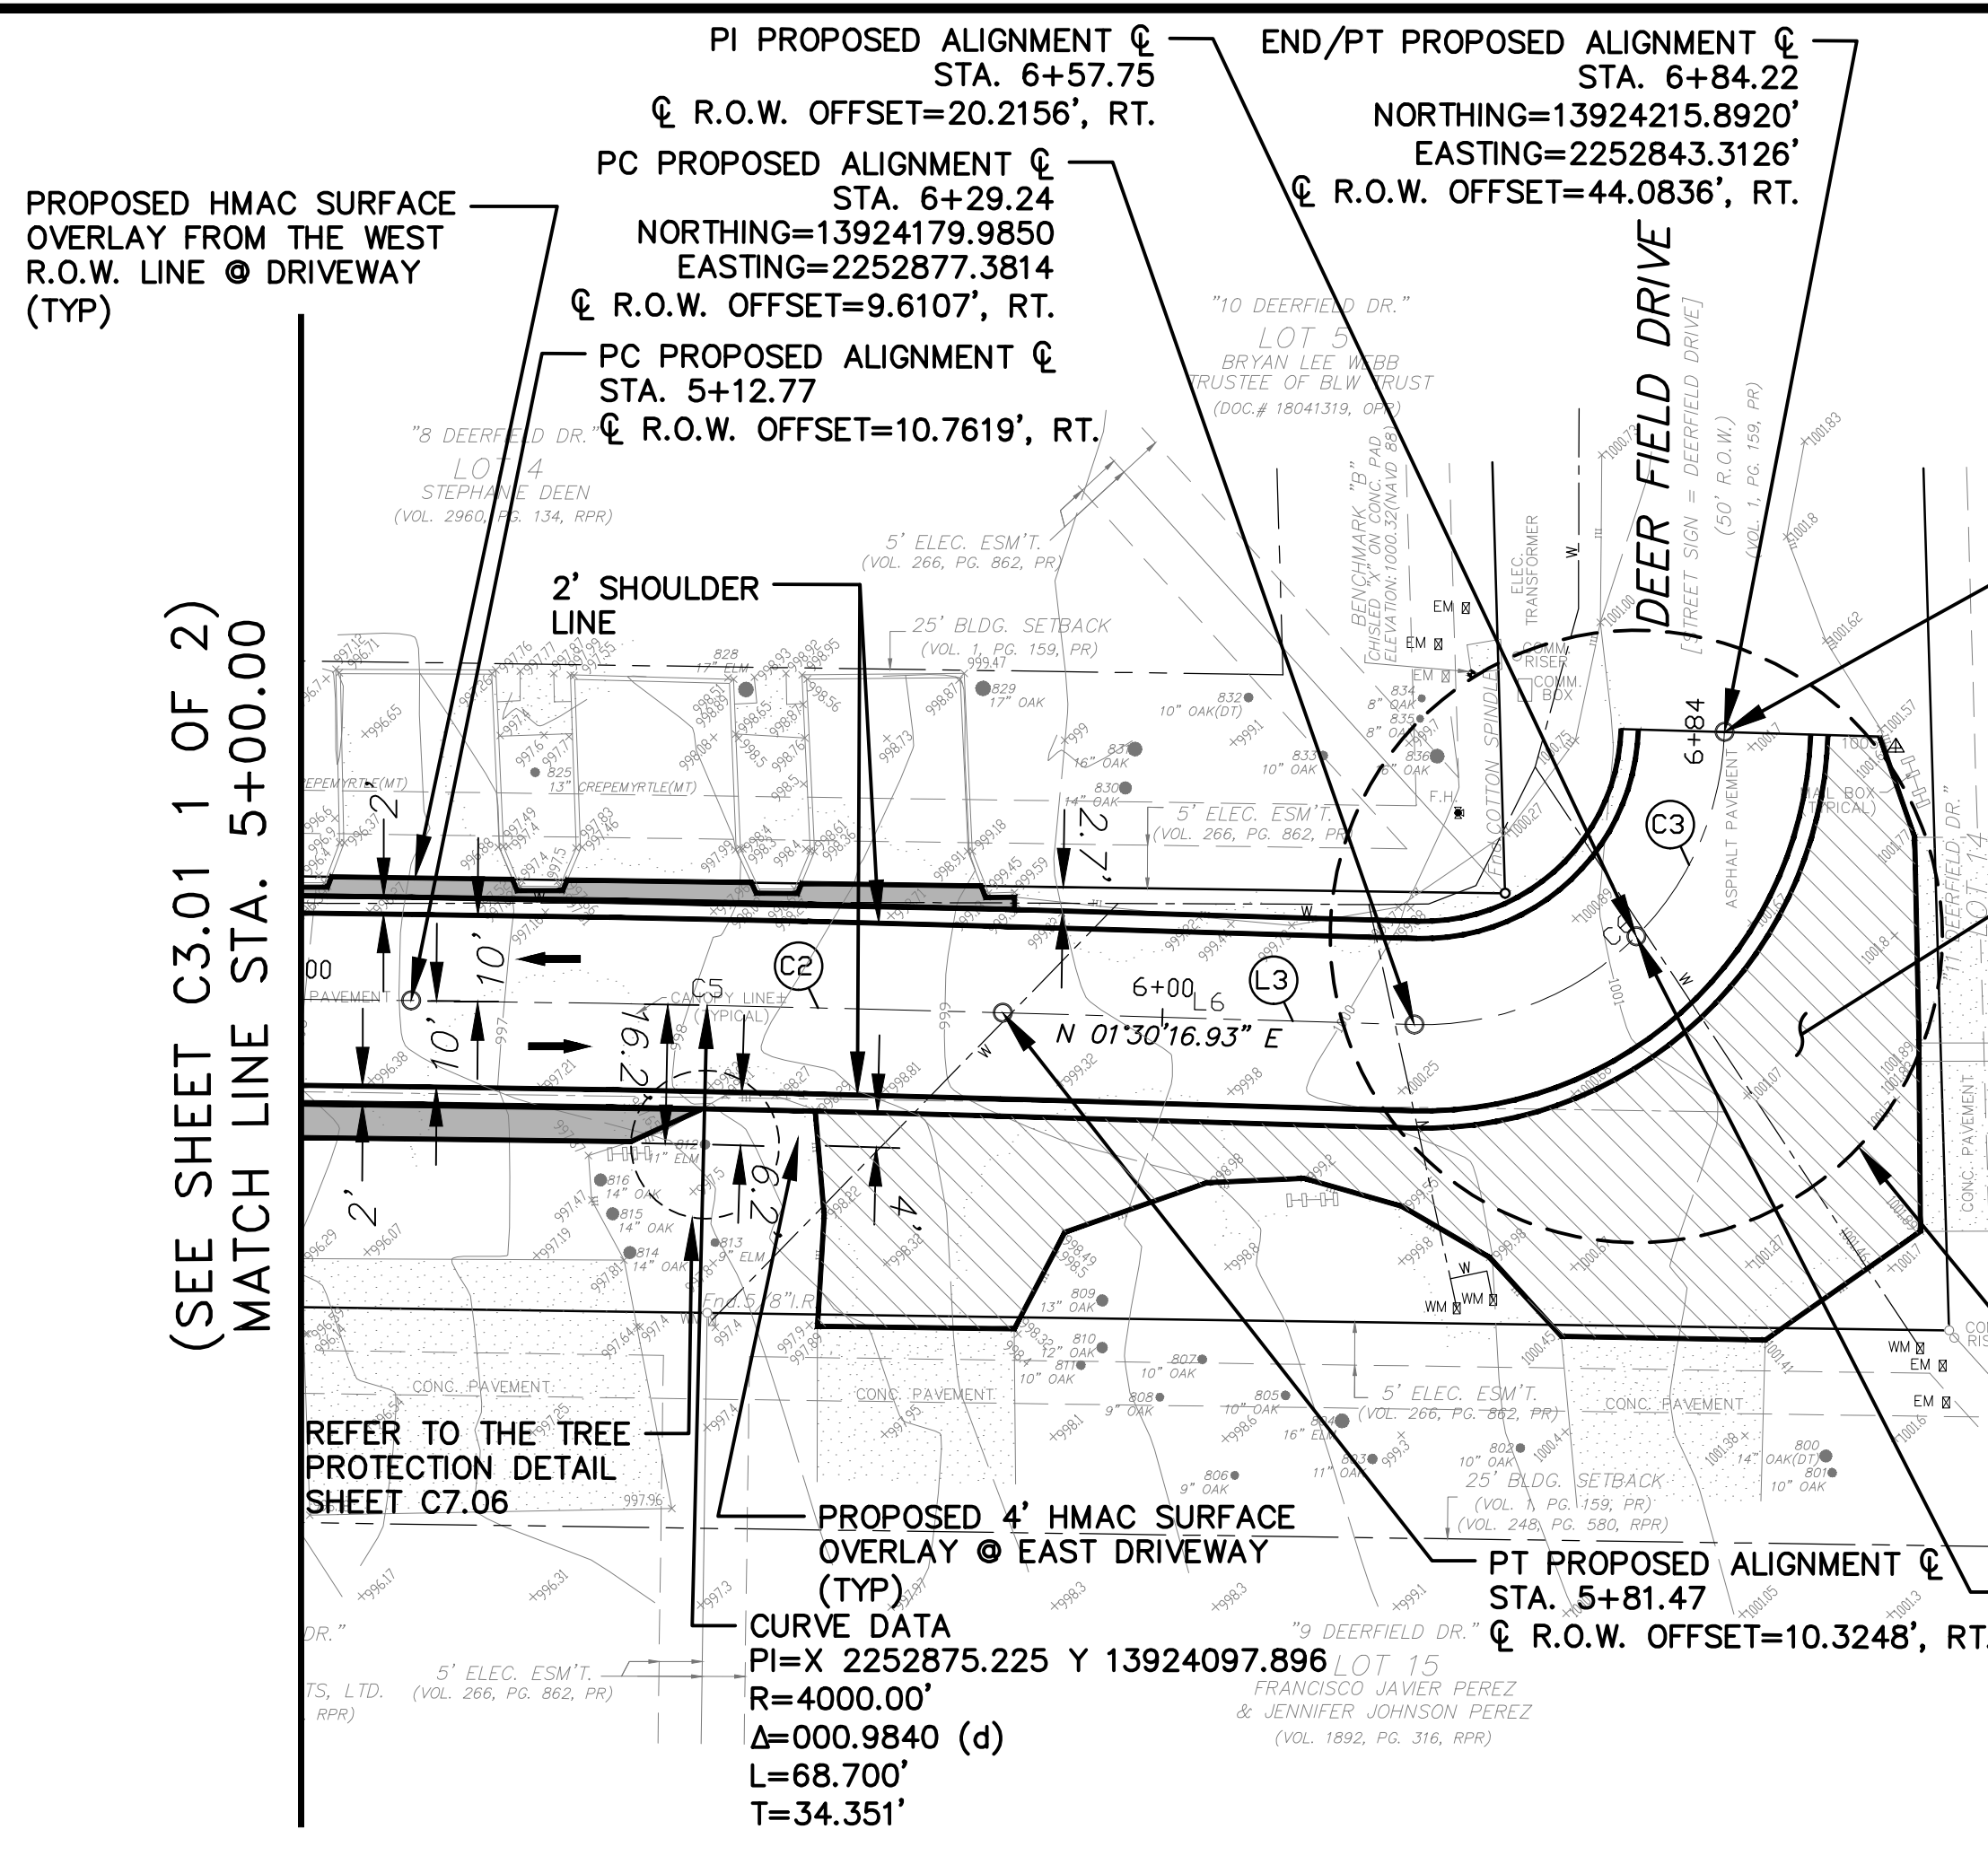


ENGINEERING
 8204 Westglen Drive
 Houston, Texas 77063
 713.868.0001 WWW.TLCeng.com
 F-4066

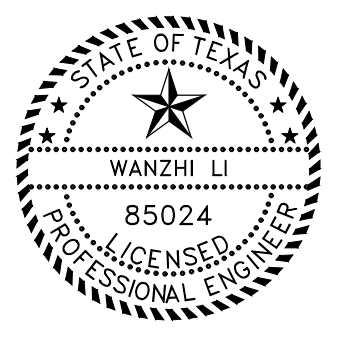

100% SUBMITTAL

CITY OF WOODCREEK
DEERFIELD DRIVE
WOODCREEK Texas, 78676

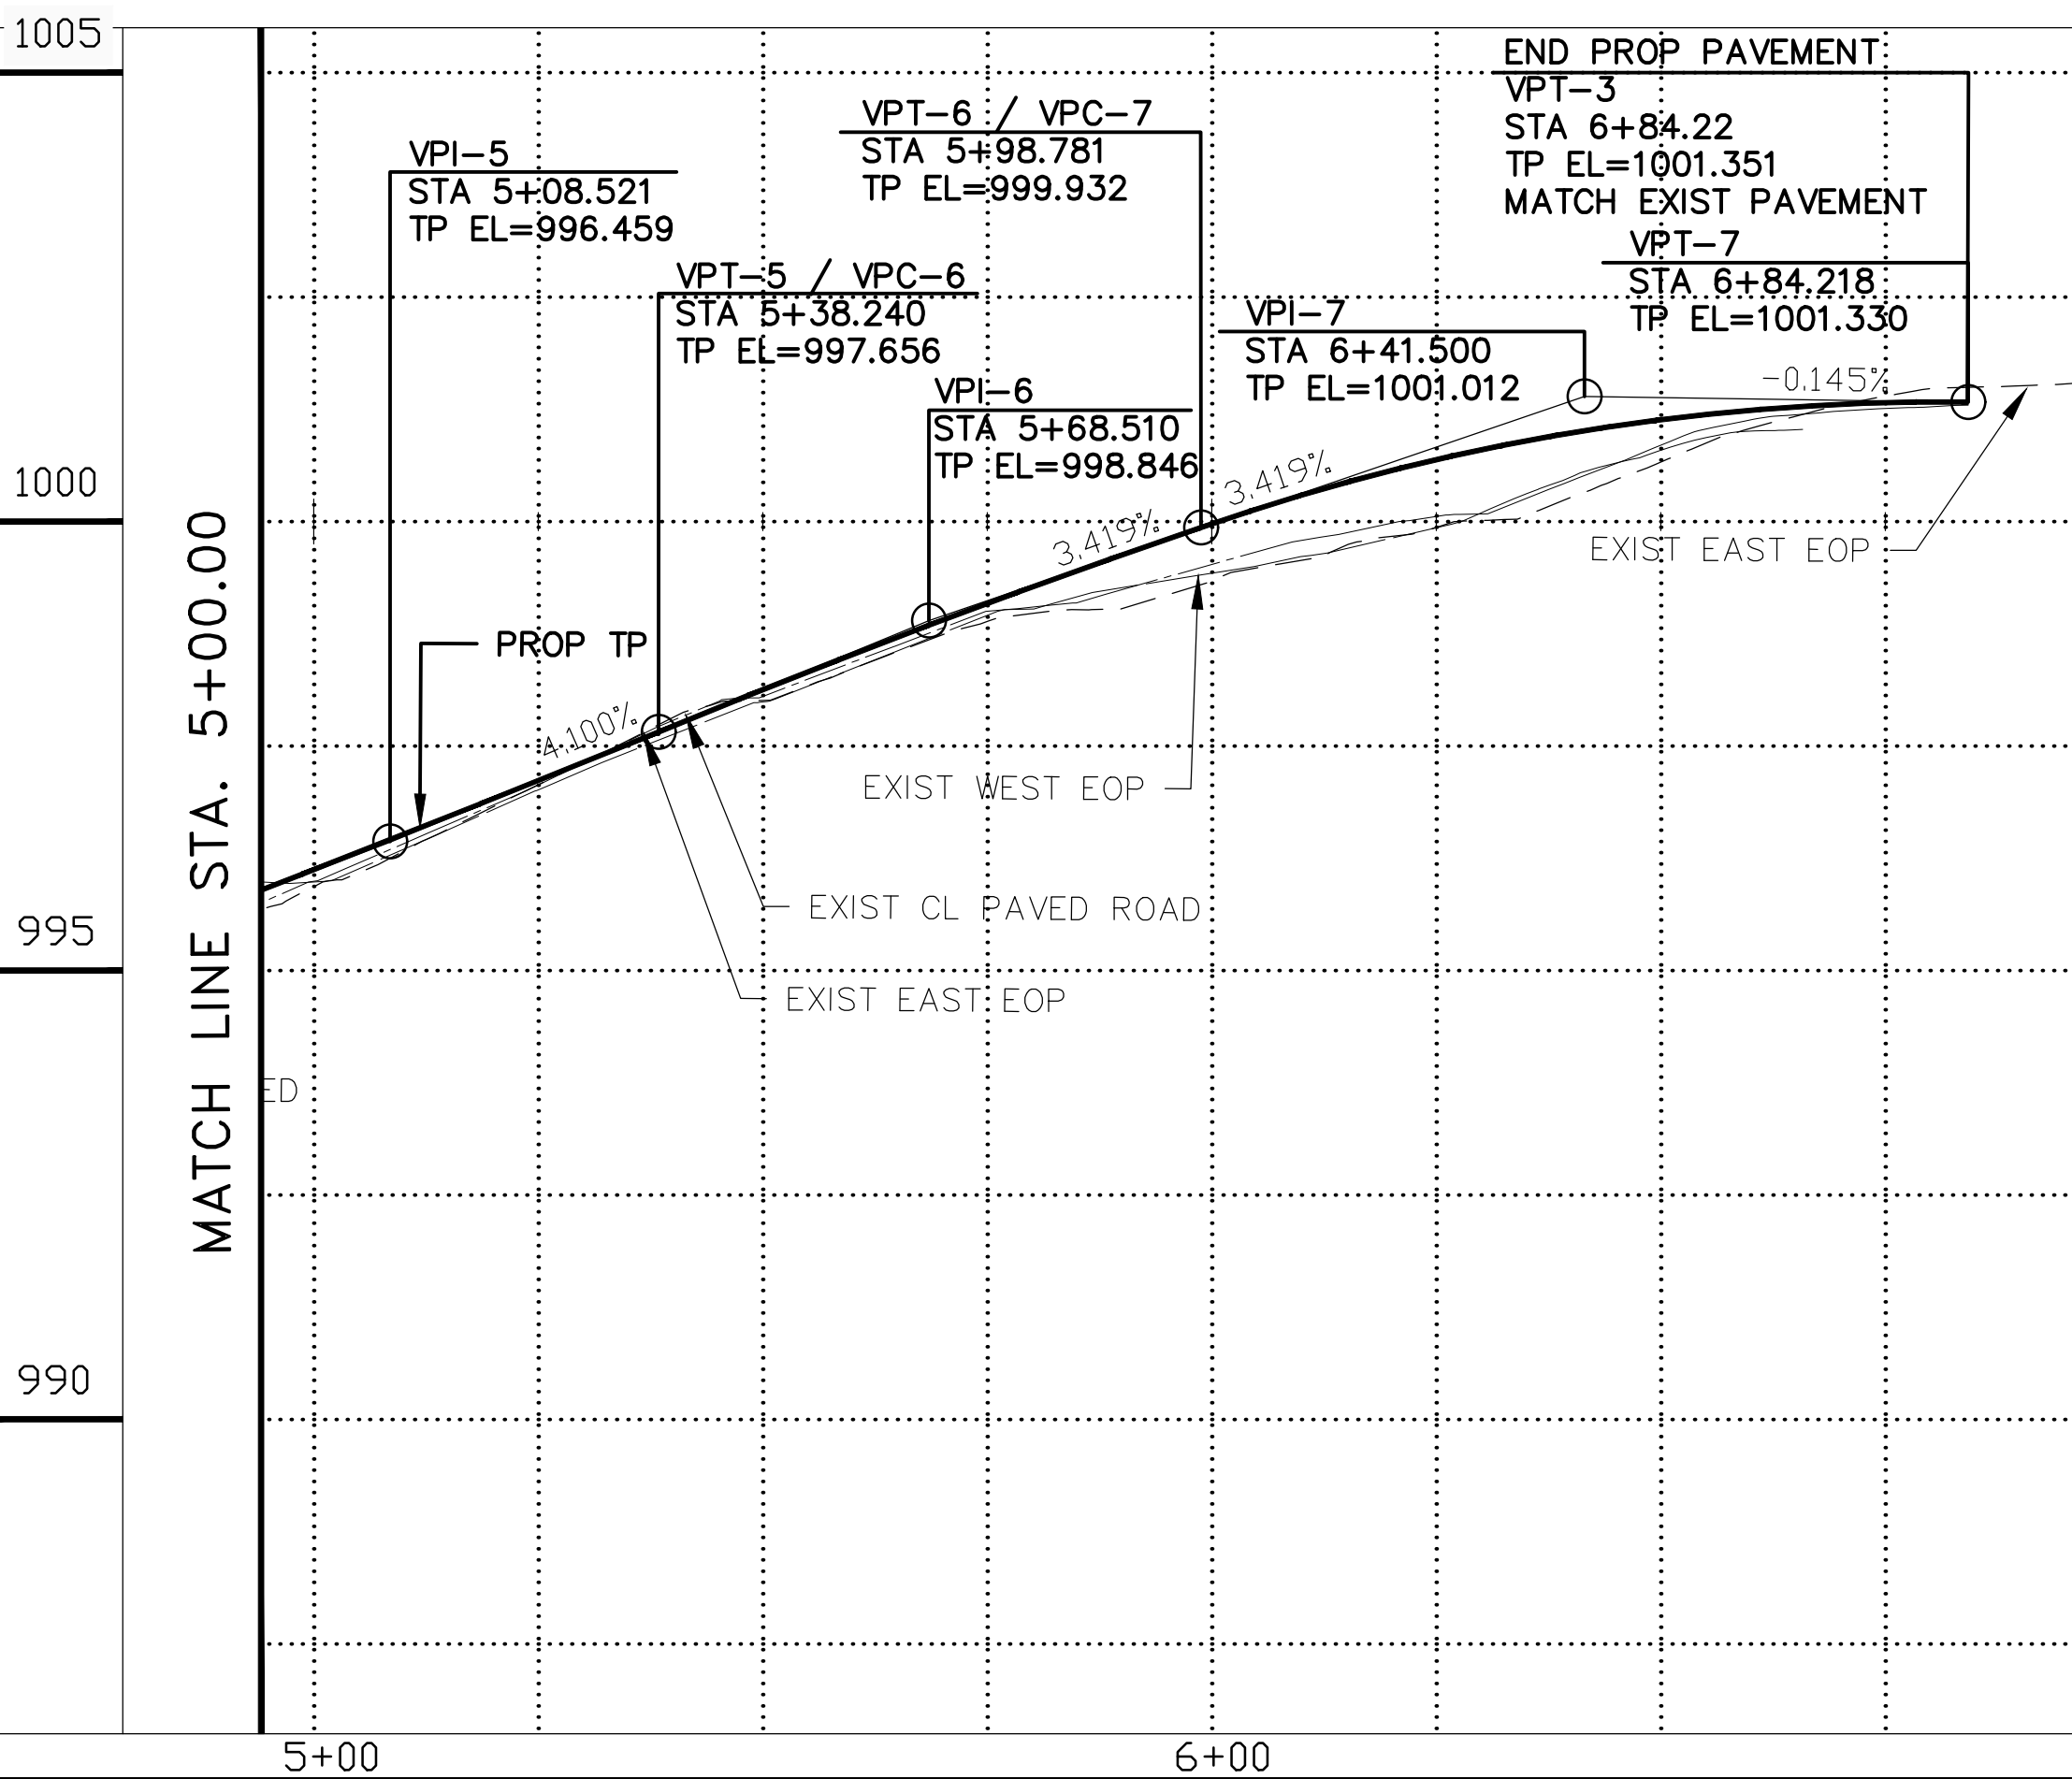

A-1 Curve Fitting 100 to 268
Left Edge-1 OF Woodcreek

Curve-A	PI	PC	PT	Ex=	K=
Sta=	184.047	100.000	268.094	-0.187	189
Ele=	987.393	986.181	988.980	L=	168.094
BENDING		1.220%	2.110%	PI Peak	987.580

C-1 Fitting 421 TO 586- Straight Line
Left Edge-1 OF Woodcreek

Curve-C	PI	PC	PT	Ex=	K=
Sta=	494.755	421.000	568.510	0.000	N/A
Ele=	996.274	993.575	998.973	L=	147.510
BENDING		3.660%	3.660%	PI Peak	996.274

B-1 Curve Fitting 268 to 421
Left Edge-1 OF Woodcreek

Curve-B	PI	PC	PT	Ex=	K=
Sta=	344.547	268.094	421.000	-0.250	117
Ele=	991.027	988.980	993.575	L=	152.91
BENDING		2.350%	3.660%	PI Peak	990.776

D-1 Fitting 586 to 684
Left Edge-1 OF Woodcreek

Curve-D	PI	PC	PT	Ex=	K=
Sta=	626.364	568.510	684.218	0.464	36.046
Ele=	1000.627	998.973	1001.351	L=	115.708
BENDING		3.660%	0.450%	PI Peak	1001.091

PROFILE CURVE FITTING

REVISION


NO.	DATE

PROJECT #
 ISSUE:
 DATE:
 DRAWN BY:


PLAN AND PROFILE

C3.02
 2 OF 2

PATH: Z:\2022 Open Projects\Woodcreek, Tx Engineering Project TDA\CADD\100% Submittal\DEERFIELD DRIVE _Construct Road_Plan and Profile.dwg
 USER: Dec 30, 2024 - 12:12pm jsmart
 PLOT TAB: Detail

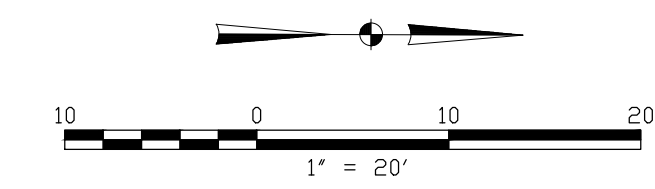


ENGINEERING
 8204 Westglen Drive
 Houston, Texas 77063
 713.868.0001 WWW.TLCeng.com
 F-4066

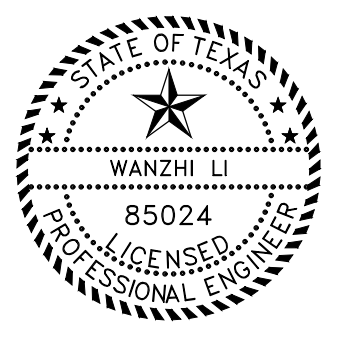

100% SUBMITTAL

CITY OF WOODCREEK
DEERFIELD DRIVE
WOODCREEK Texas, 78676

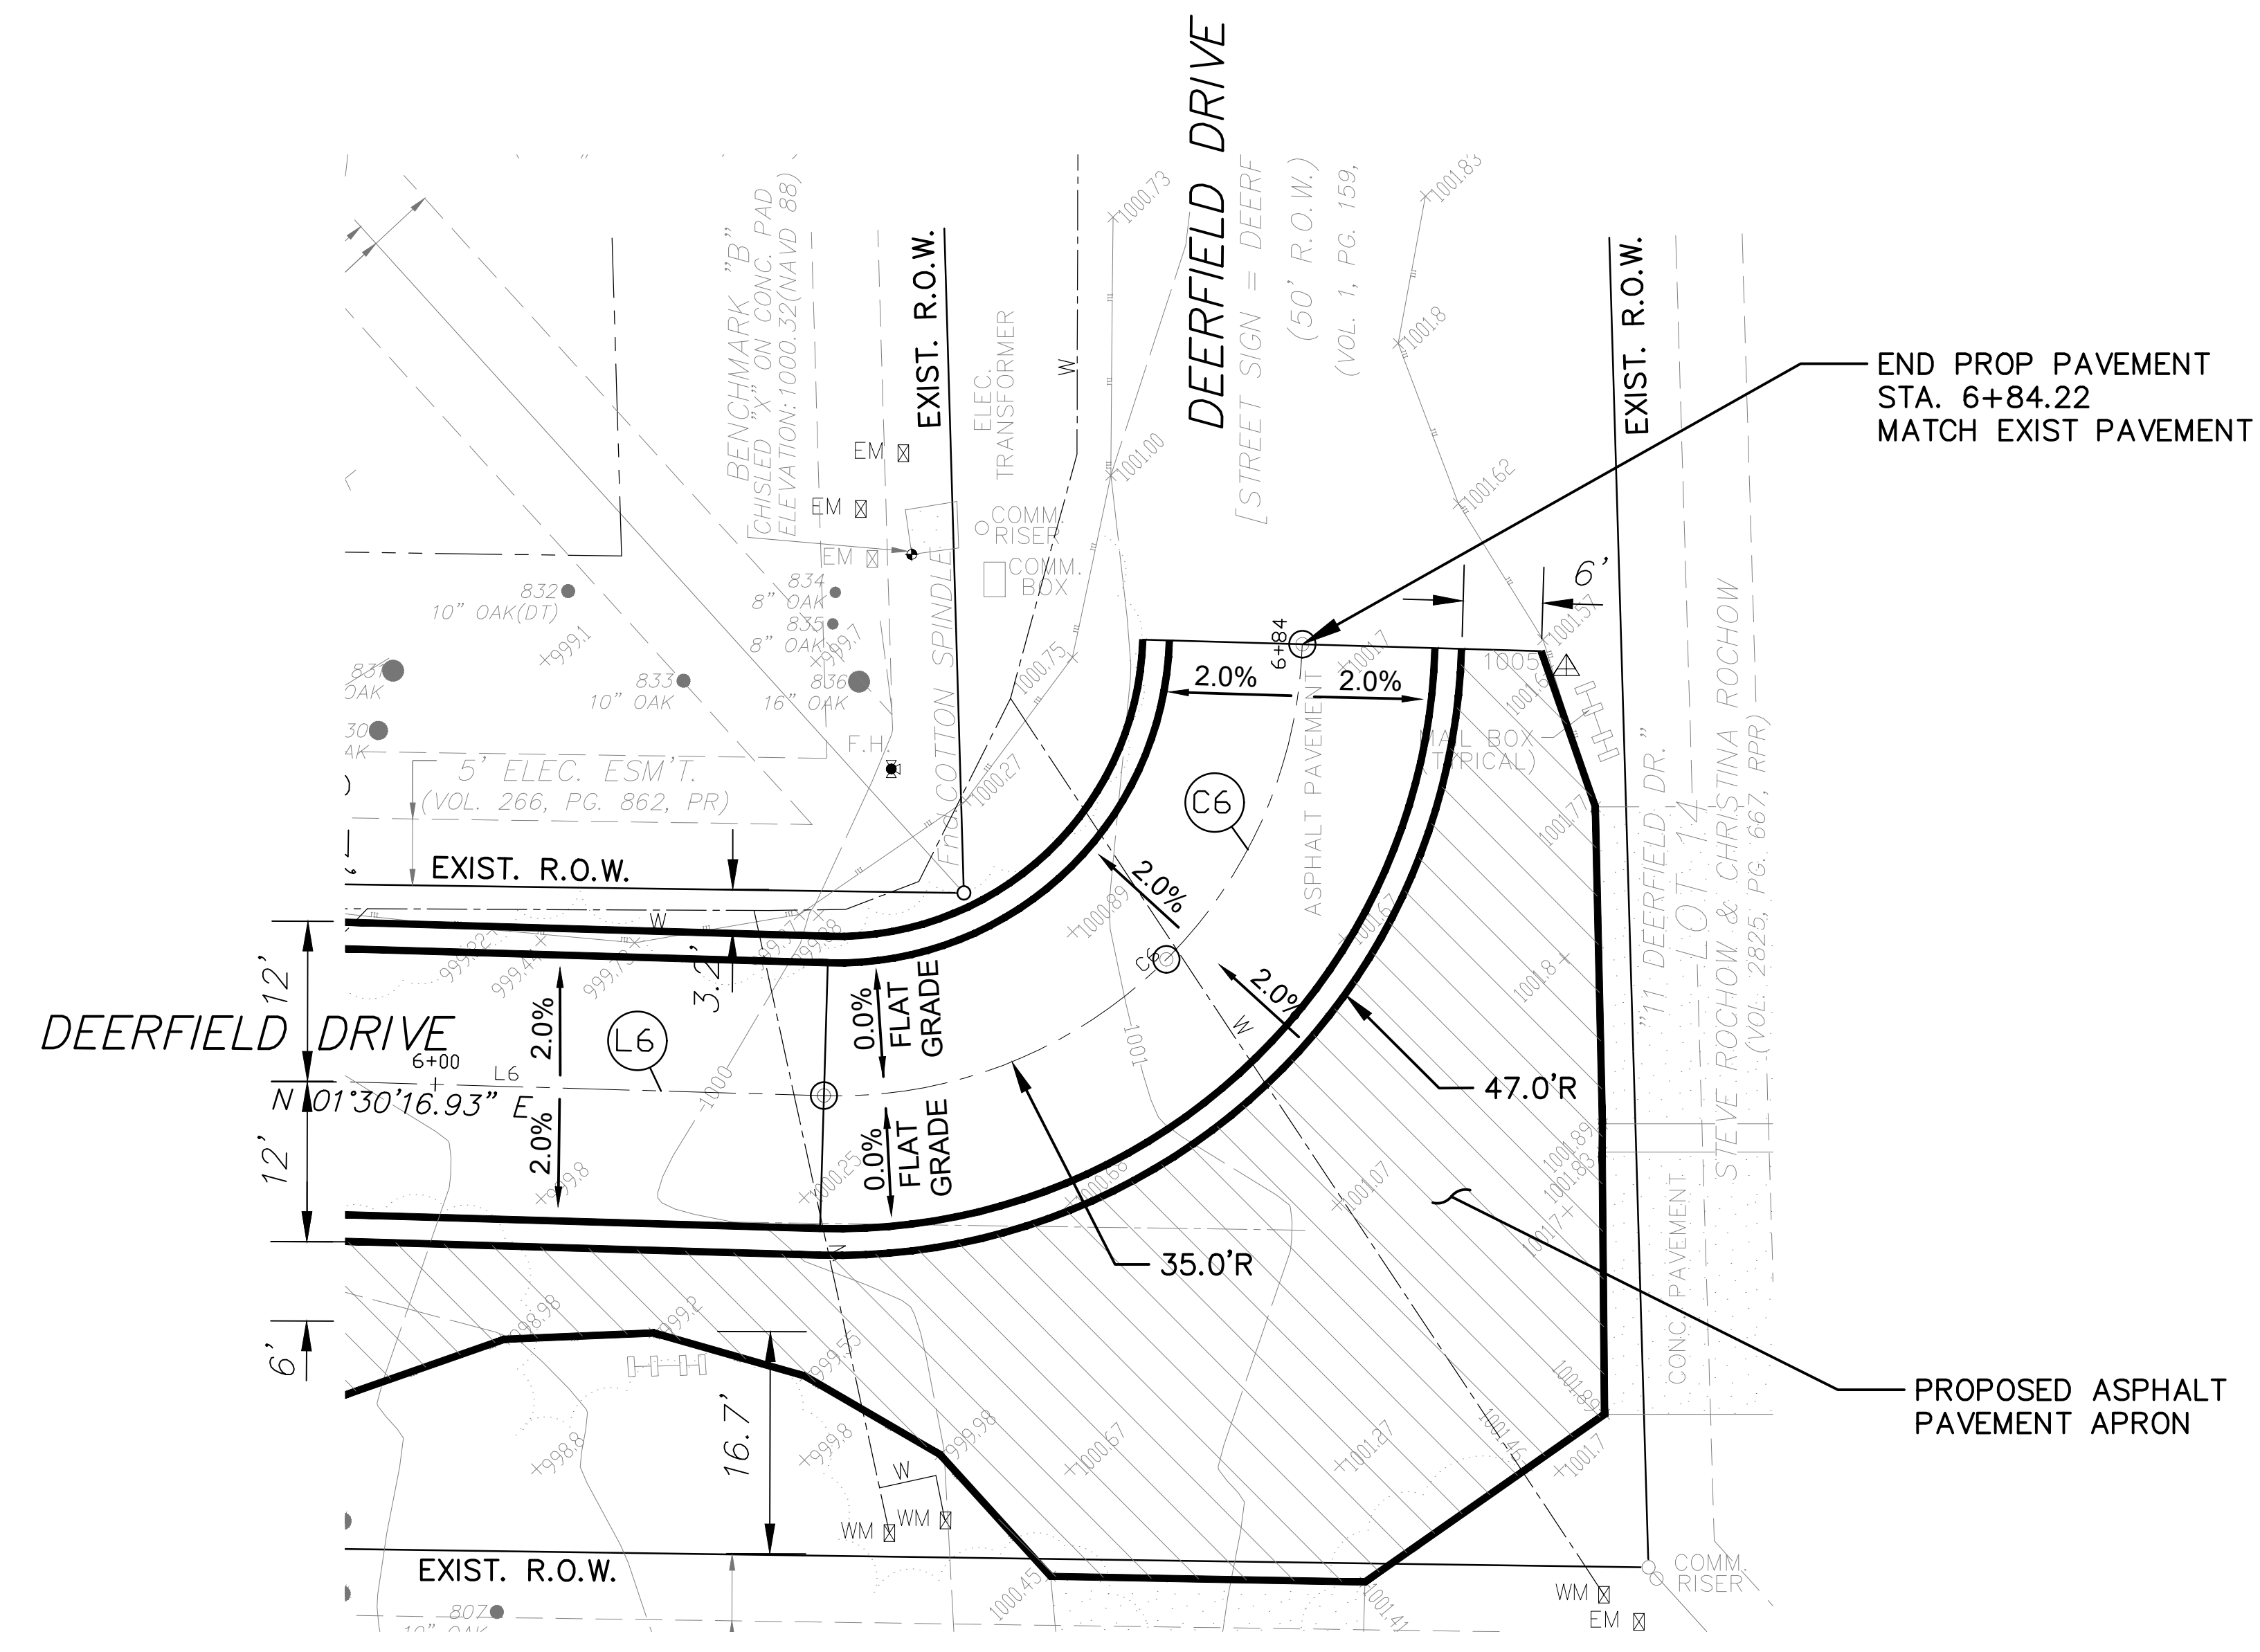

END PROP PAVEMENT
 STA. 6+84.22
 MATCH EXIST PAVEMENT

PROPOSED ASPHALT
 PAVEMENT APRON

DETAIL "A"
 N.T.S.

Finalized Control Points for Lines and Curves

Line#	Length	Start-North	End-East	Start-North	End-North
L1	195.2262	13923650.7893	2252875.6208	13923846.0057	2252873.6658
Bearing//Station	0	-34.0000	-25.571	100.0000	295.22616
L2	141.1420	13923922.4109	2252873.6304	13924063.5471	2252874.9130
Bearing//Station	0	31.0000	14.41605	371.63256	512.77458
L3	47.7739	13924132.228	2252876.1270	13924179.9850	2252877.3814
Bearing//Station	1	30	16.61	581.46666	629.241

Curves: Radius = 4000' for C1 and C2; Radius=35' for C3


Curve #	Length	Start-North	End-East	Start-North	End-North
C1/R=4000'	76.4064	13923846.0057	2252873.6658	13923922.4109	2252873.6304
Sweep//Station	1	5	40	295.2262	371.6326
C2/R=4000'	68.6921	13924063.5471	2252874.9130	13924132.2276	2252876.1270
Sweep//Station	0	59	2	512.7746	581.4667
C3/R=35'	54.9779	13924179.985	2252877.3814	13924214.9850	2252842.3814
Sweep//Station	90	0	0	629.2405	684.2184

REVISION	NO.	DATE


PROJECT #
 ISSUE:
 DATE:
 DRAWN BY:

DETAILS
C4.01

PATH: Z:\2022 Open Projects\Woodcreek, Tx Engineering Project TDA\CADD\100% Submittal\DEERFIELD DRIVE _Construct Road_Plan and Profile.dwg
 USER: Dec 31, 2024 - 3:19pm jsmart
 PLOT TAB: GRADING

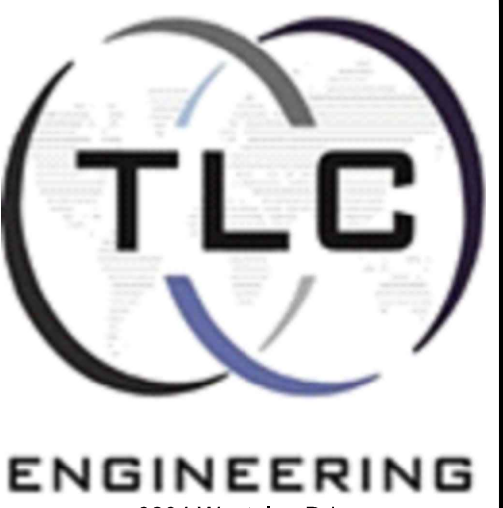

8204 Westglen Drive
 Houston, Texas 77063
 713.868.0001 WWW.TLCeng.com
 F-4066

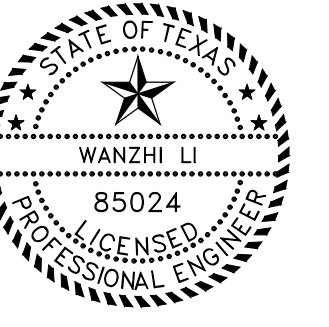

100% SUBMITTAL

CITY OF WOODCREEK
 DEERFIELD DRIVE
 WOODCREEK Texas, 78676

REVISION



NO.	DATE

PROJECT #
 ISSUE:
 DATE:
 DRAWN BY:

GRADING PLAN

C5.01
 1 OF 1


ALL NECESSARY DRIVEWAY REPLACEMENTS SHOULD MATCH LIKE KIND AND QUALITY - CONCRETE REPAIRS CONCRETE, ASPHALT REPAIRS ASPHALT, GRAVEL REPAIRS GRAVEL

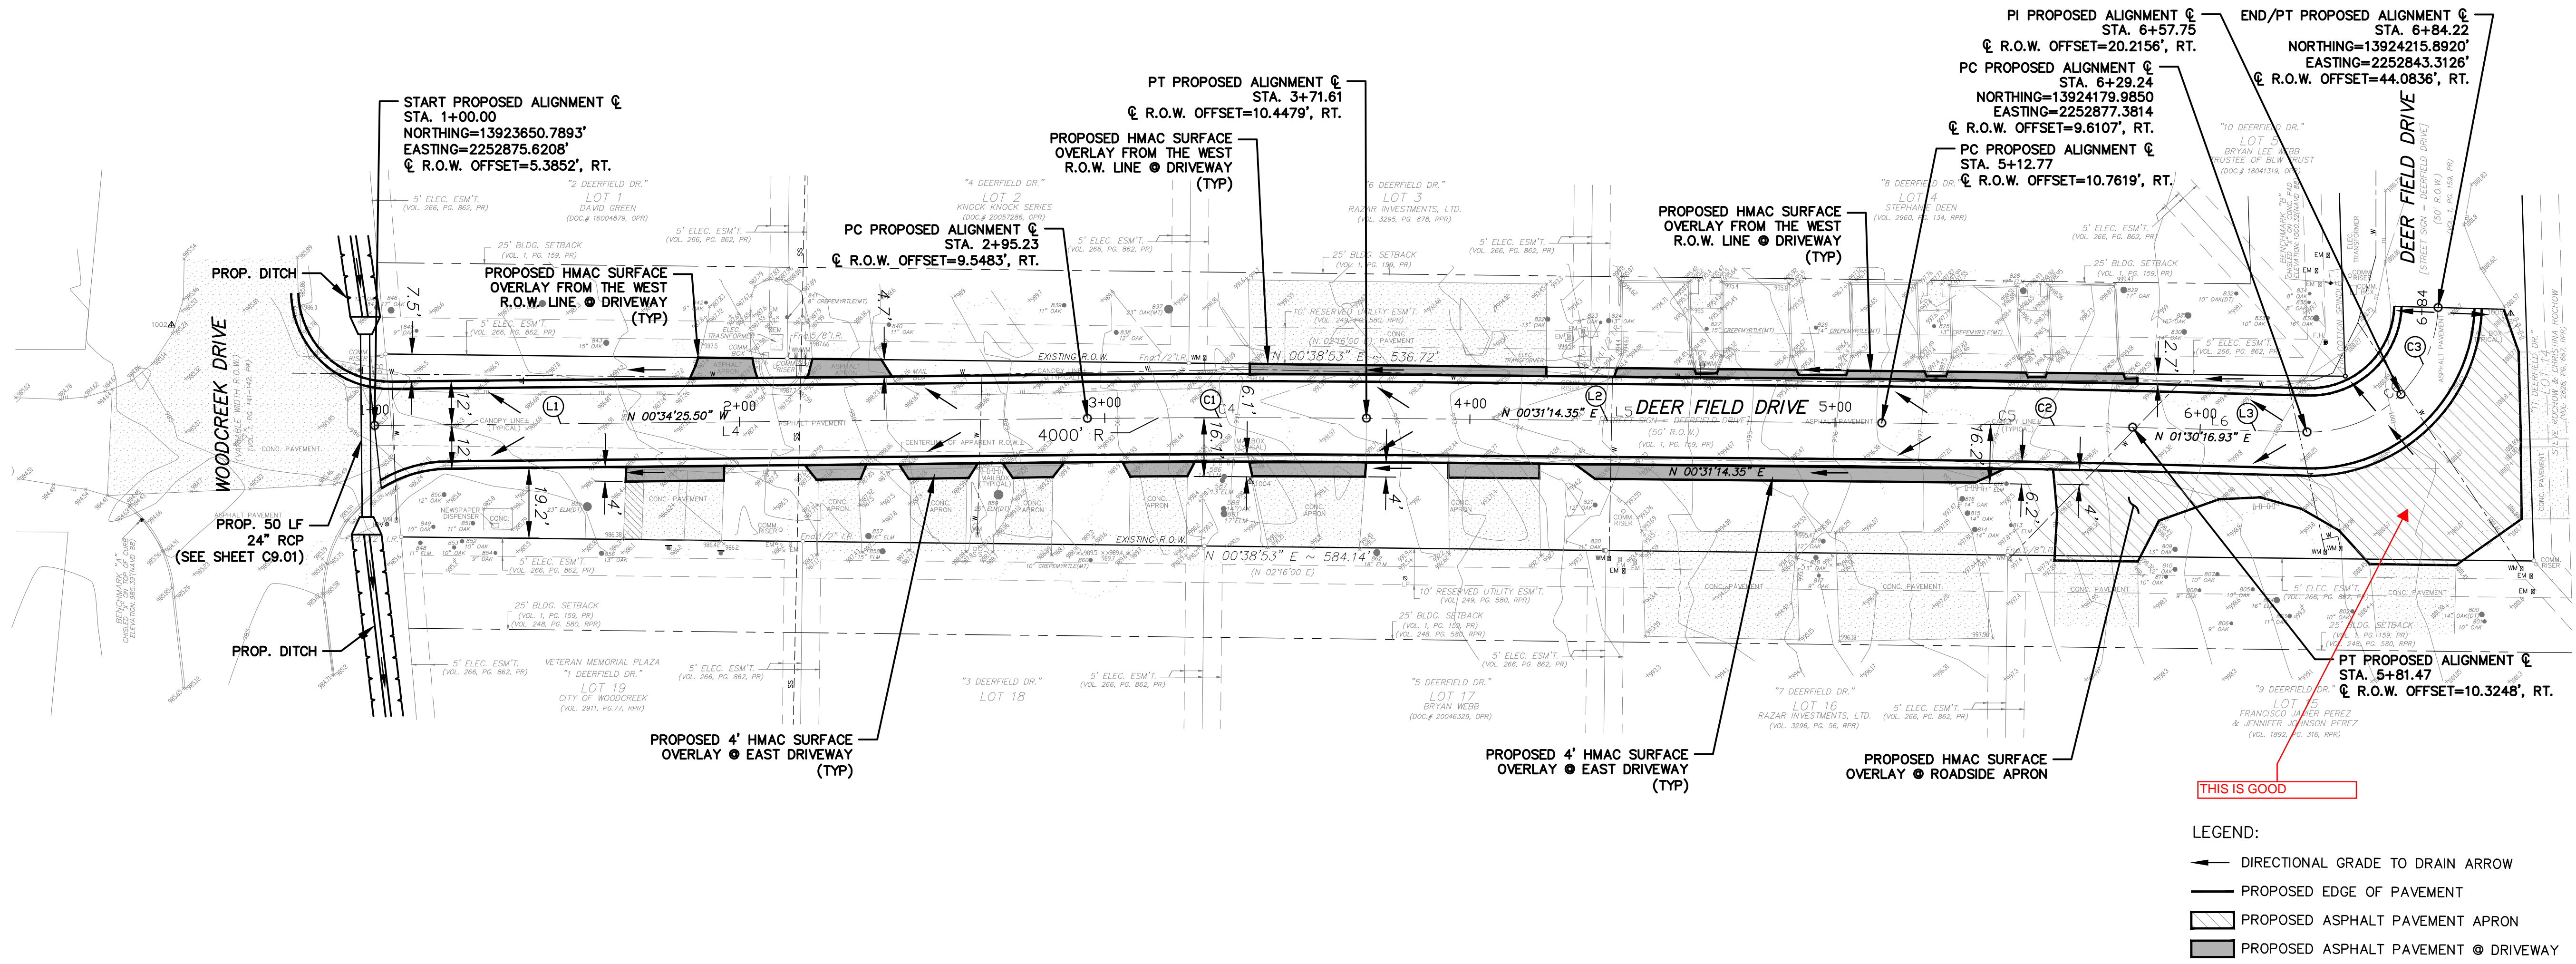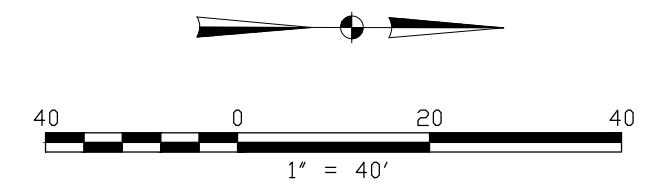


- LEGEND:
- DIRECTIONAL GRADE TO DRAIN ARROW
 - PROPOSED EDGE OF PAVEMENT
 - ▨ PROPOSED ASPHALT PAVEMENT APRON
 - ▩ PROPOSED ASPHALT PAVEMENT @ DRIVEWAY

Finalized Control Points for Lines and Curves					
Line #	Length	Start-North	End-East	Start-North	End-North
L1	195.2262	13923650.7893	2252875.6208	13923846.0057	2252873.6658
Bearing/Station	0	-34.0000	-25.571	100.0000	295.22616
L2	141.1420	13923922.4109	2252873.6304	13924063.5471	2252874.9130
Bearing/Station	0	31.0000	14.41605	371.63256	512.77458
L3	47.7739	13924132.228	2252876.1270	13924179.9850	2252877.3814
Bearing/Station	1	30	16.61	581.46666	629.241

Curves: Radius = 4000' for C1 and C2; Radius = 35' for C3					
Curve #	Length	Start-North	End-East	Start-North	End-North
C1/R=4000'	76.4064	13923846.0057	2252873.6658	13923922.4109	2252873.6304
Sweep/Station	1	5	40	295.2262	371.6326
C2/R=4000'	68.6921	13924063.5471	2252874.9130	13924132.2276	2252876.1270
Sweep/Station	0	59	2	512.7746	581.4667
C3/R=35'	54.9779	13924179.985	2252877.3814	13924214.9850	2252842.3814
Sweep/Station	90	0	0	629.2405	684.2184

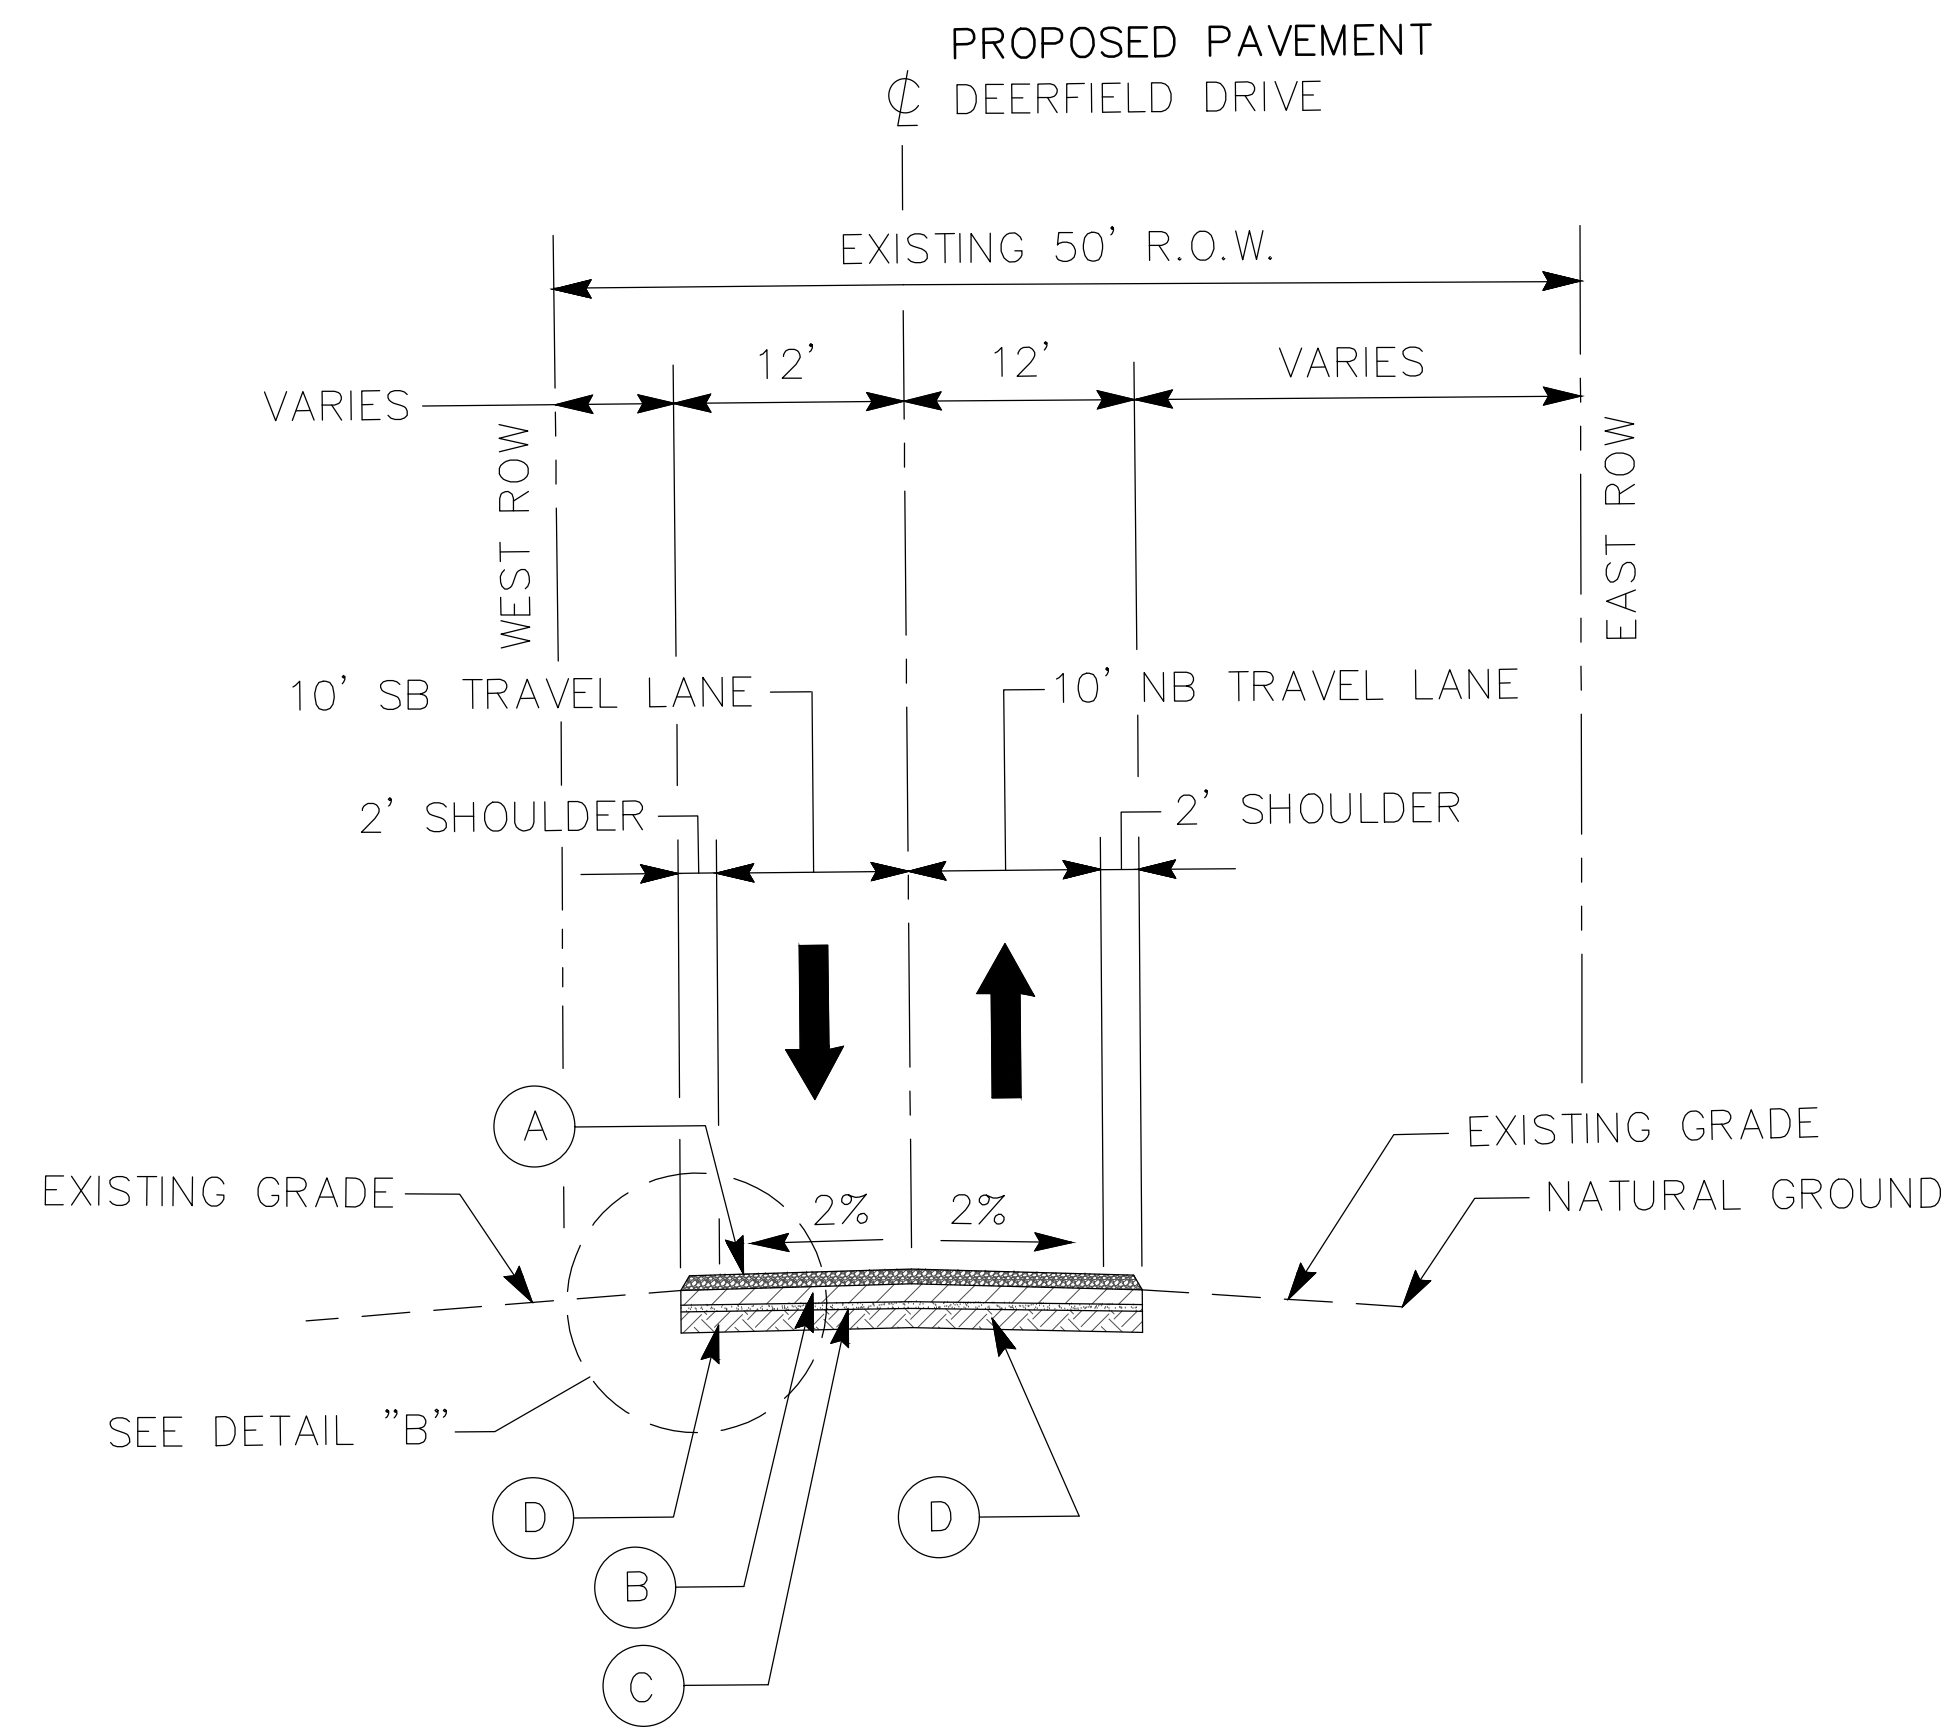


1 PROPOSED TYPICAL SECTION
N.T.S.

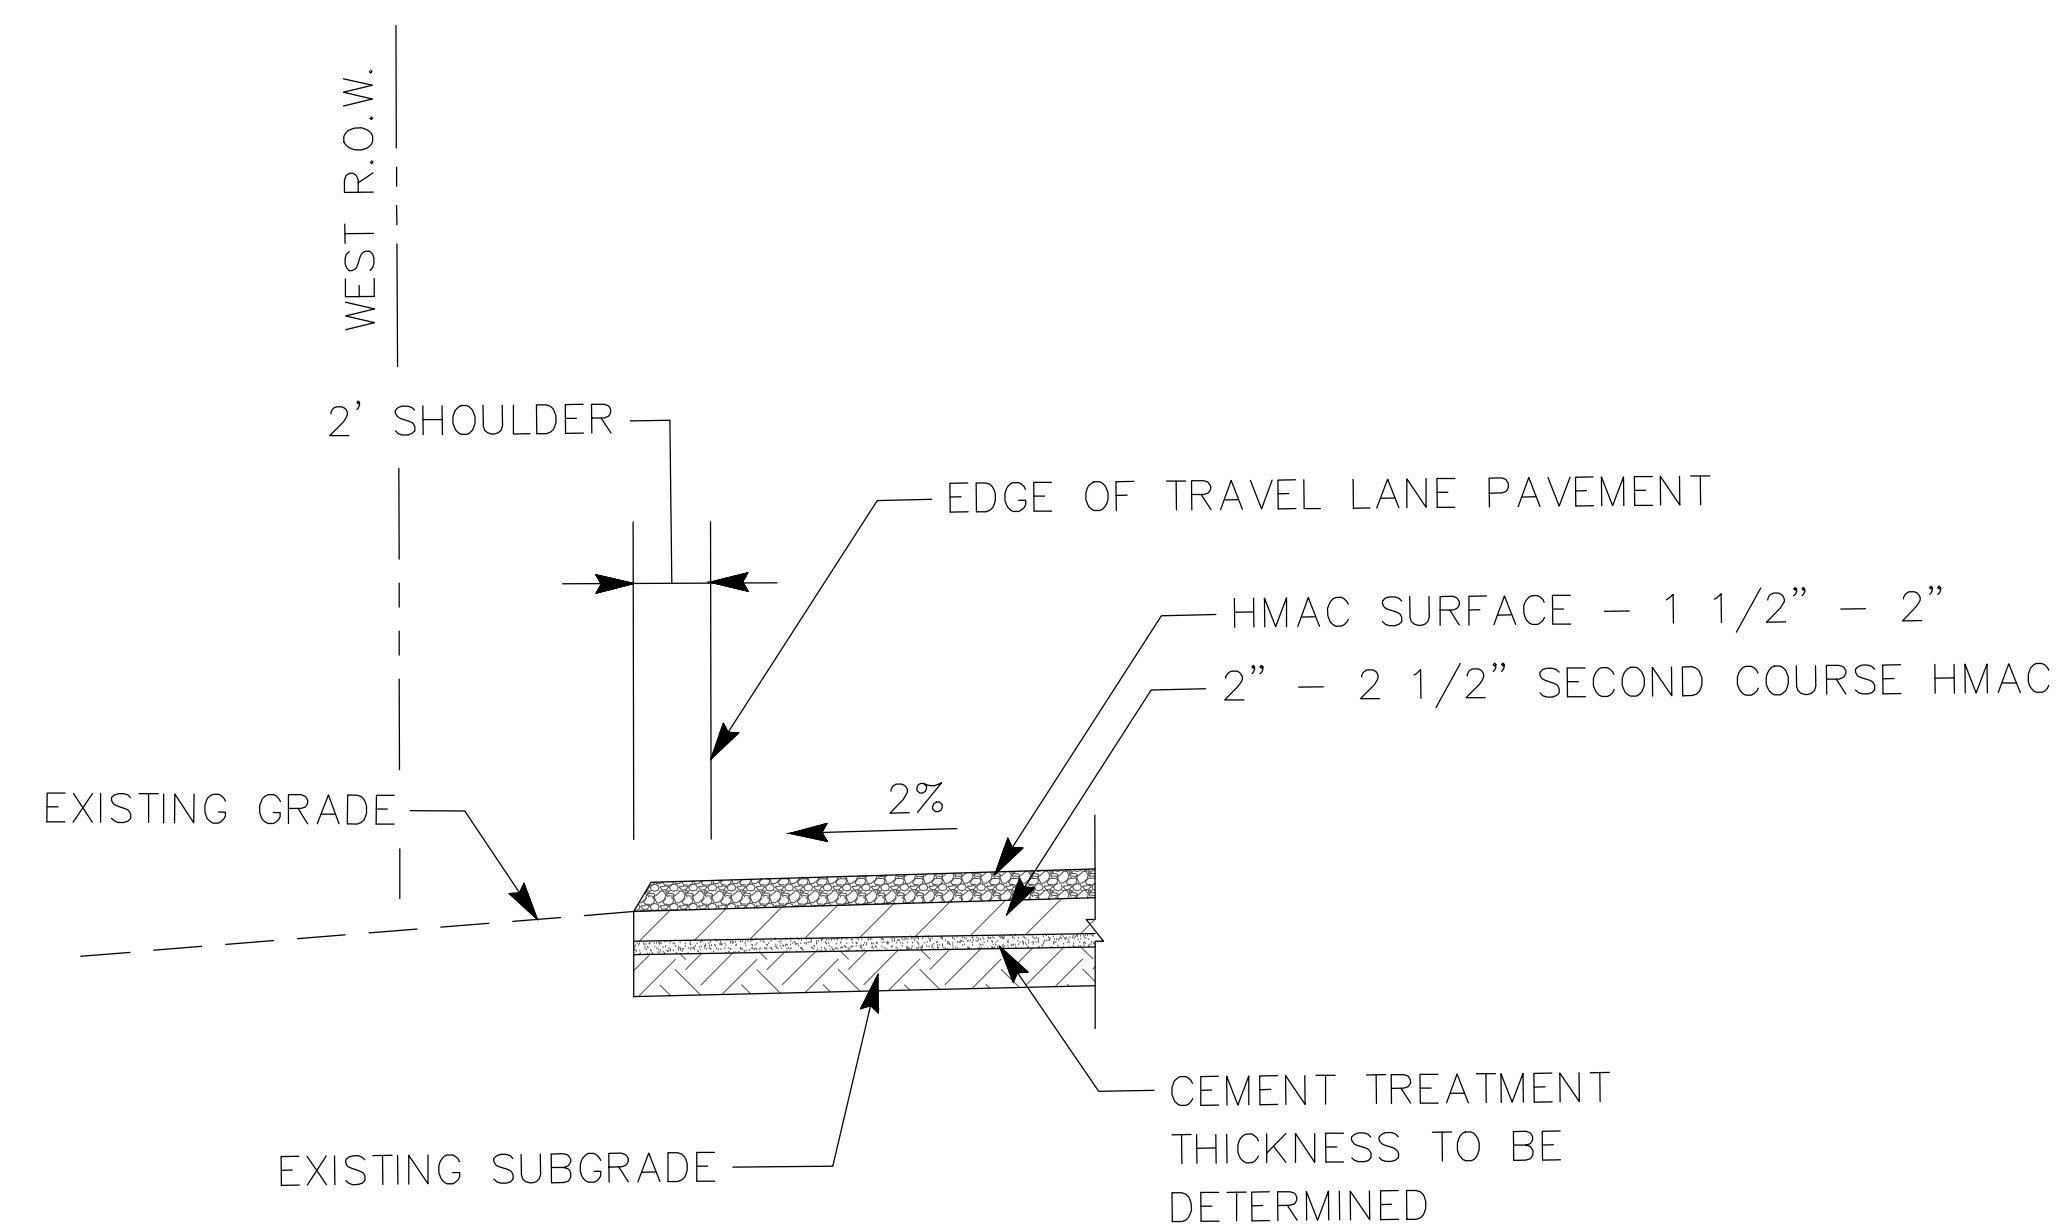

B DETAIL
N.T.S.


- LEGEND:
- (A) 1 1/2" - 2" HMAC SURFACE
 - (B) 2" - 2 1/2" SECOND COURSE HMAC
 - (C) CEMENT BASE TREATMENT
 - (D) EXISTING SUBGRADE
 - (E) THE CLIENT SHOULD DETERMINE THE TYPICAL SECTIONS PRIOR TO STARTING 60% DESIGN
- ➔ NEW TRAVEL LANE

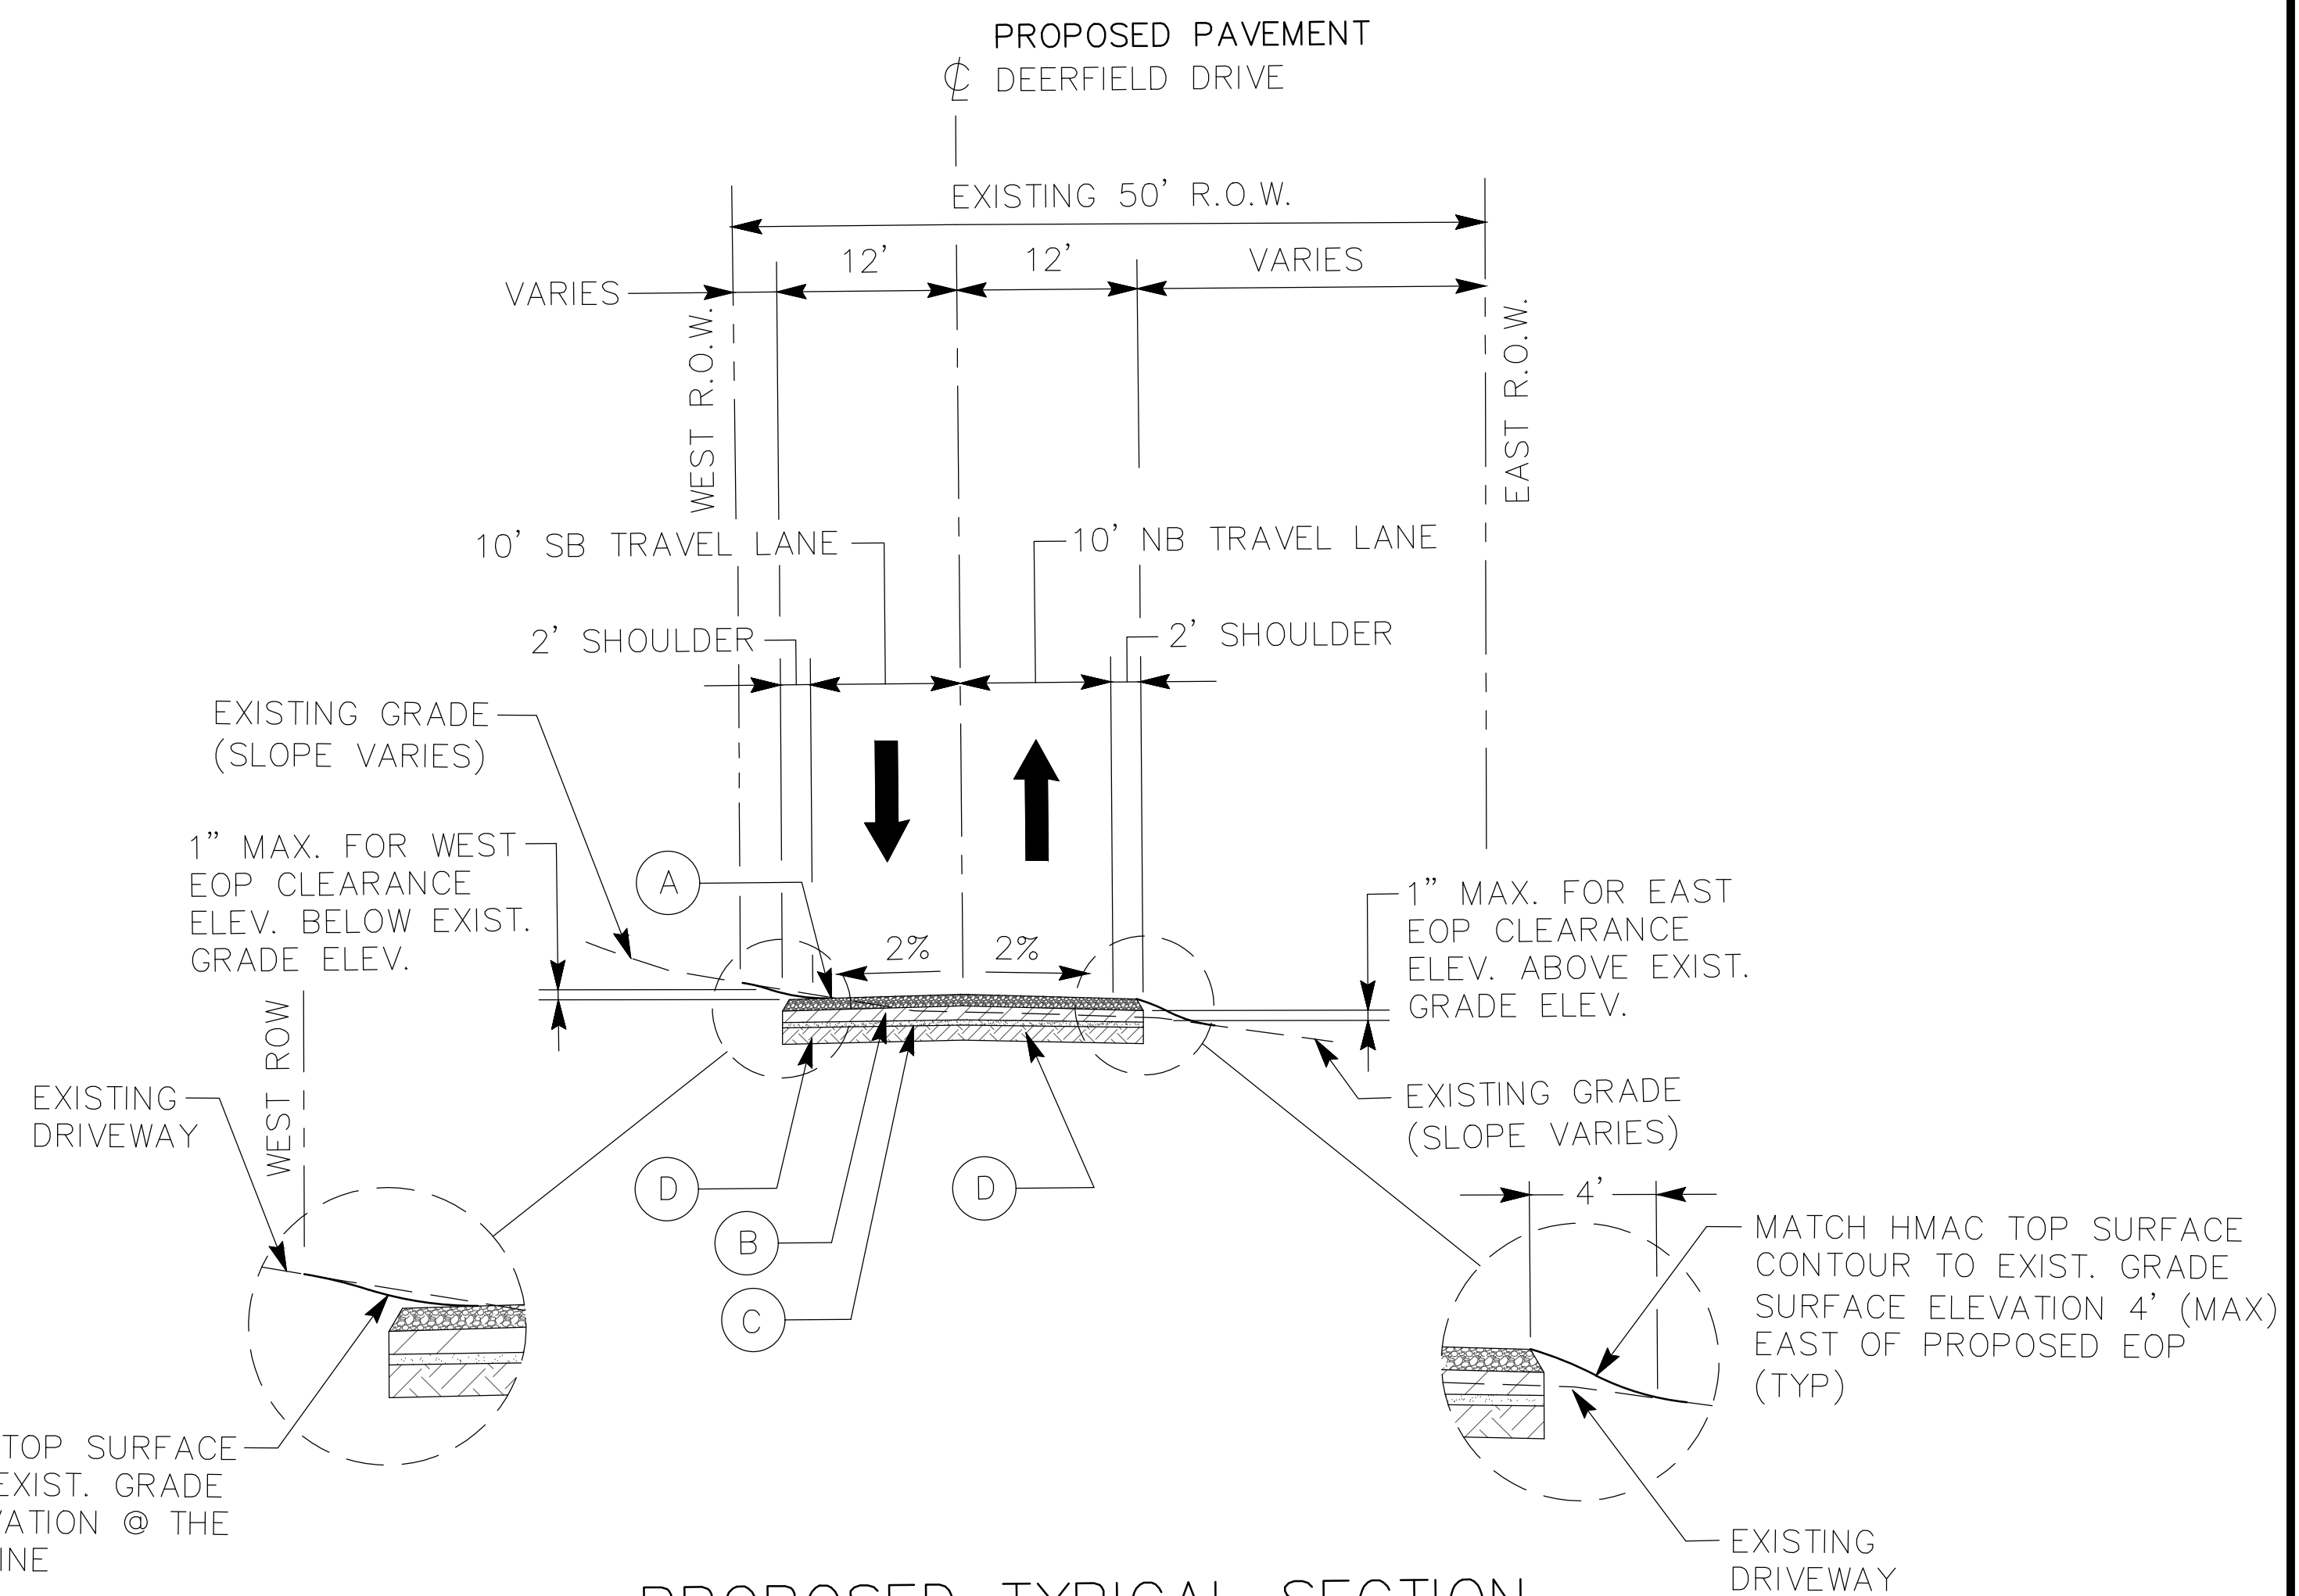

2 PROPOSED TYPICAL SECTION
N.T.S.



ENGINEERING
8204 Westglen Drive
Houston, Texas 77063
713.868.0001 WWW.TLCeng.com
F-4066

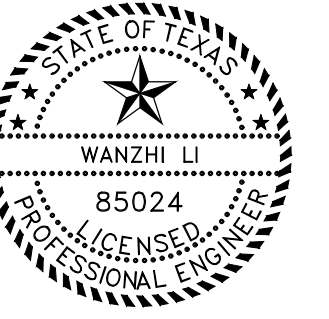

100% SUBMITTAL









CITY OF WOODCREEK
DEERFIELD DRIVE
WOODCREEK Texas, 78676

REVISION NO.	DATE


PROJECT #
ISSUE:
DATE:
DRAWN BY:

TYPICAL SECTIONS

C6.01

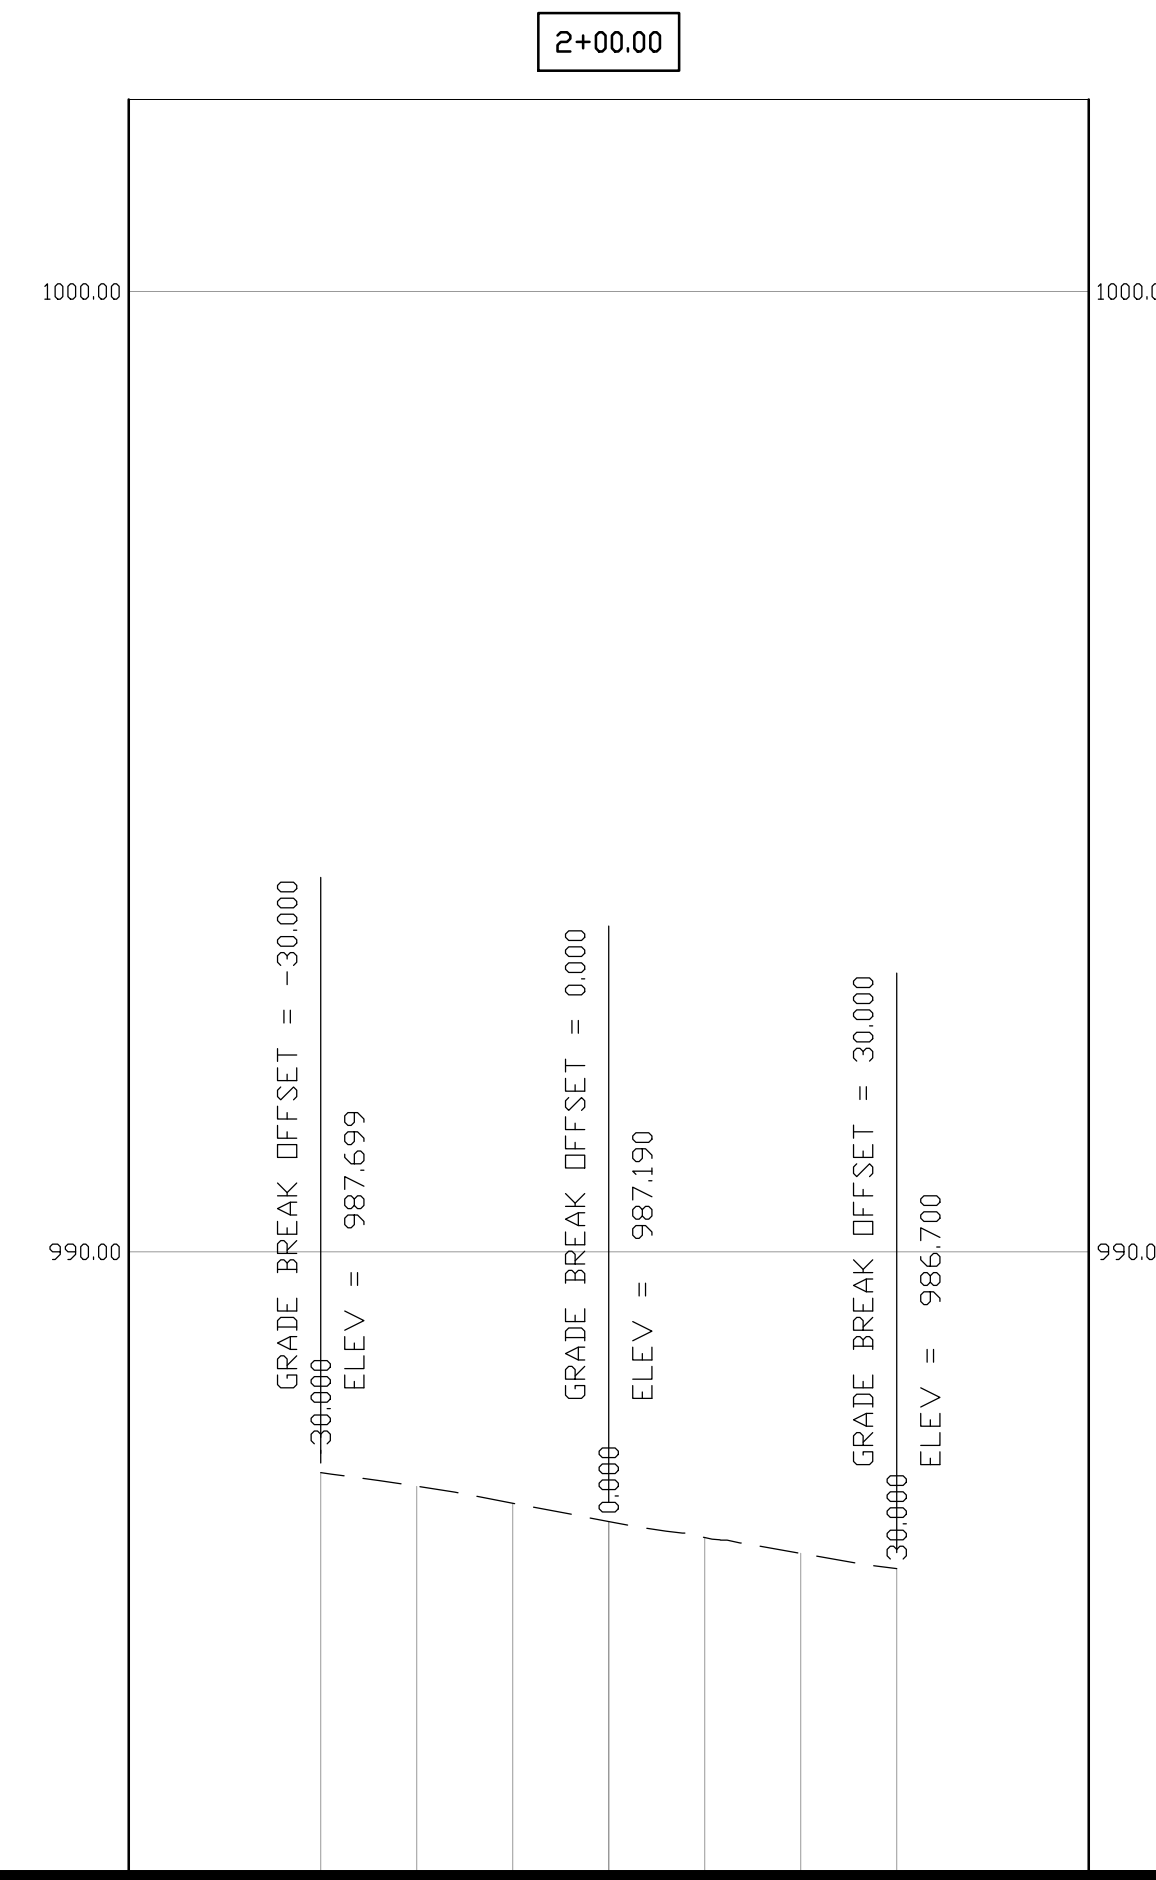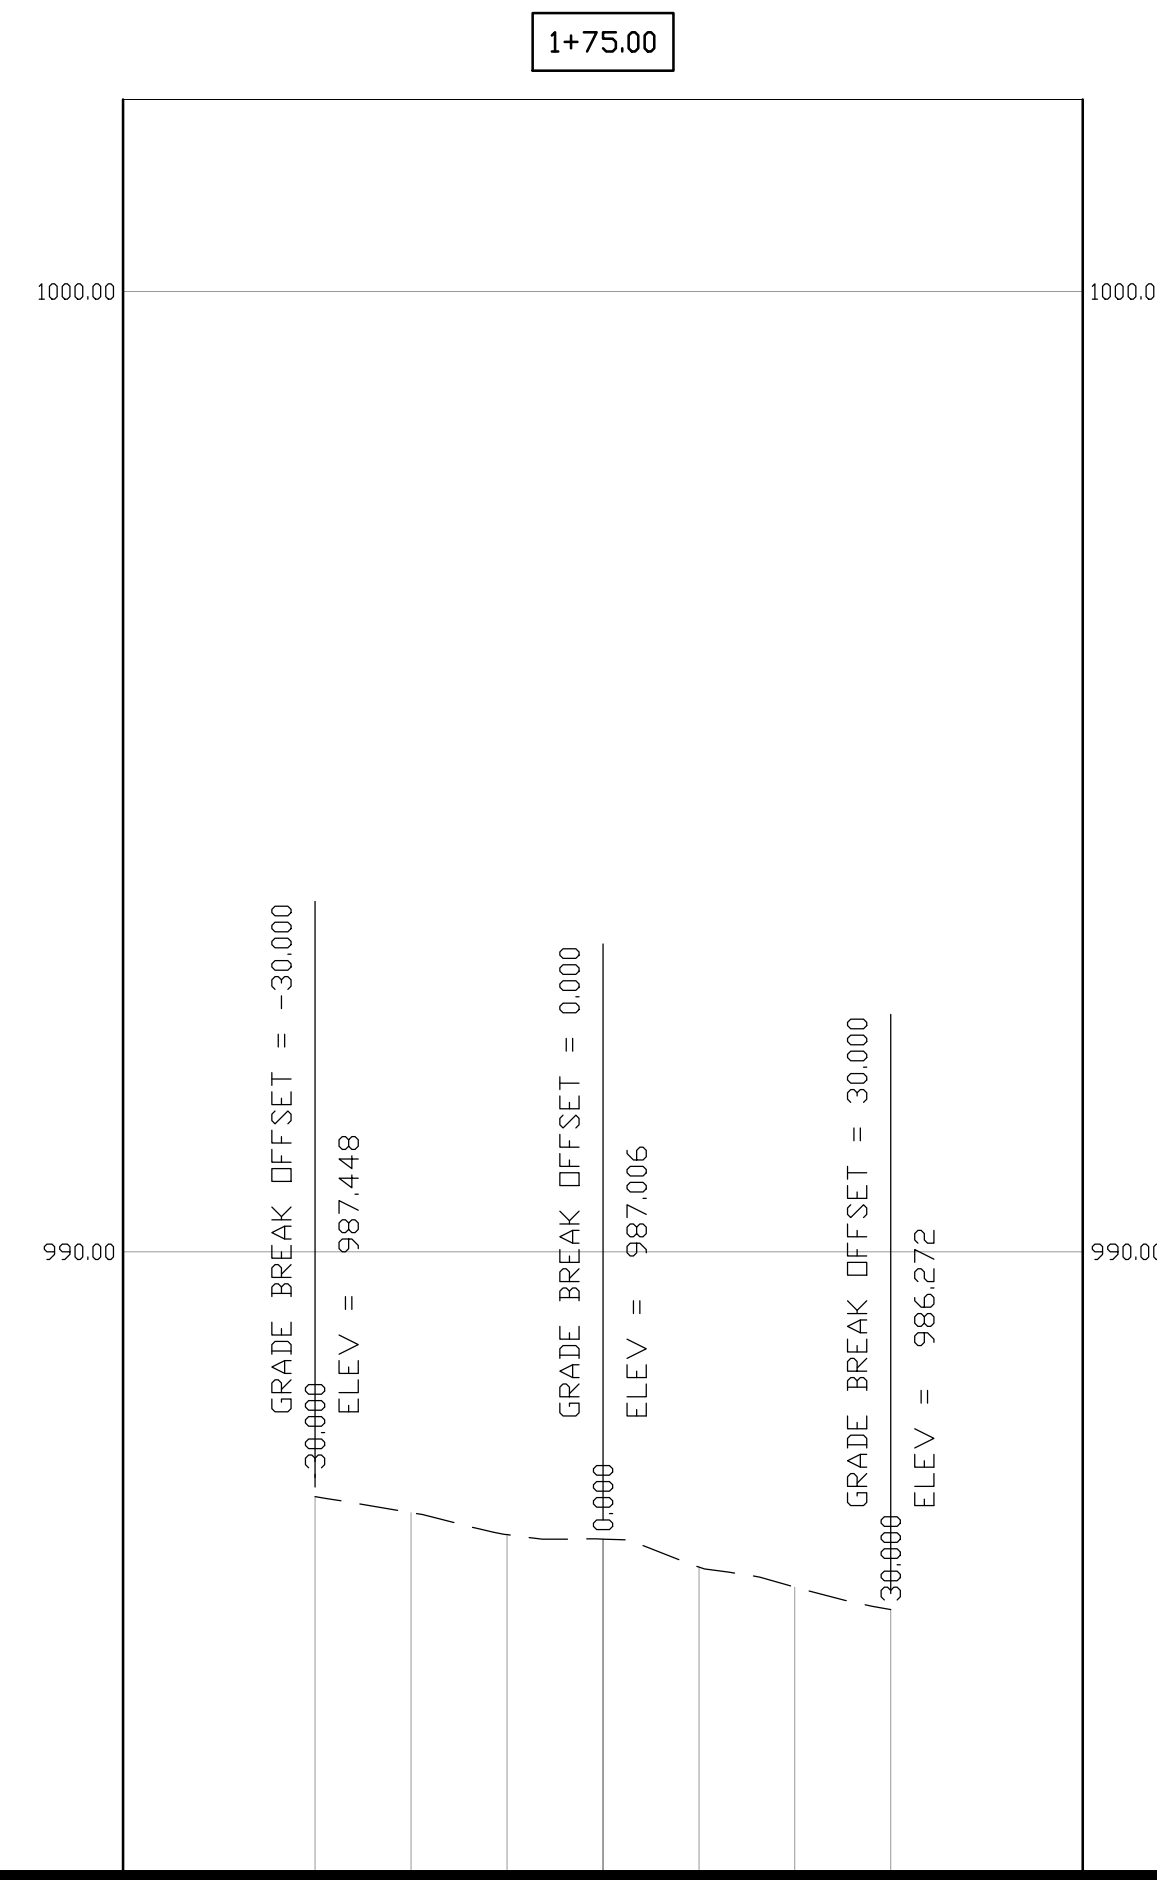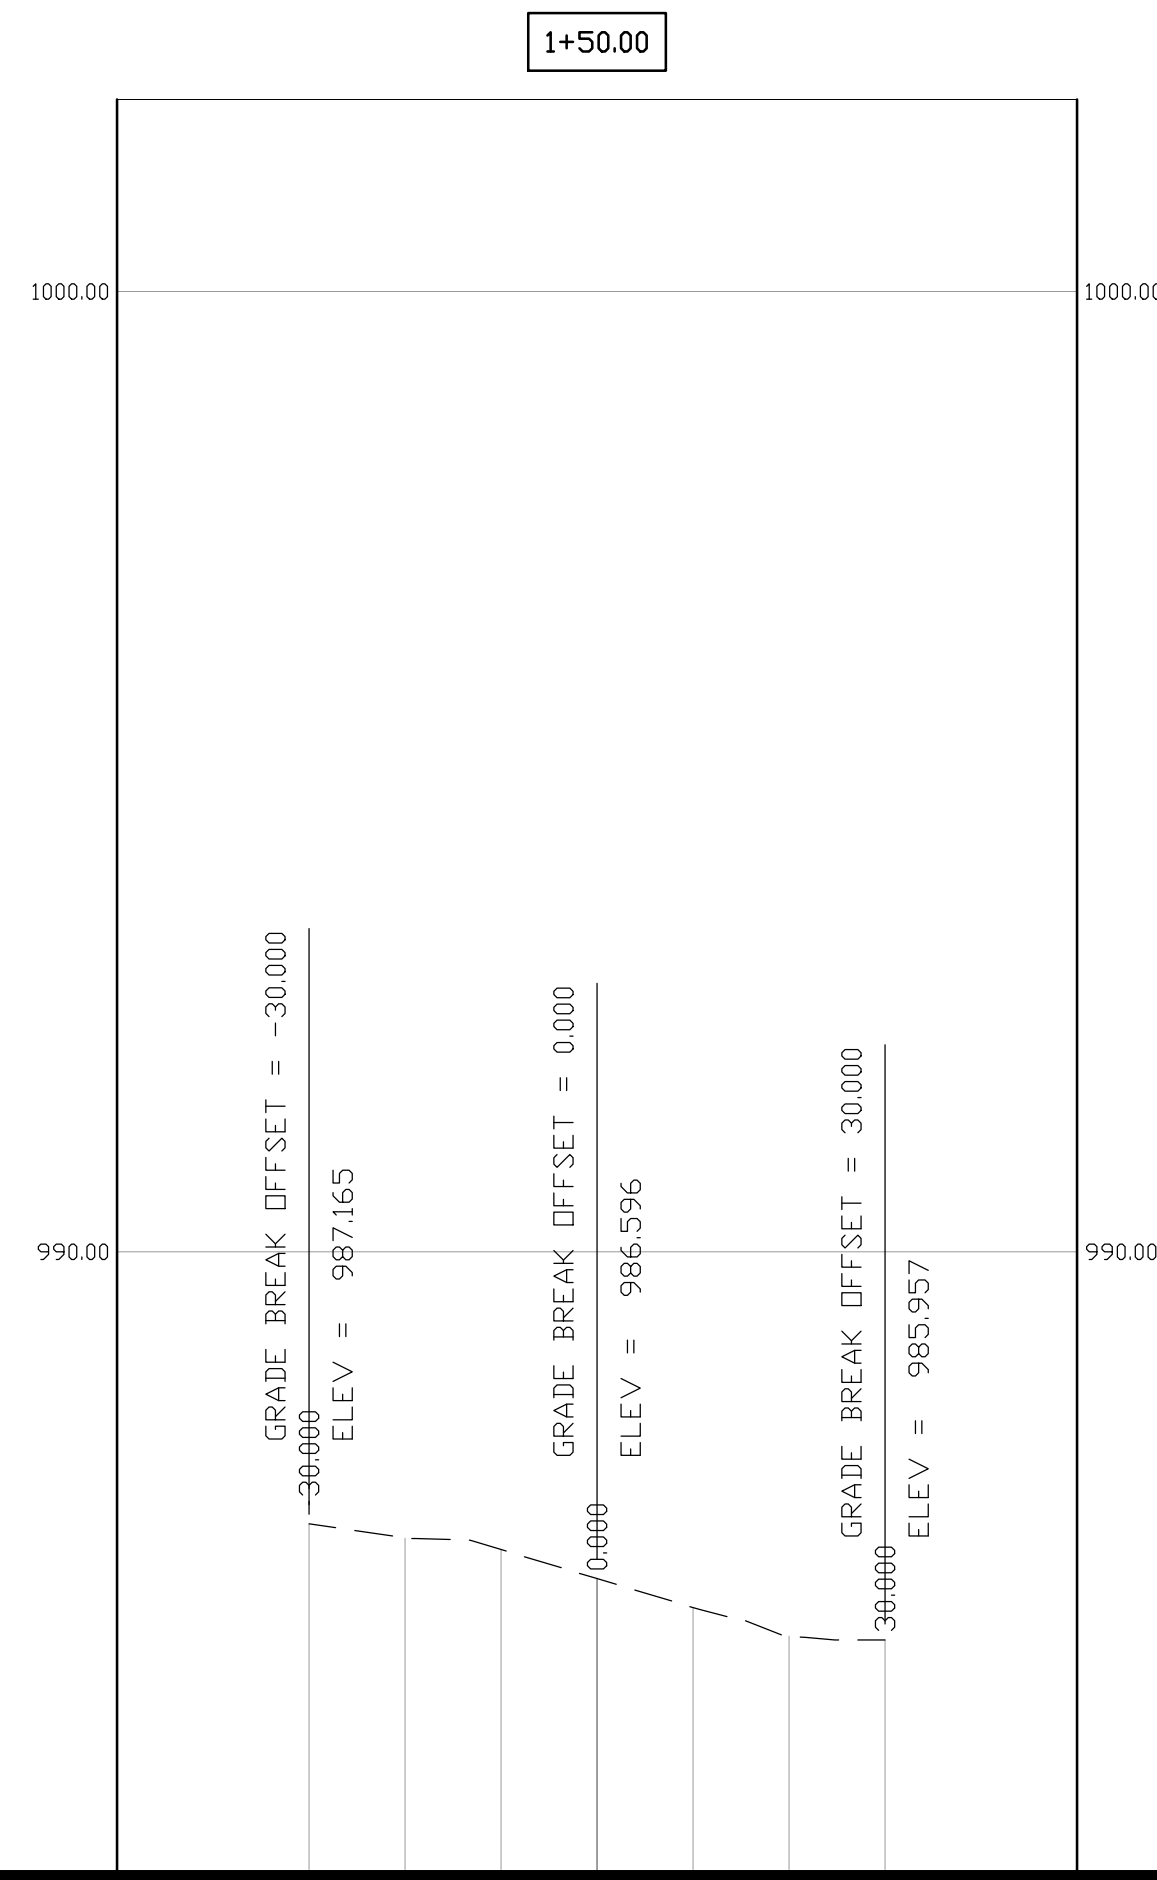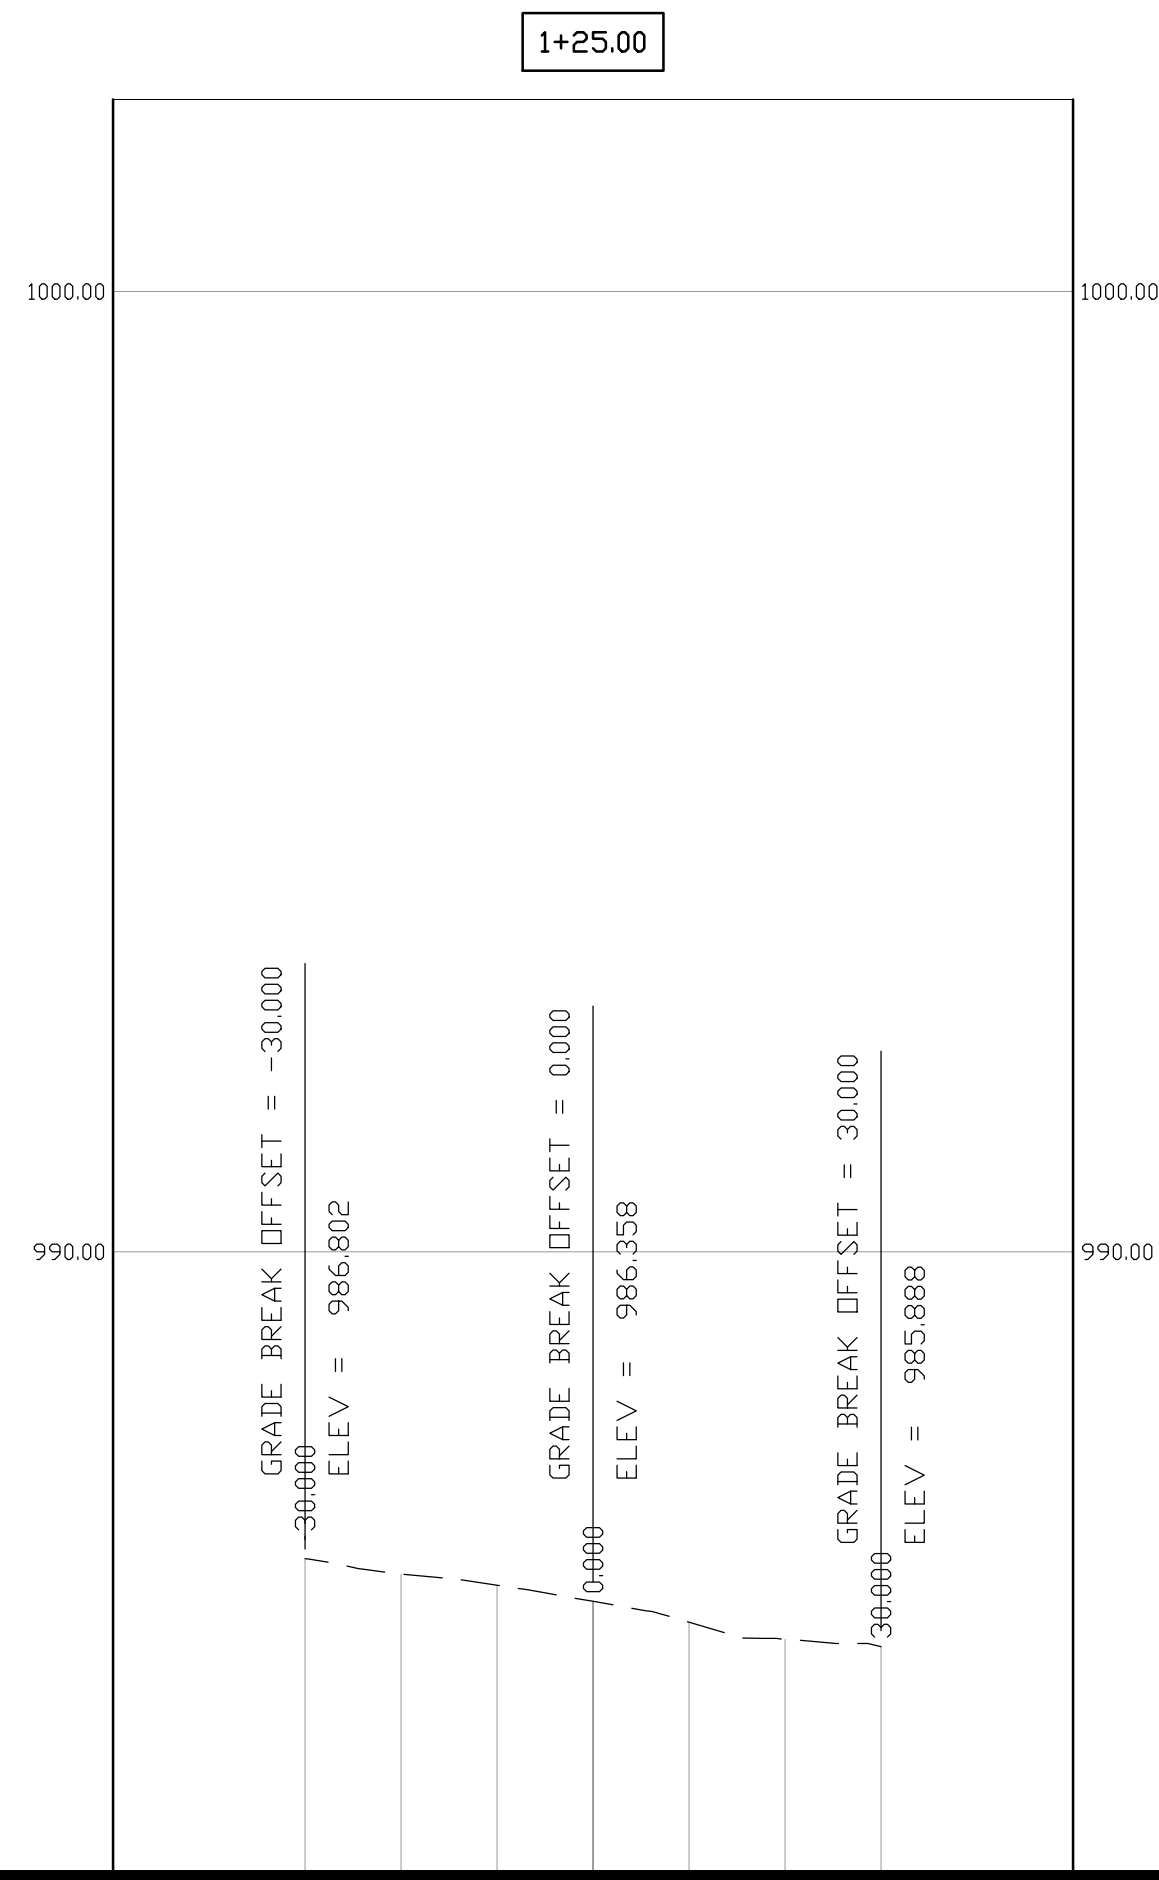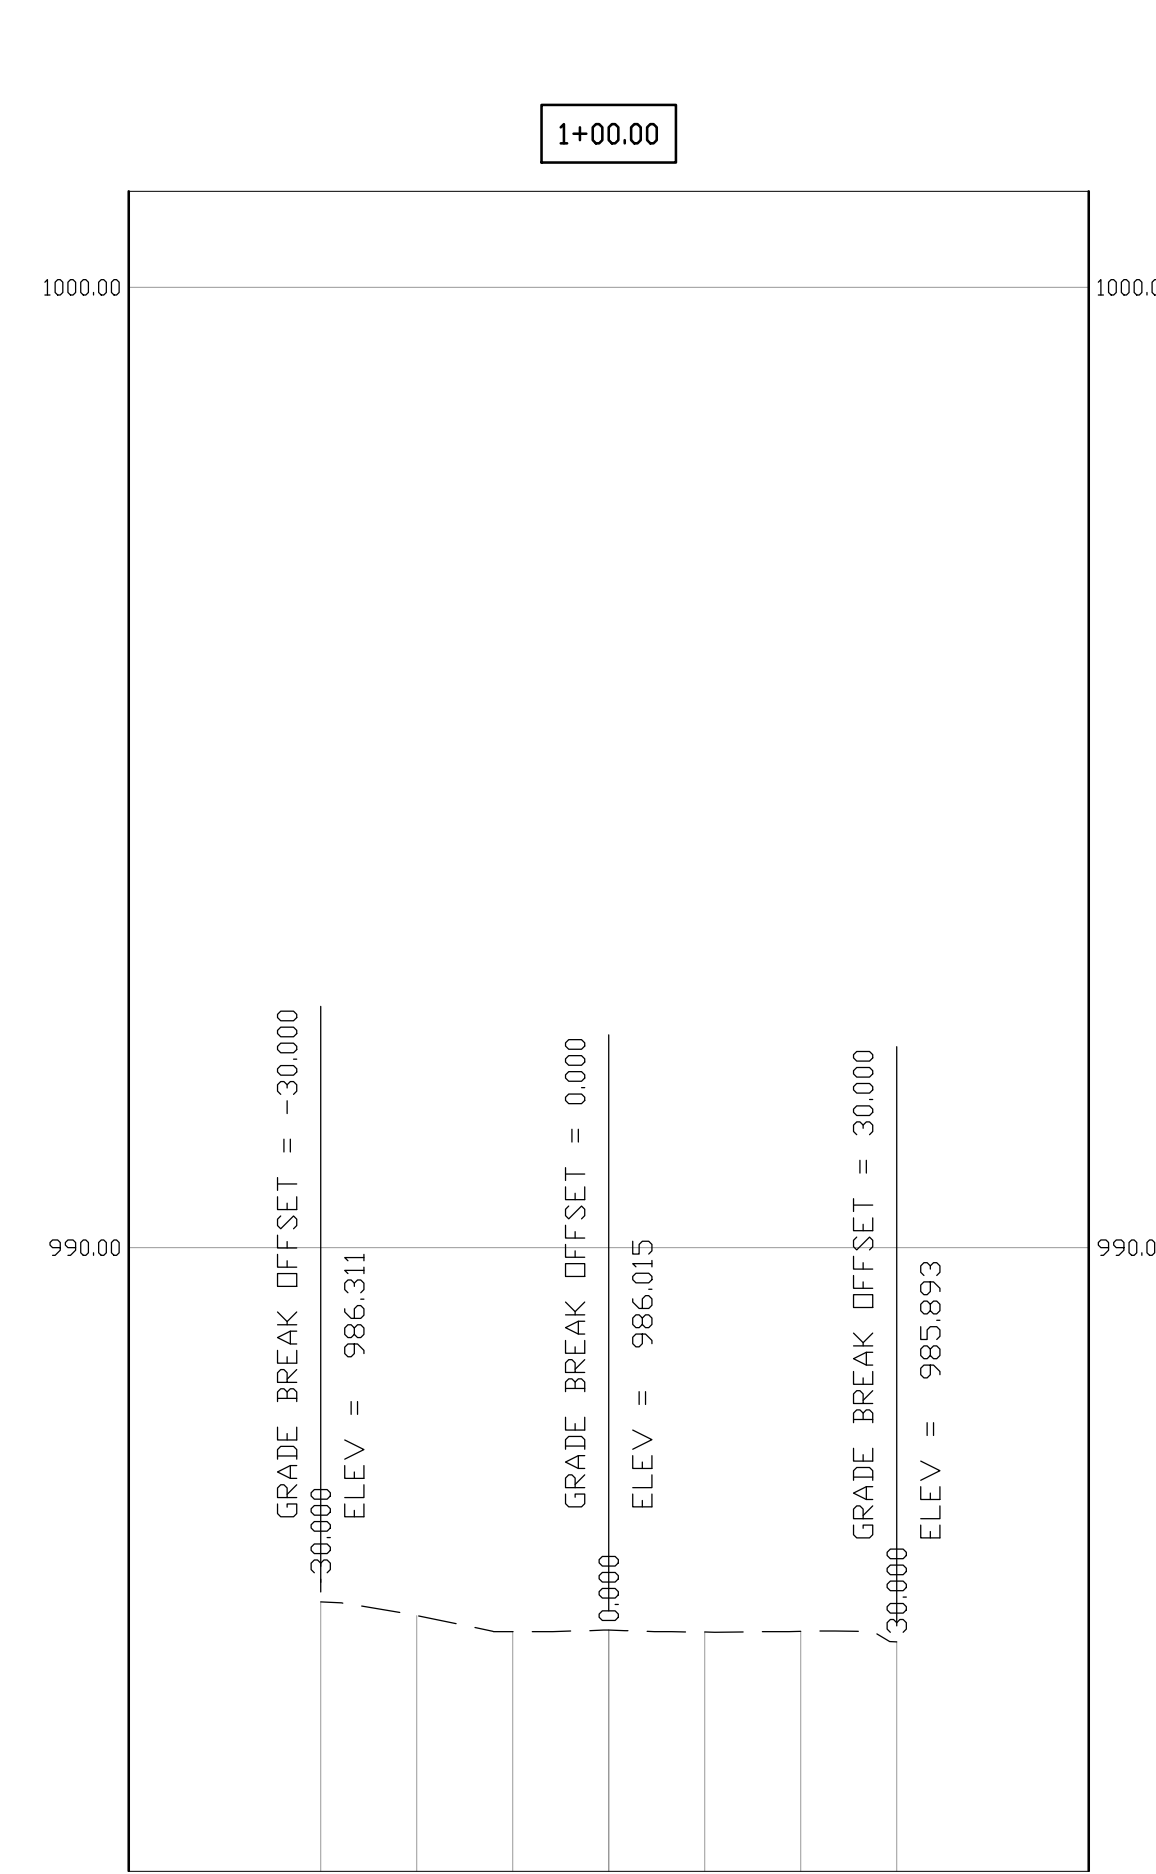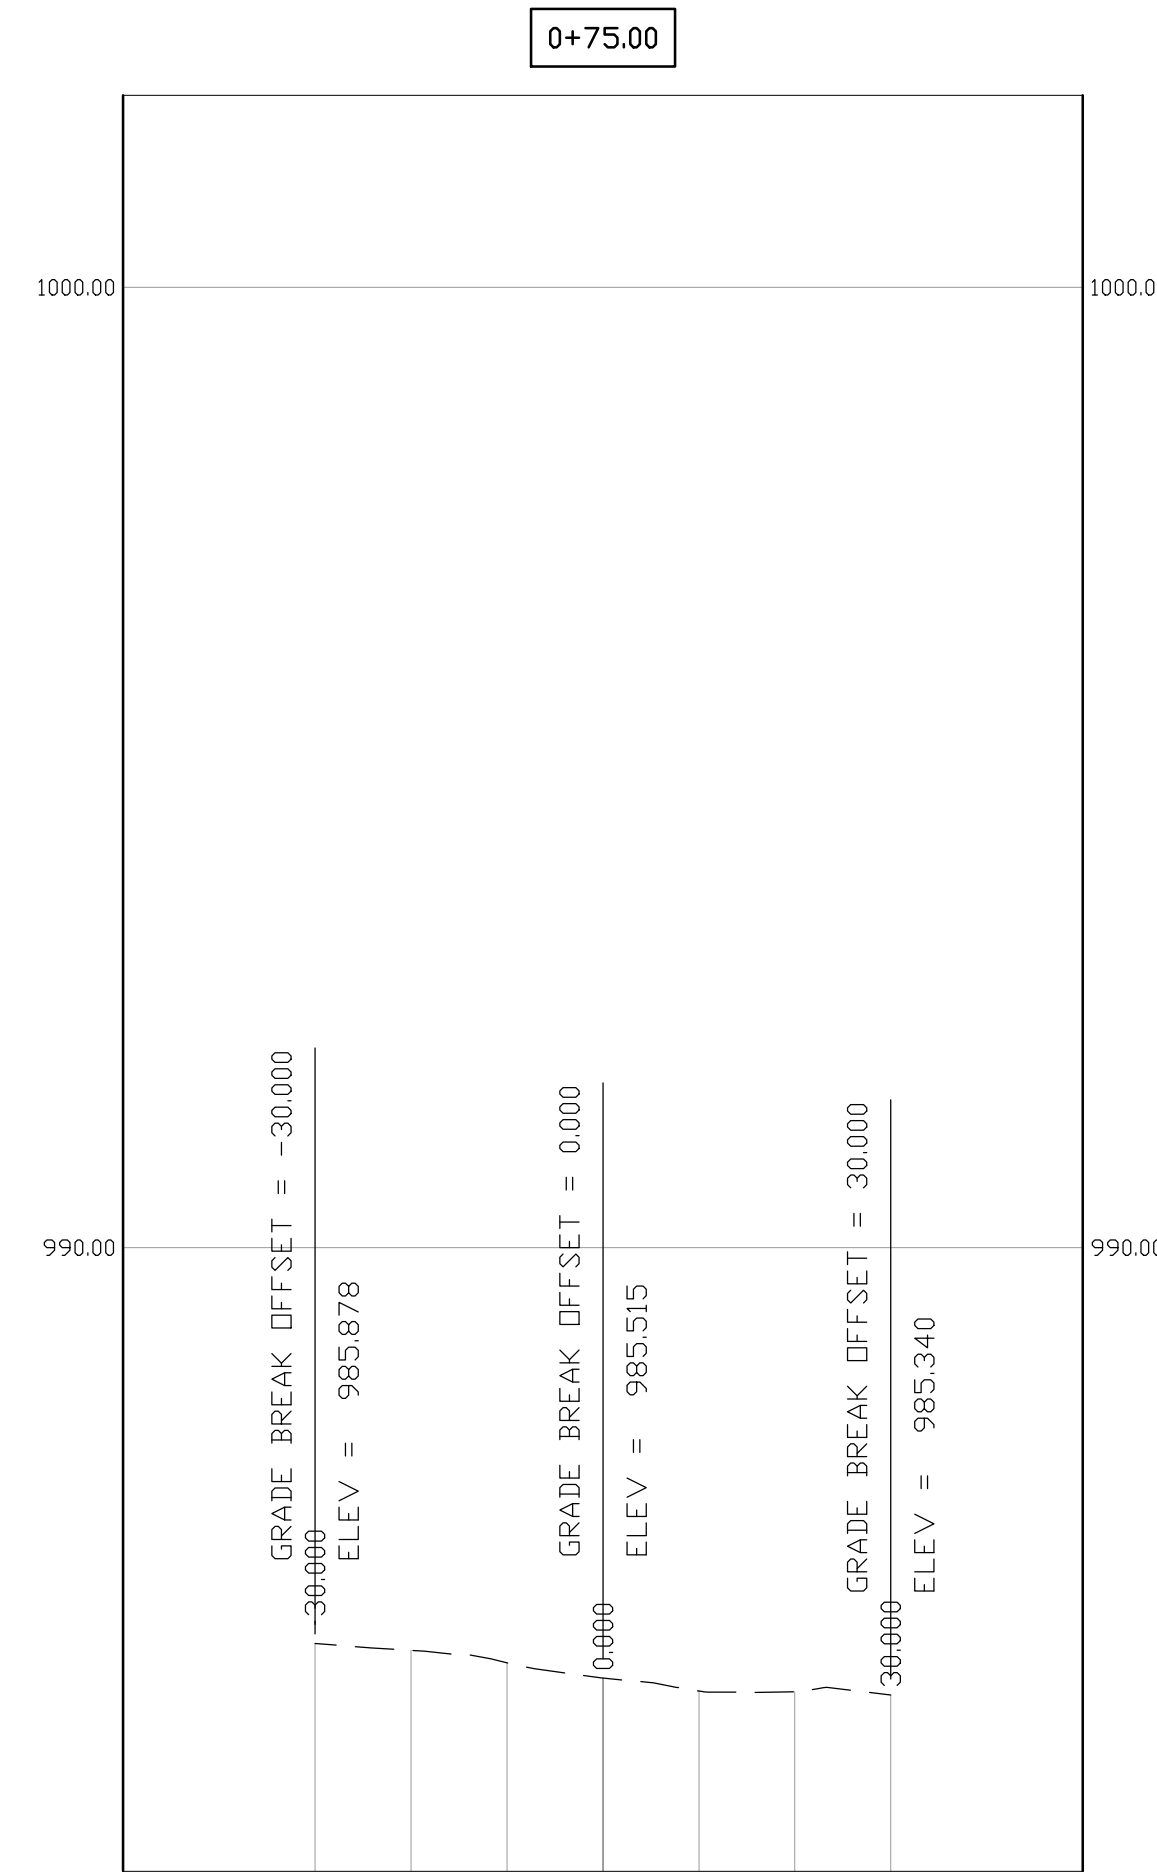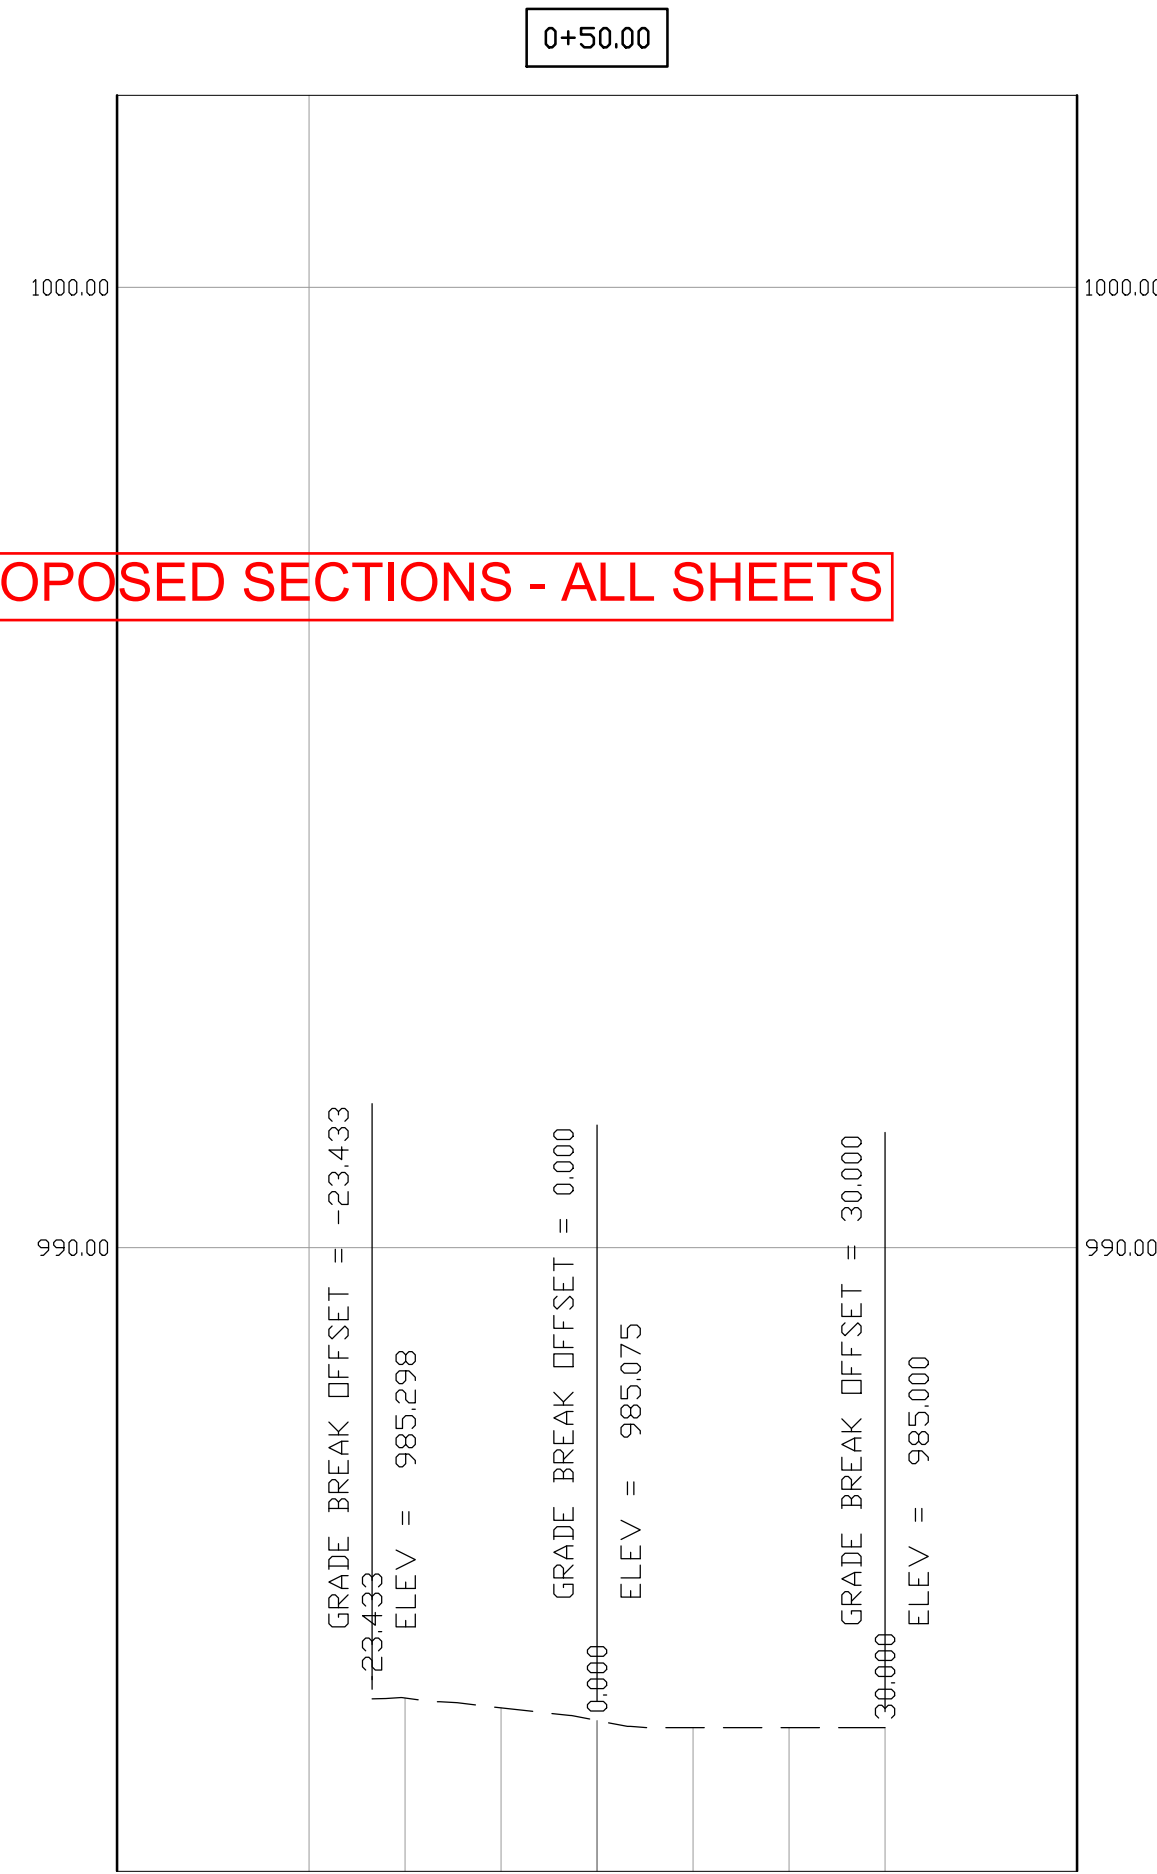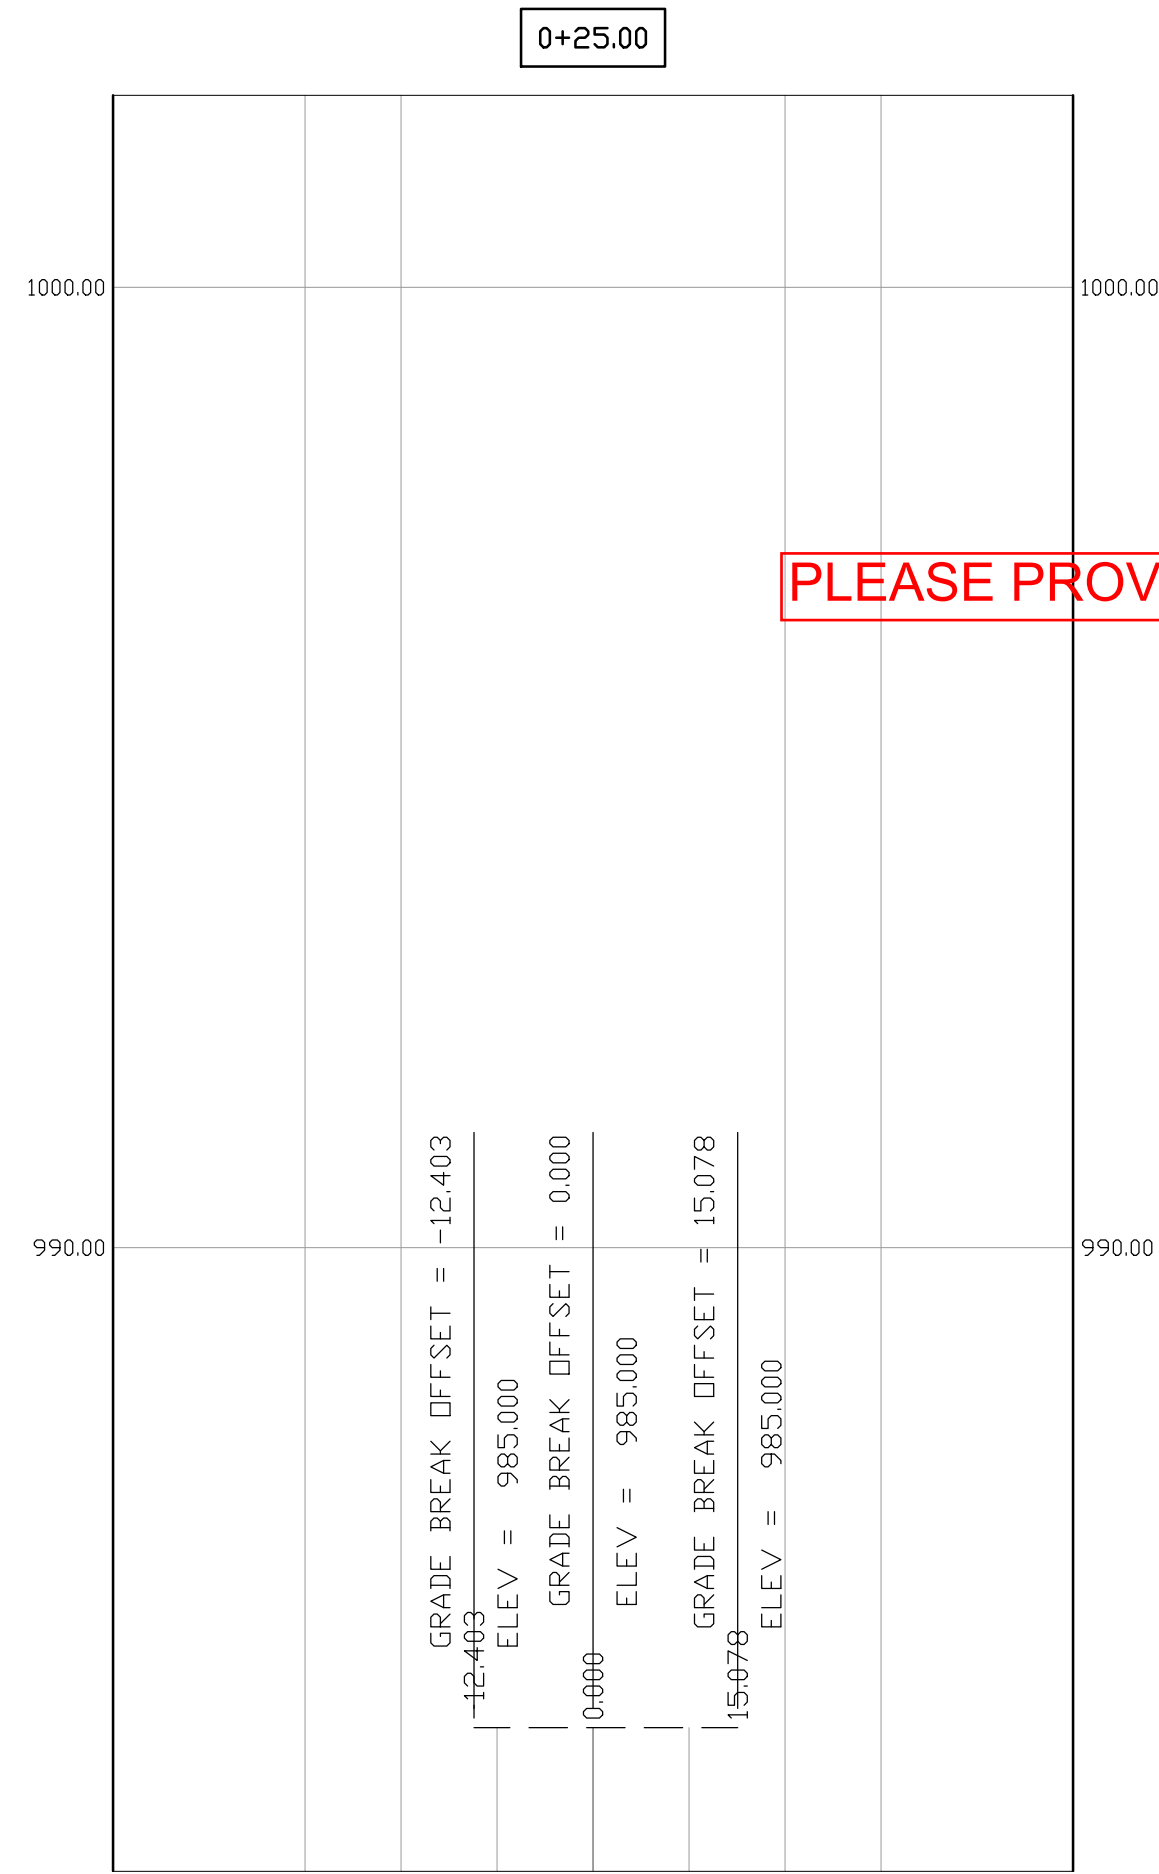

PLEASE PROVIDE PROPOSED SECTIONS - ALL SHEETS

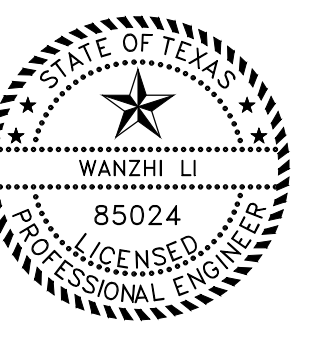

100% SUBMITTAL










CITY OF WOODCREEK
 DEERFIELD DRIVE
 WOODCREEK Texas, 78676

NO.	DATE

PROJECT #
 ISSUE:
 DATE:
 DRAWN BY:

EXIST. CROSS SECTIONS

C6.02
 1 OF 4

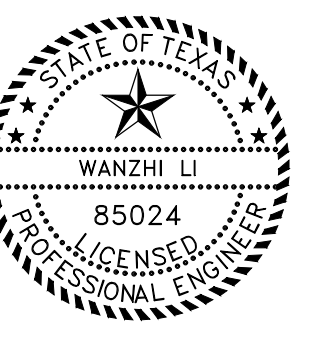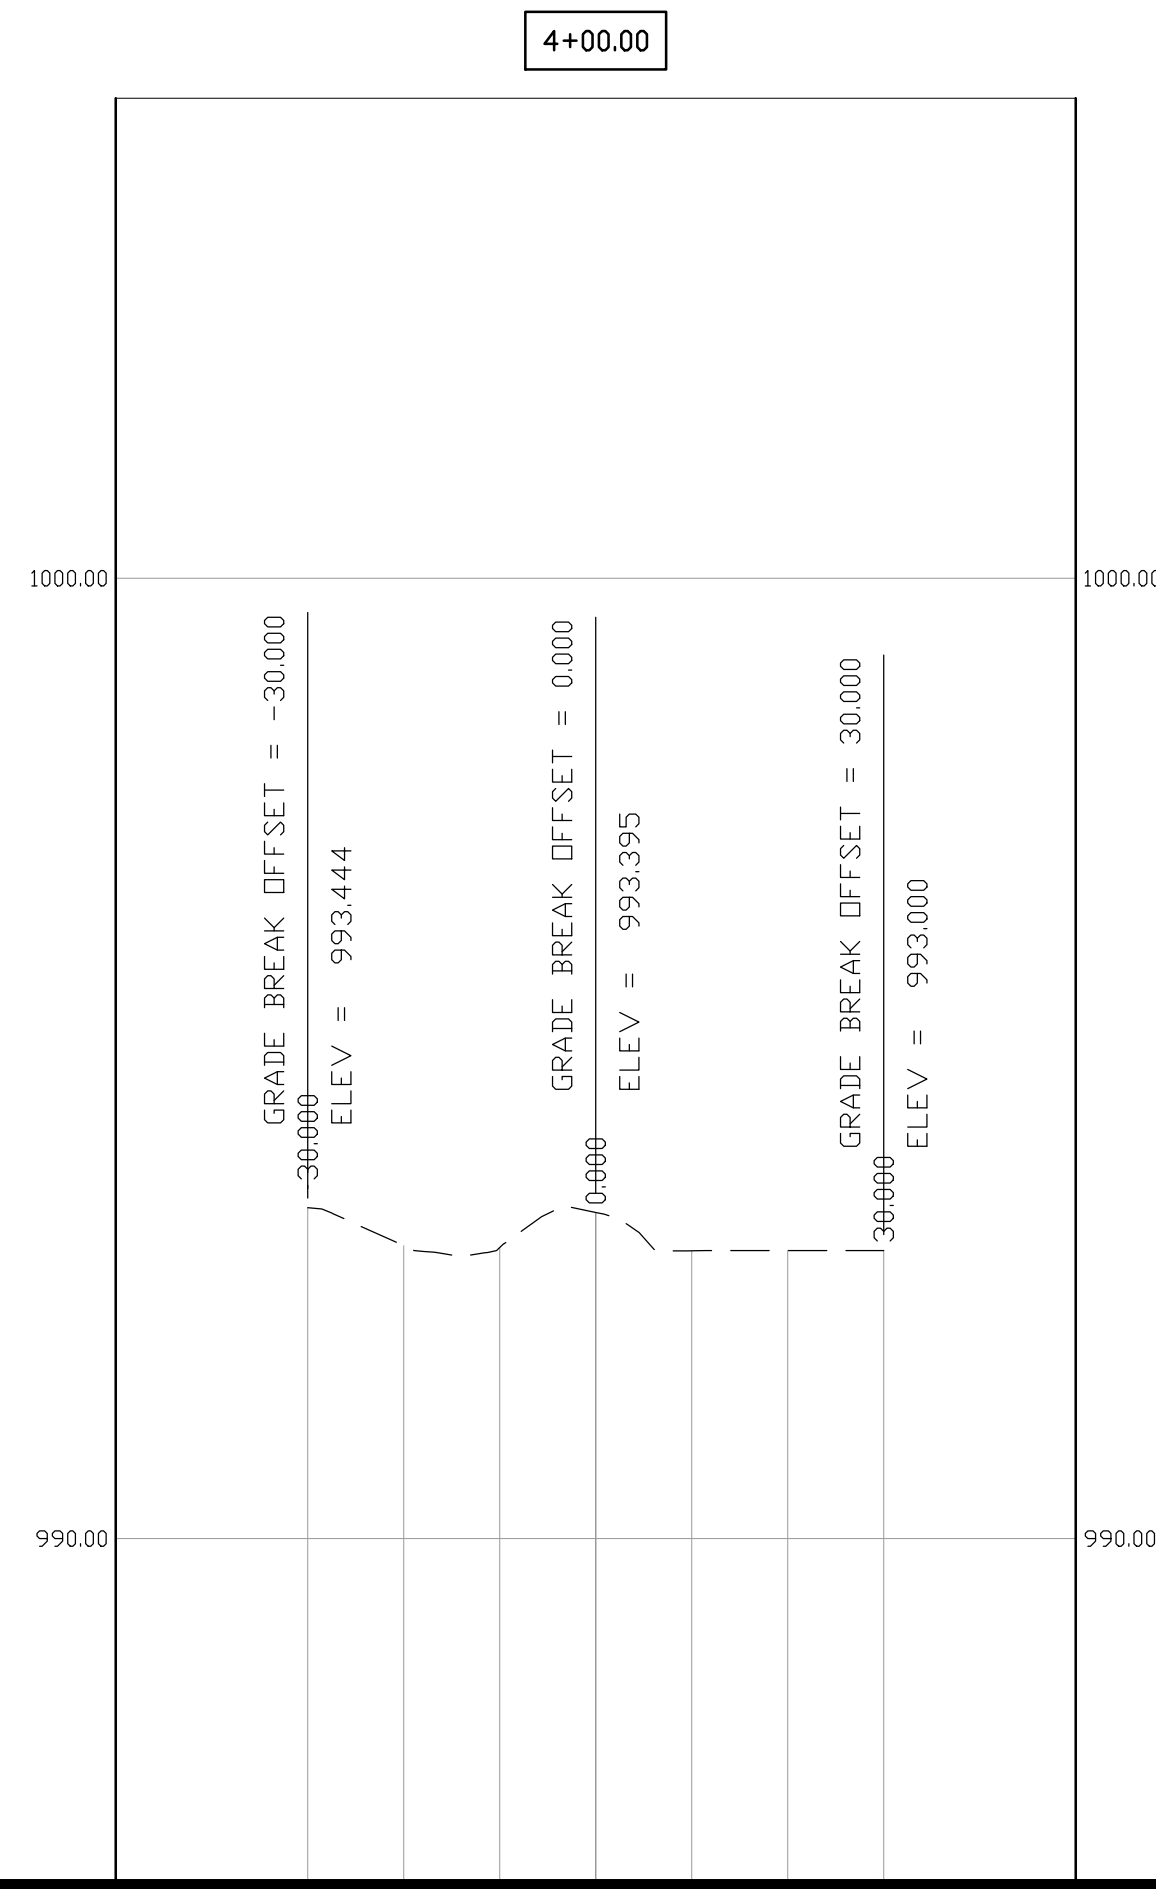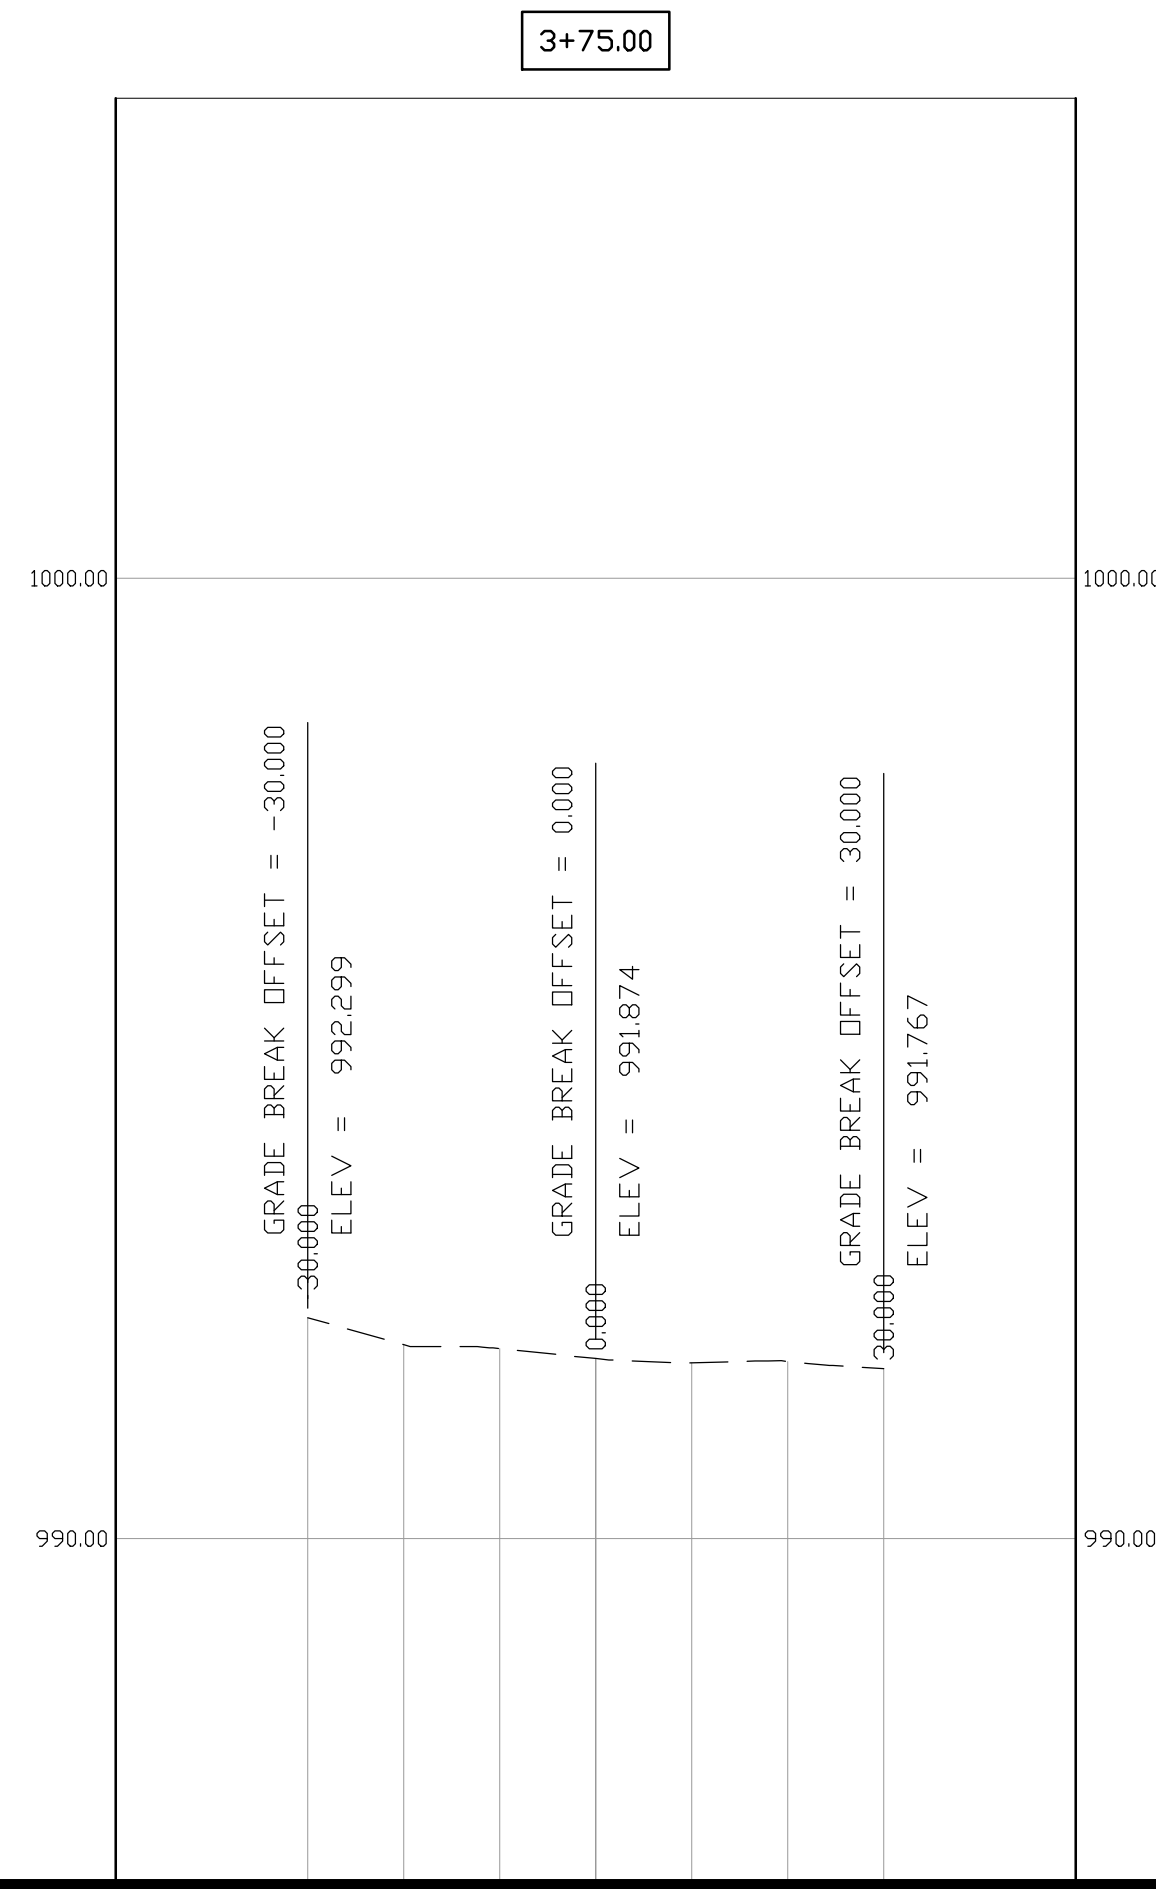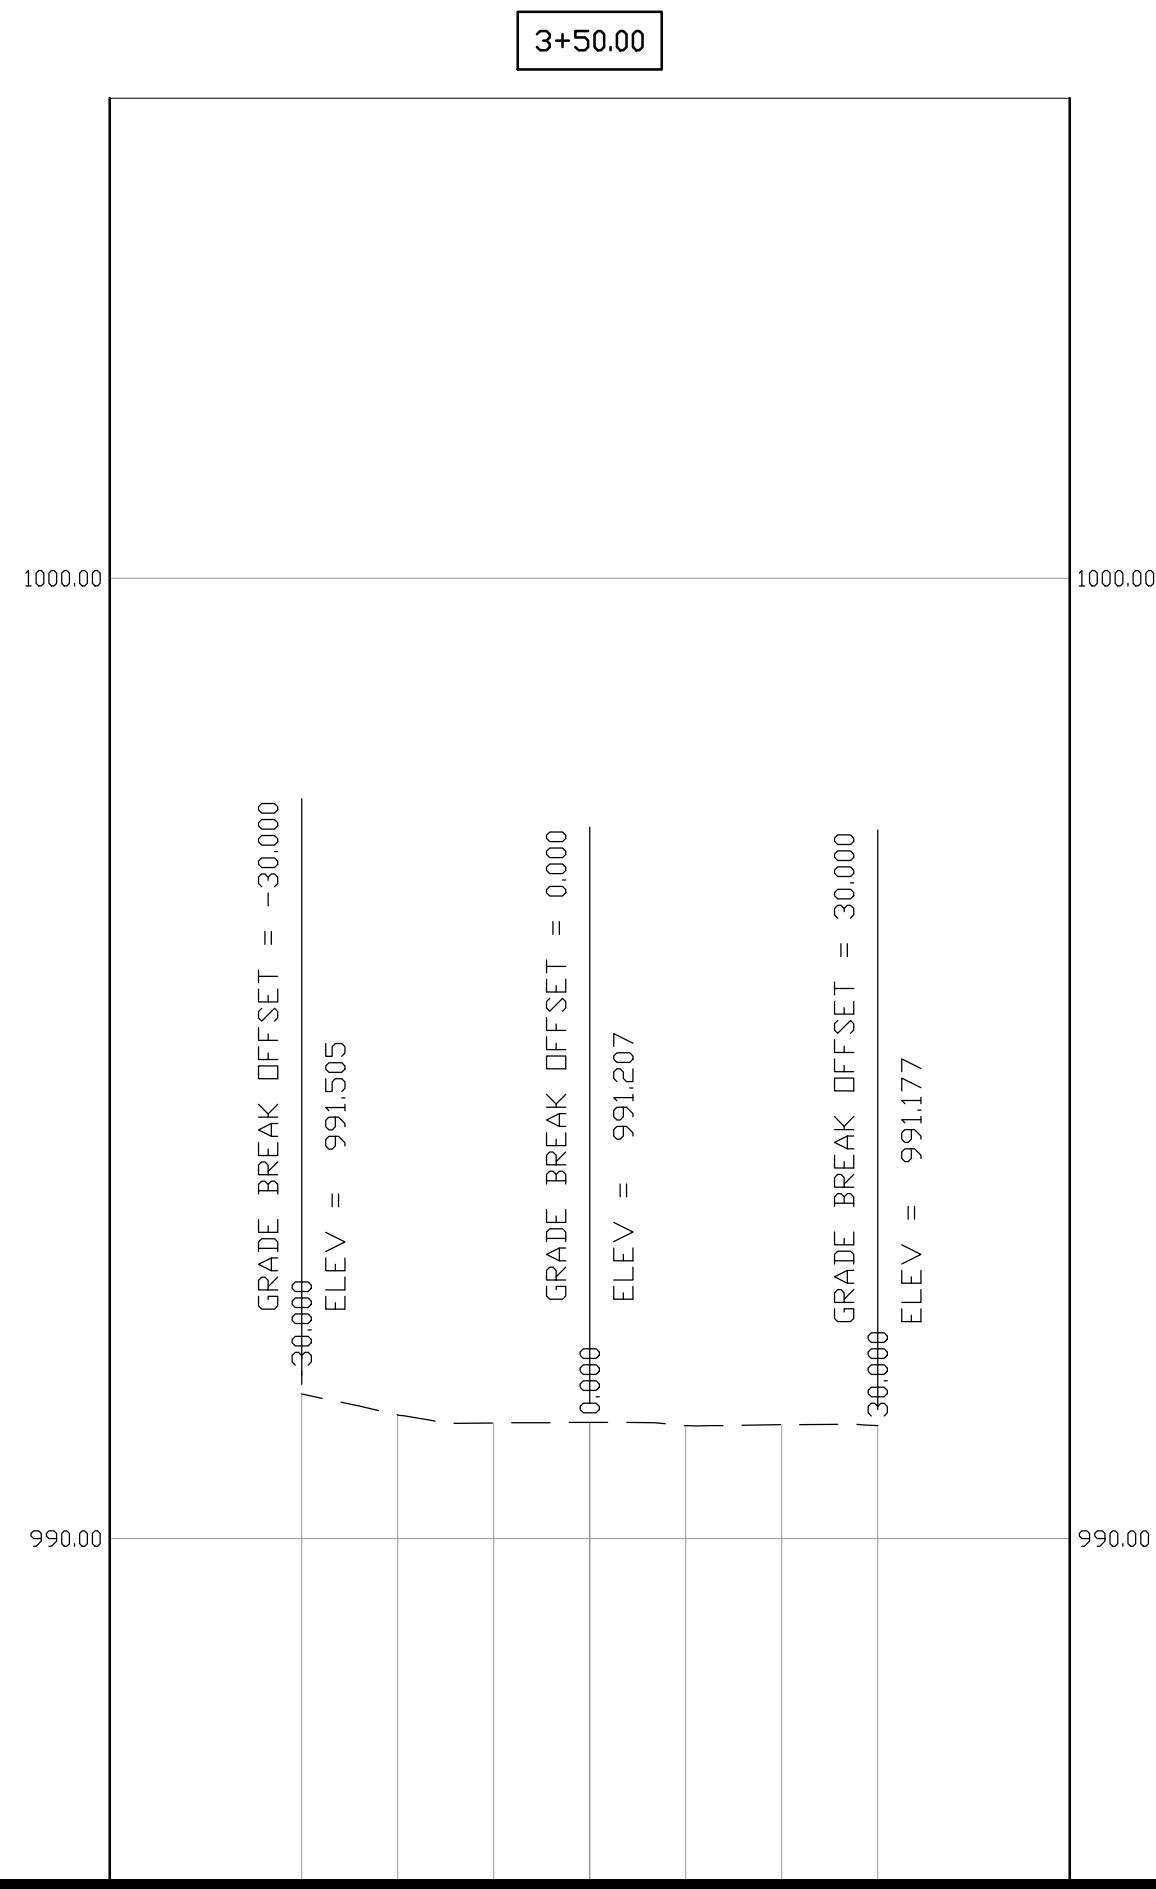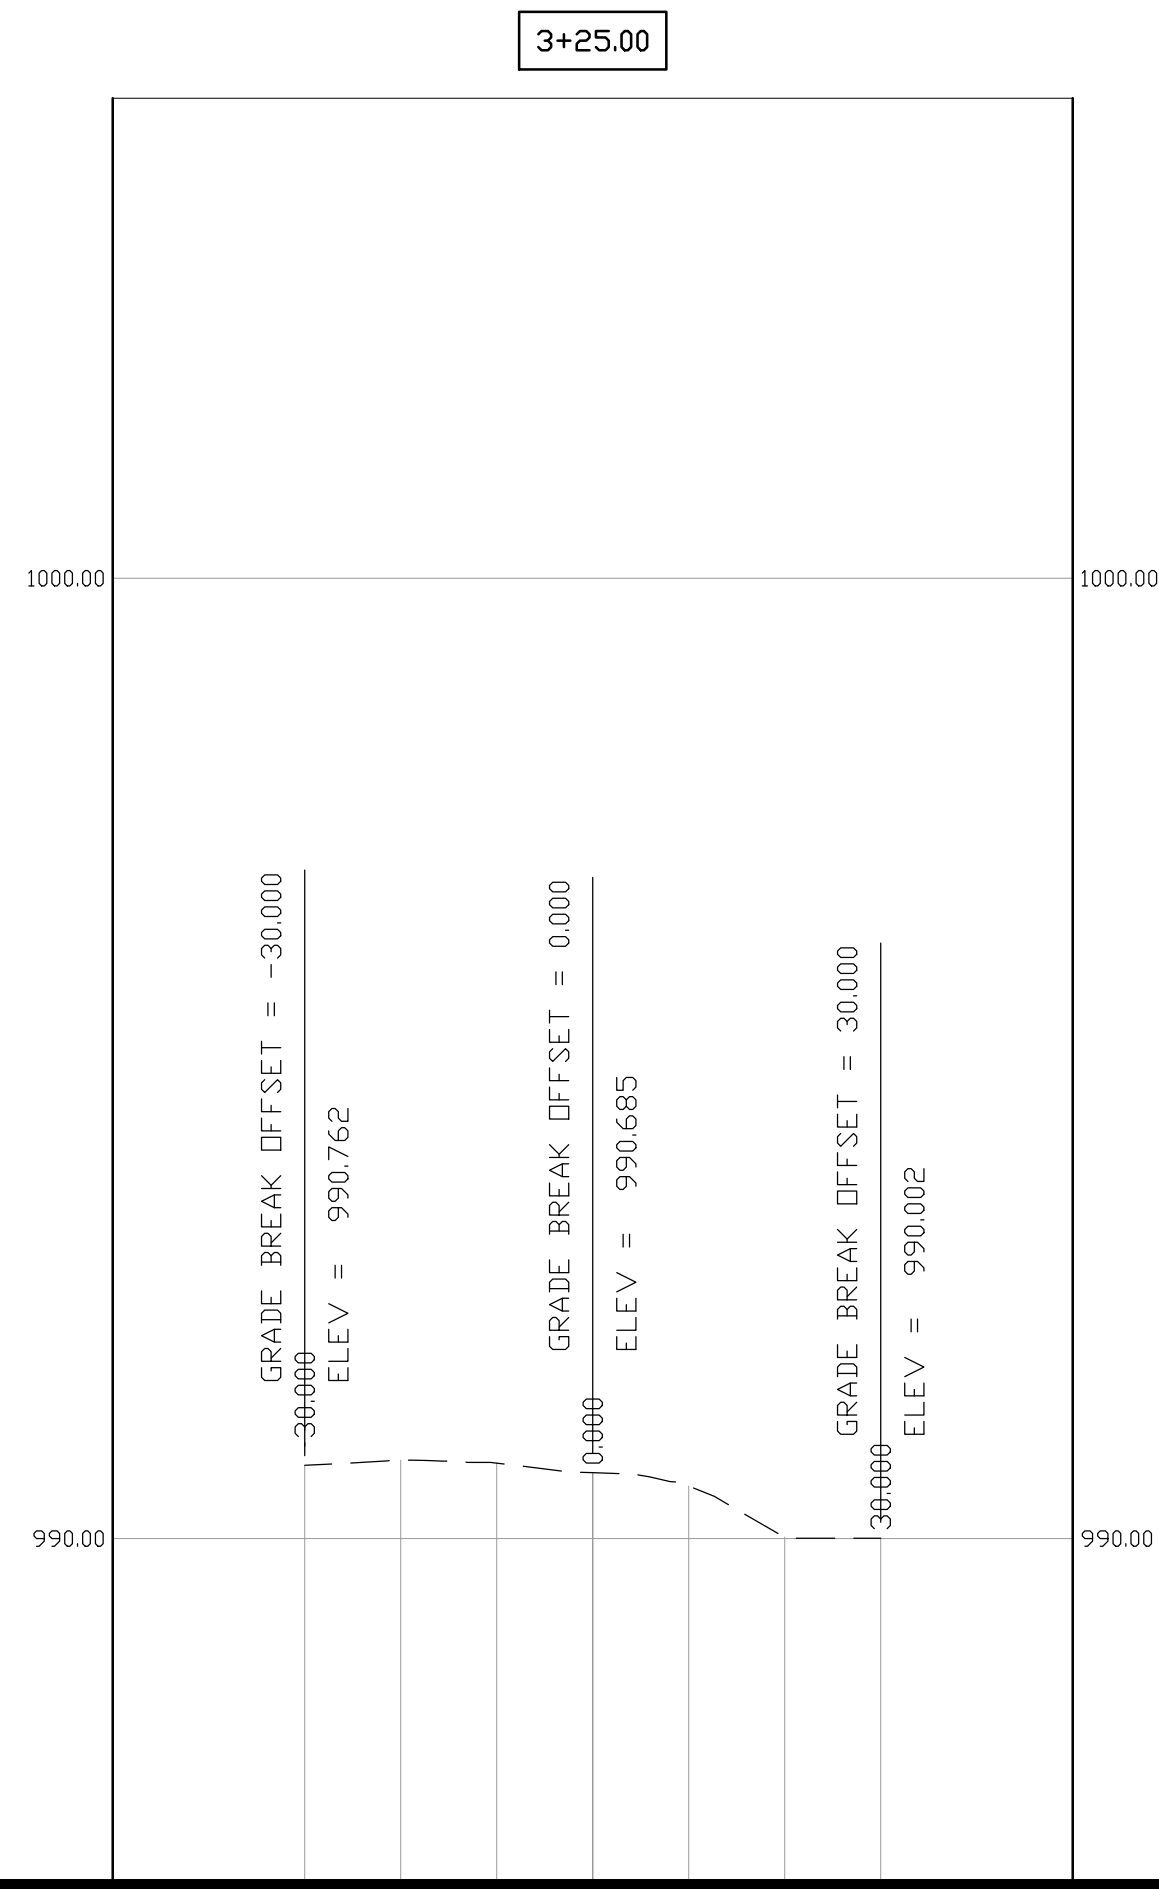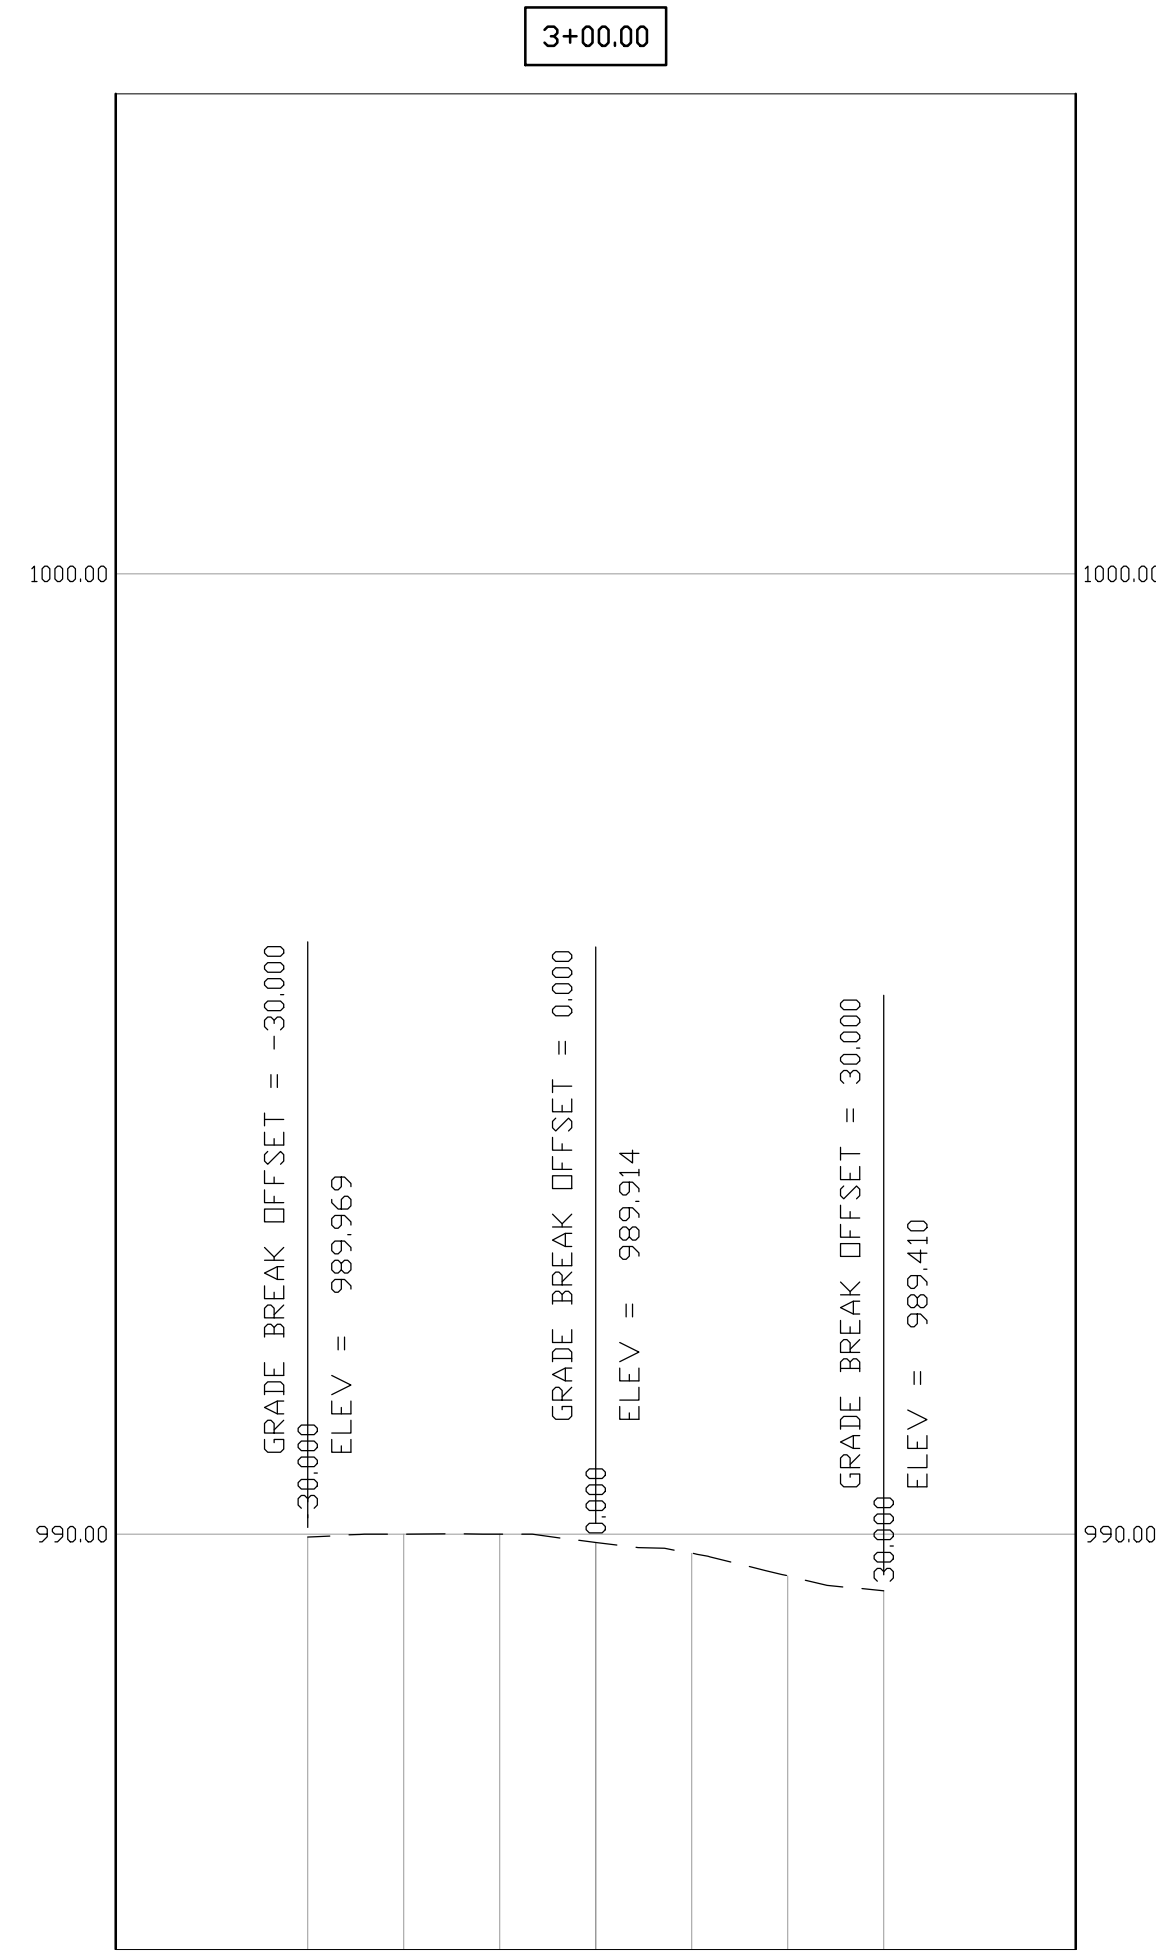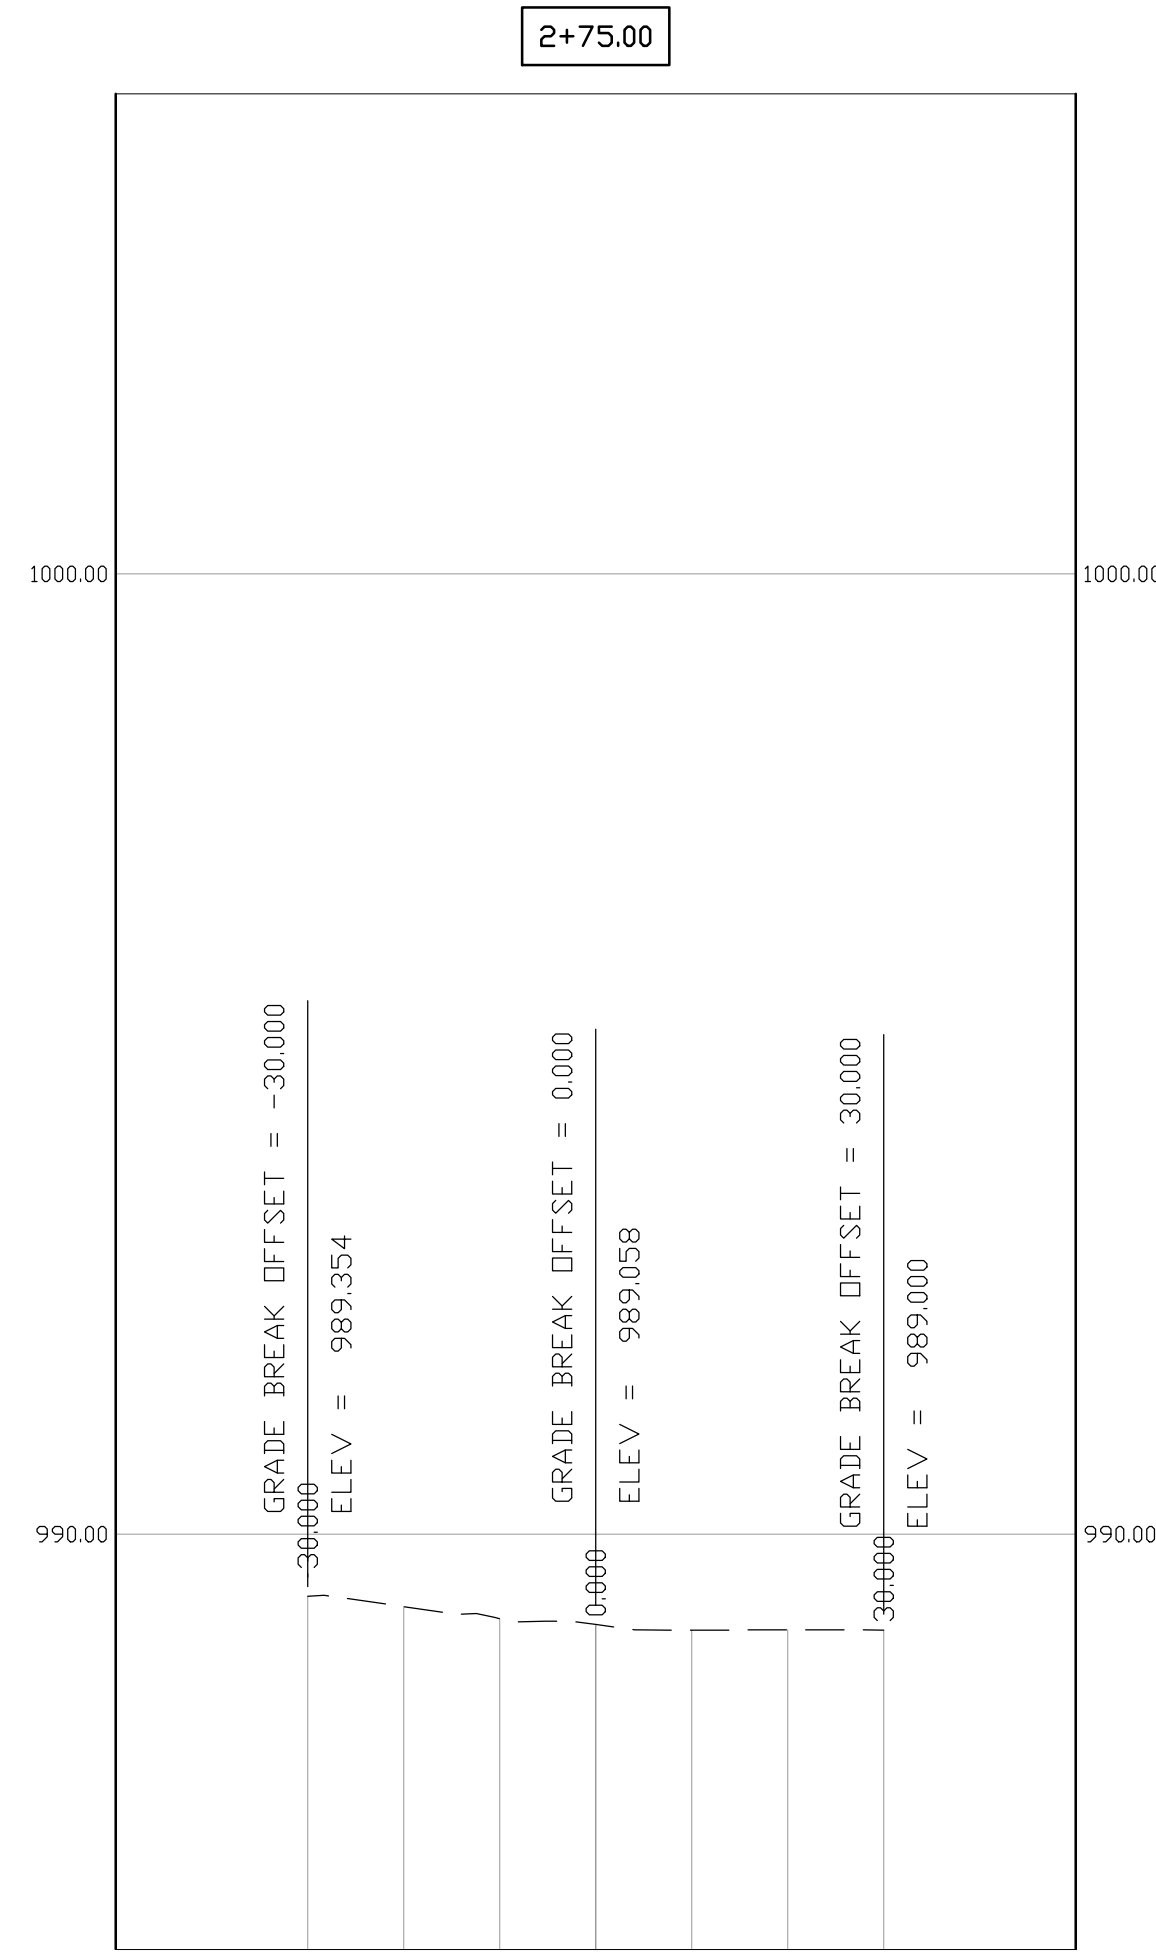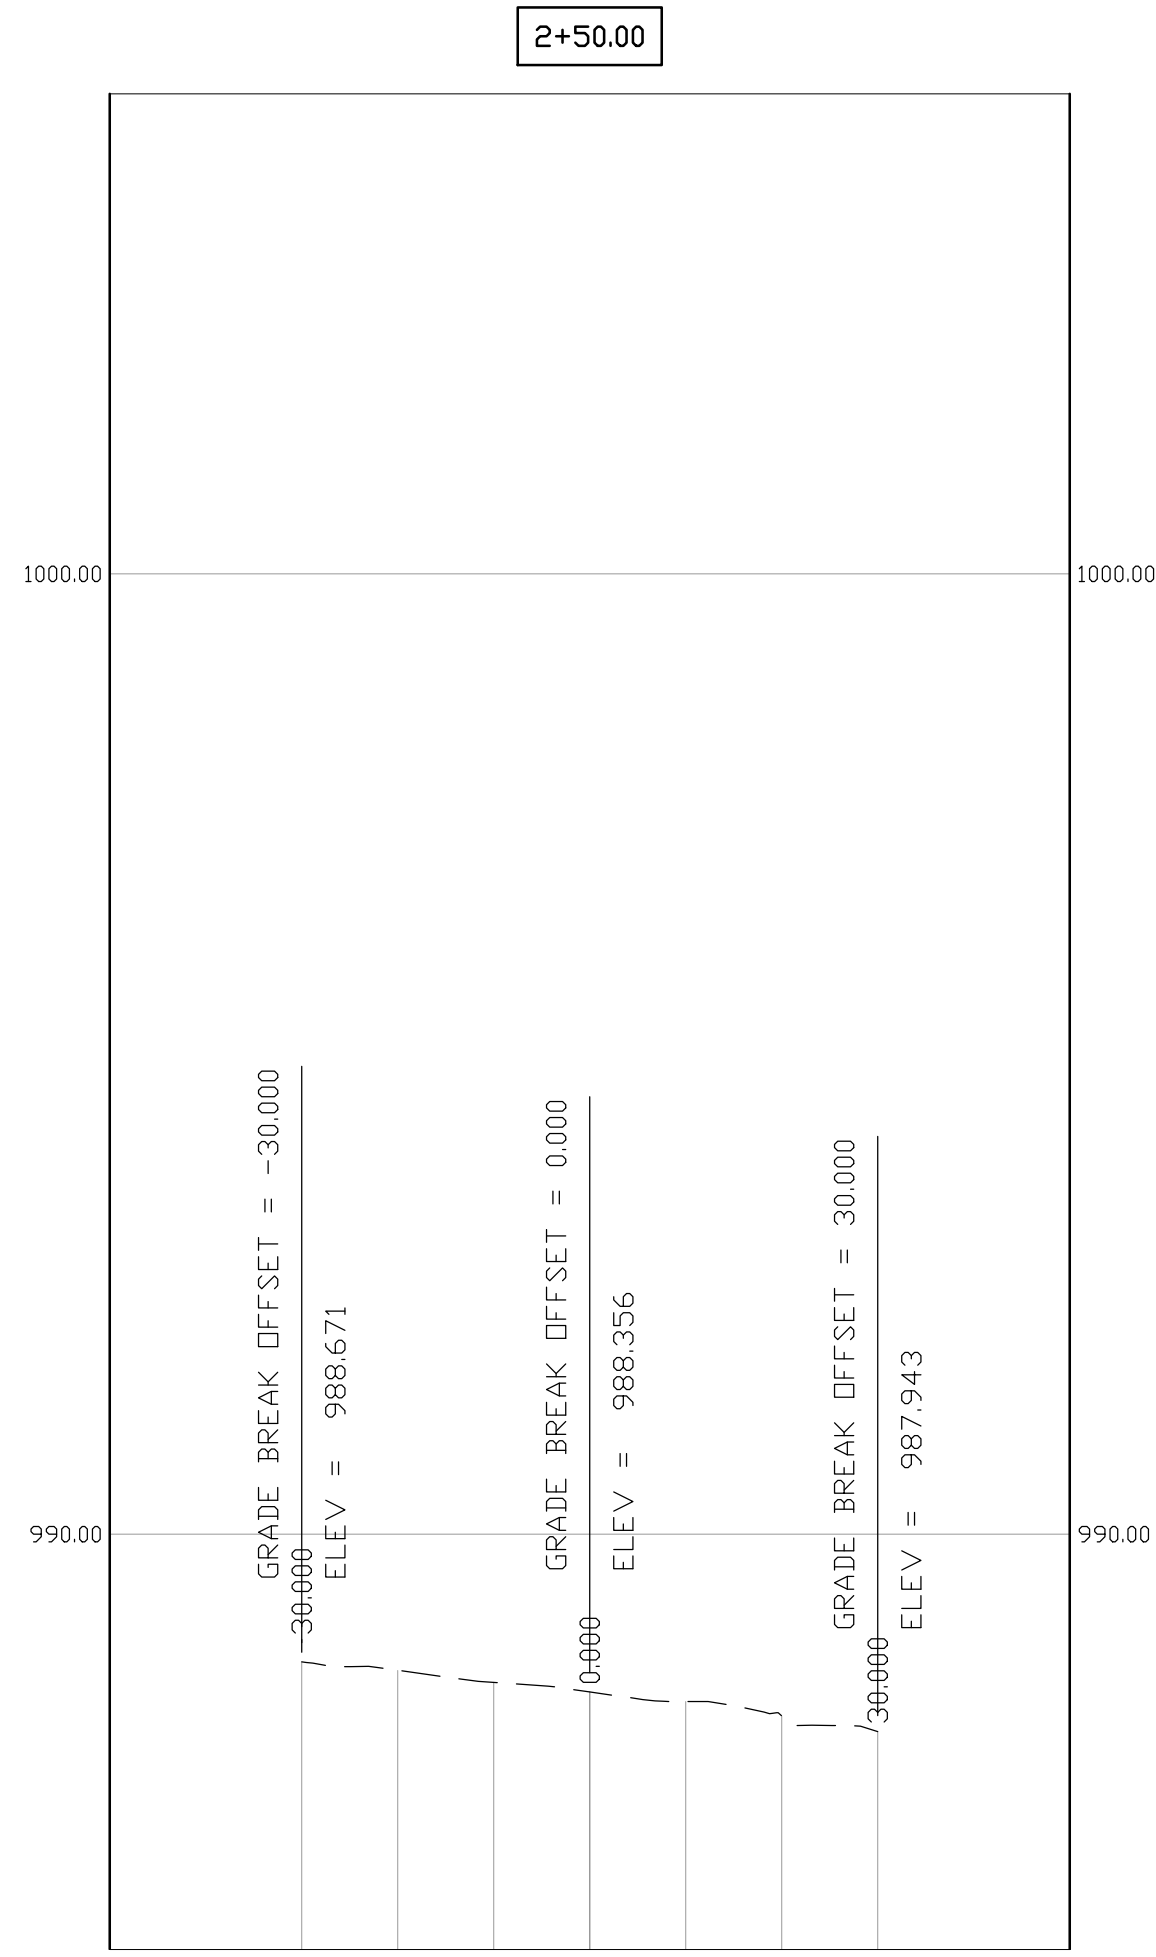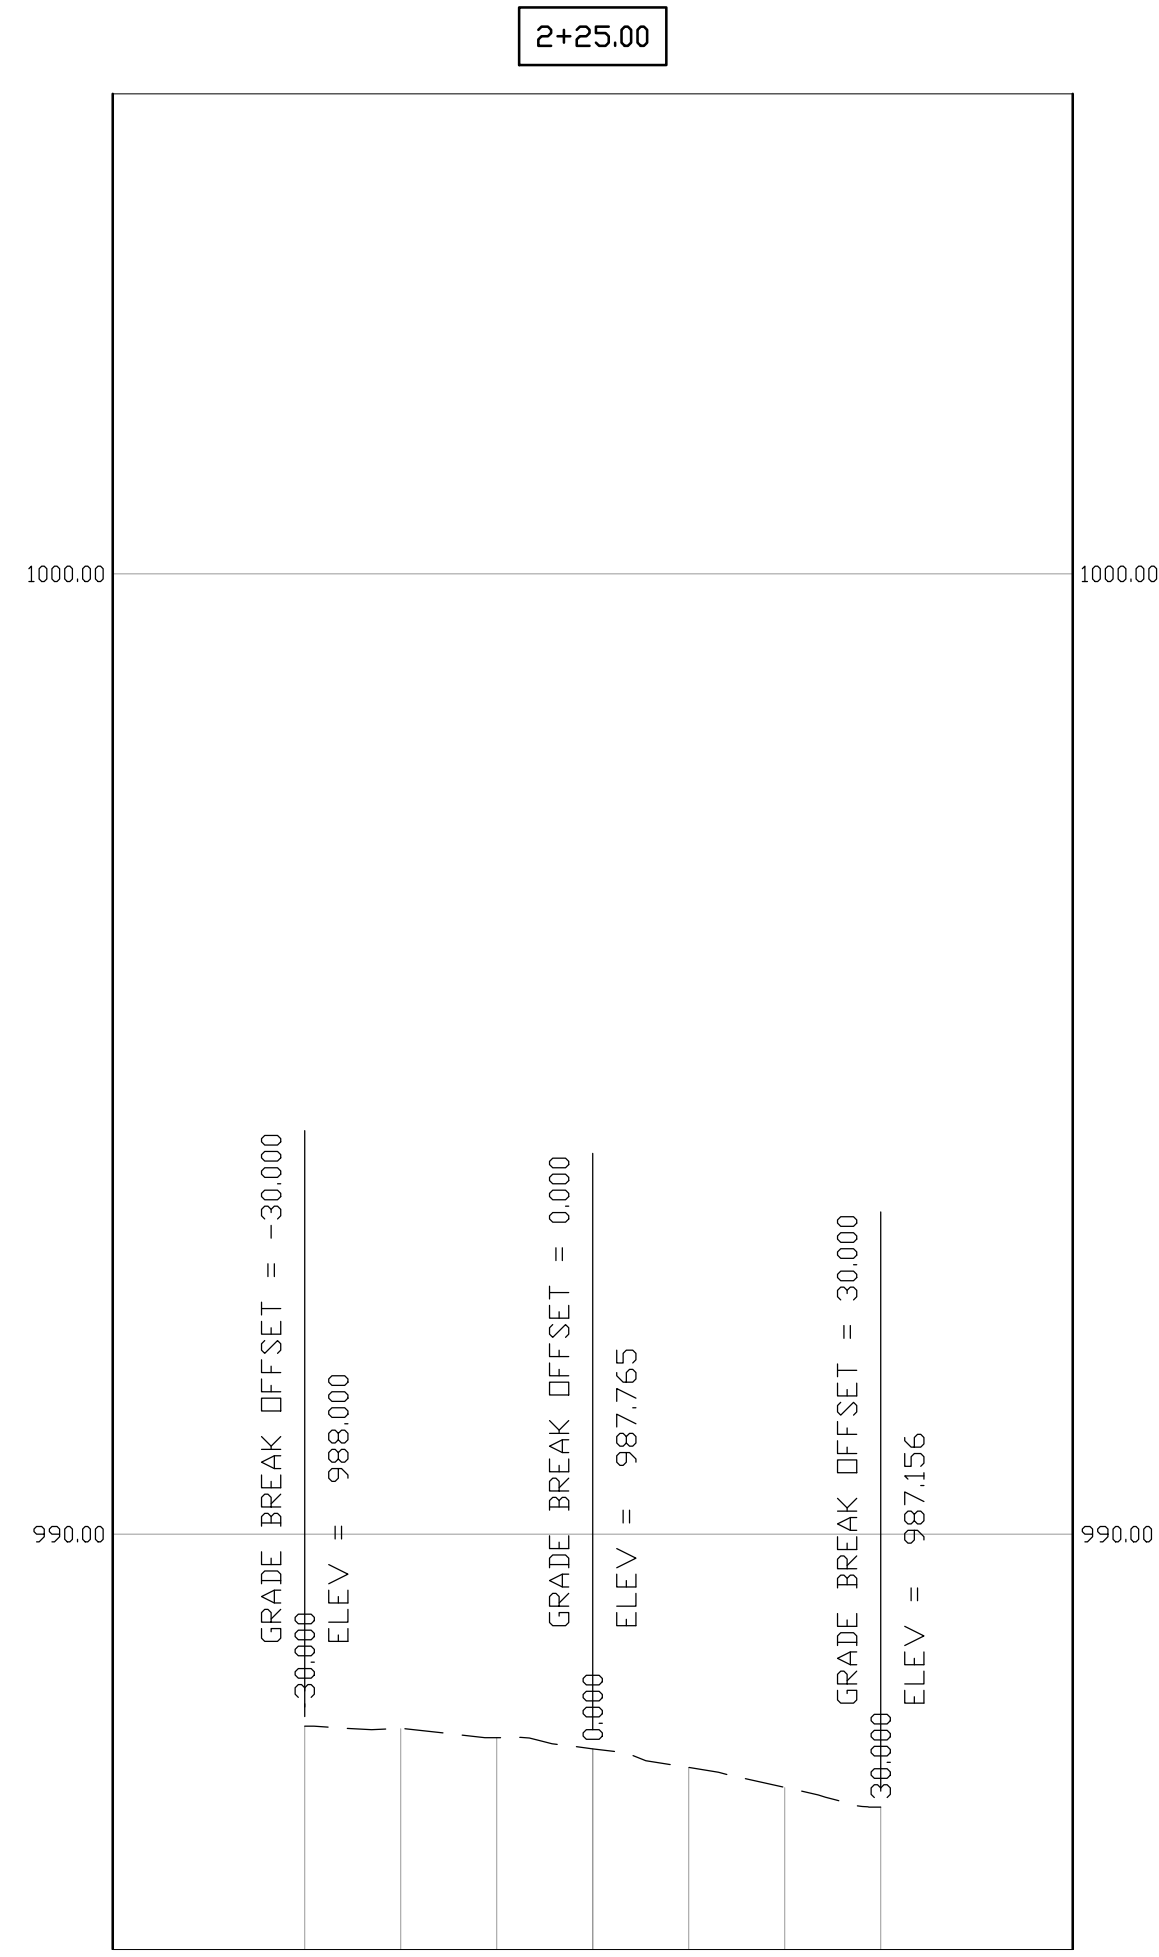

100% SUBMITTAL










CITY OF WOODCREEK
 DEERFIELD DRIVE
 WOODCREEK Texas, 78676

REVISION	
NO.	DATE

PROJECT #
 ISSUE:
 DATE:
 DRAWN BY:

EXIST. CROSS SECTIONS

C6.03
 2 OF 4

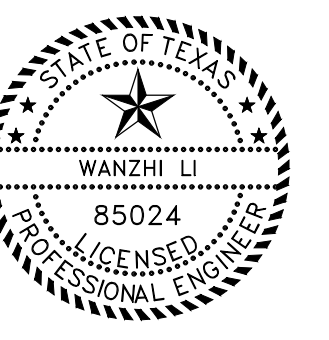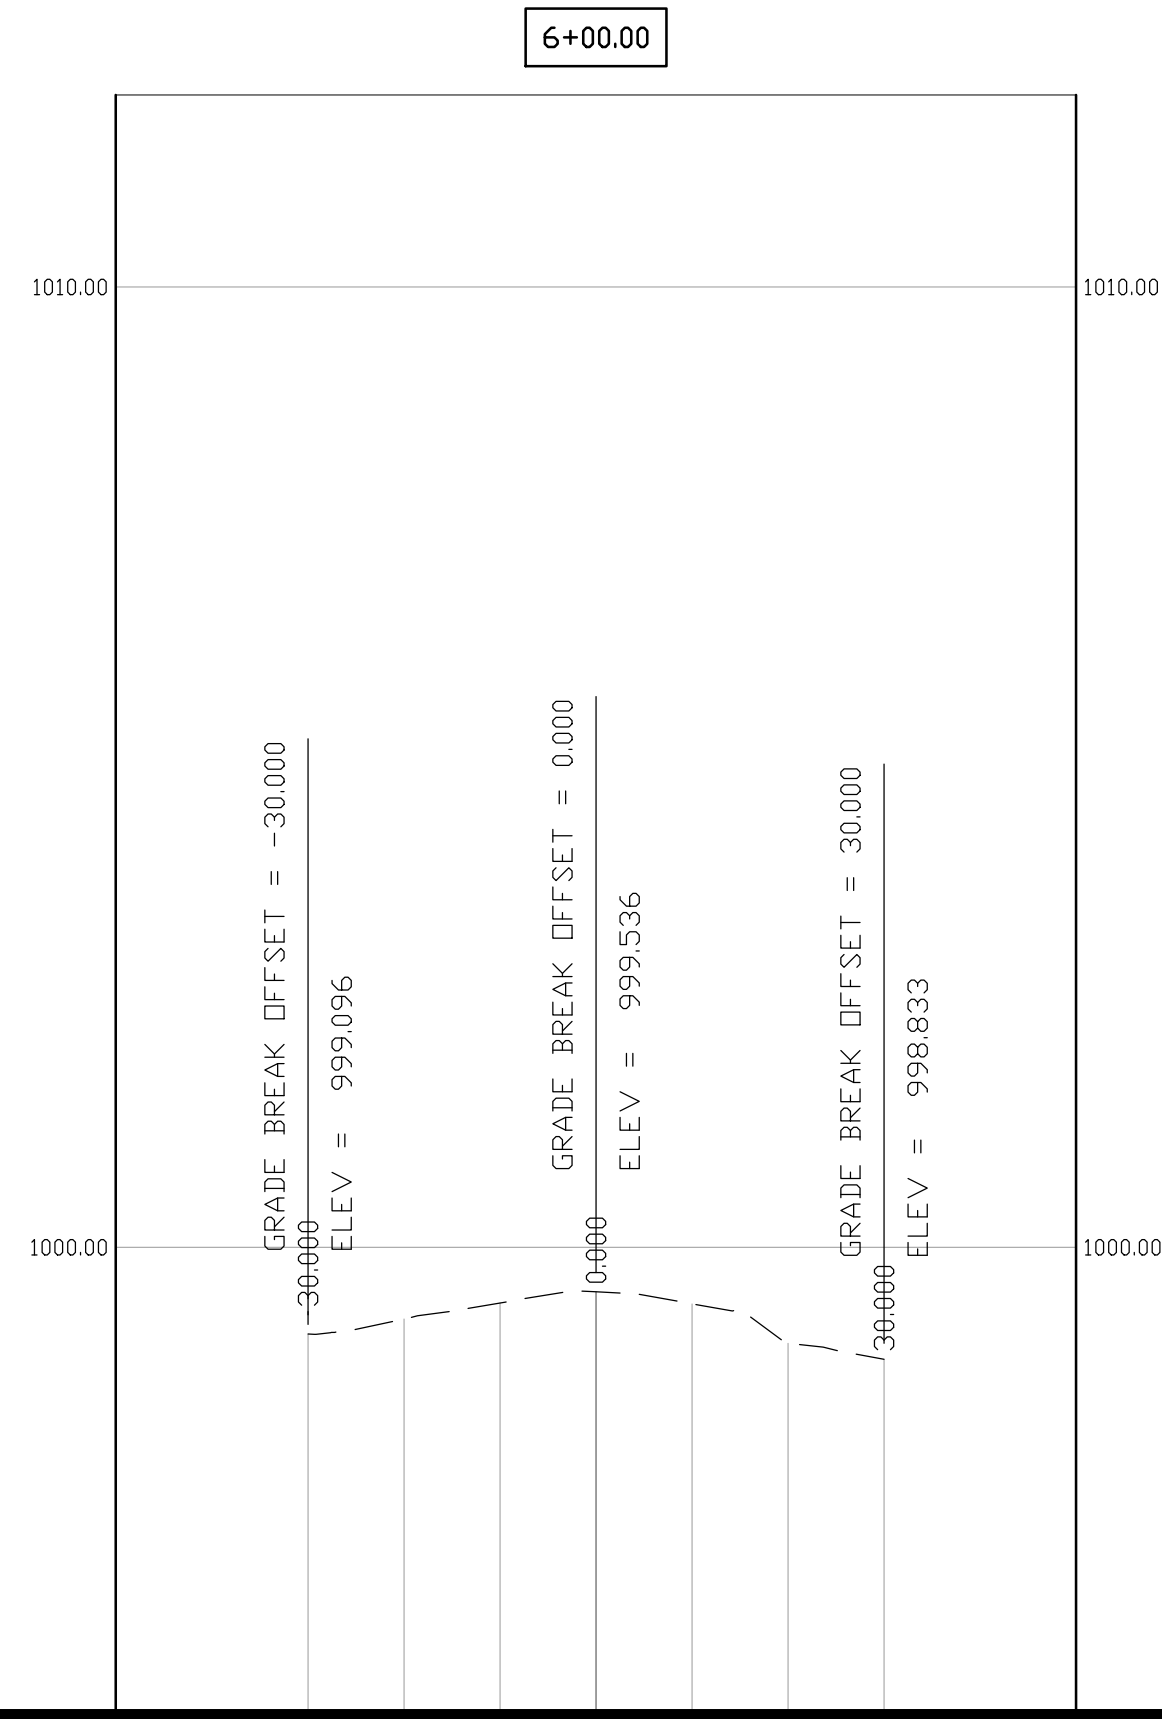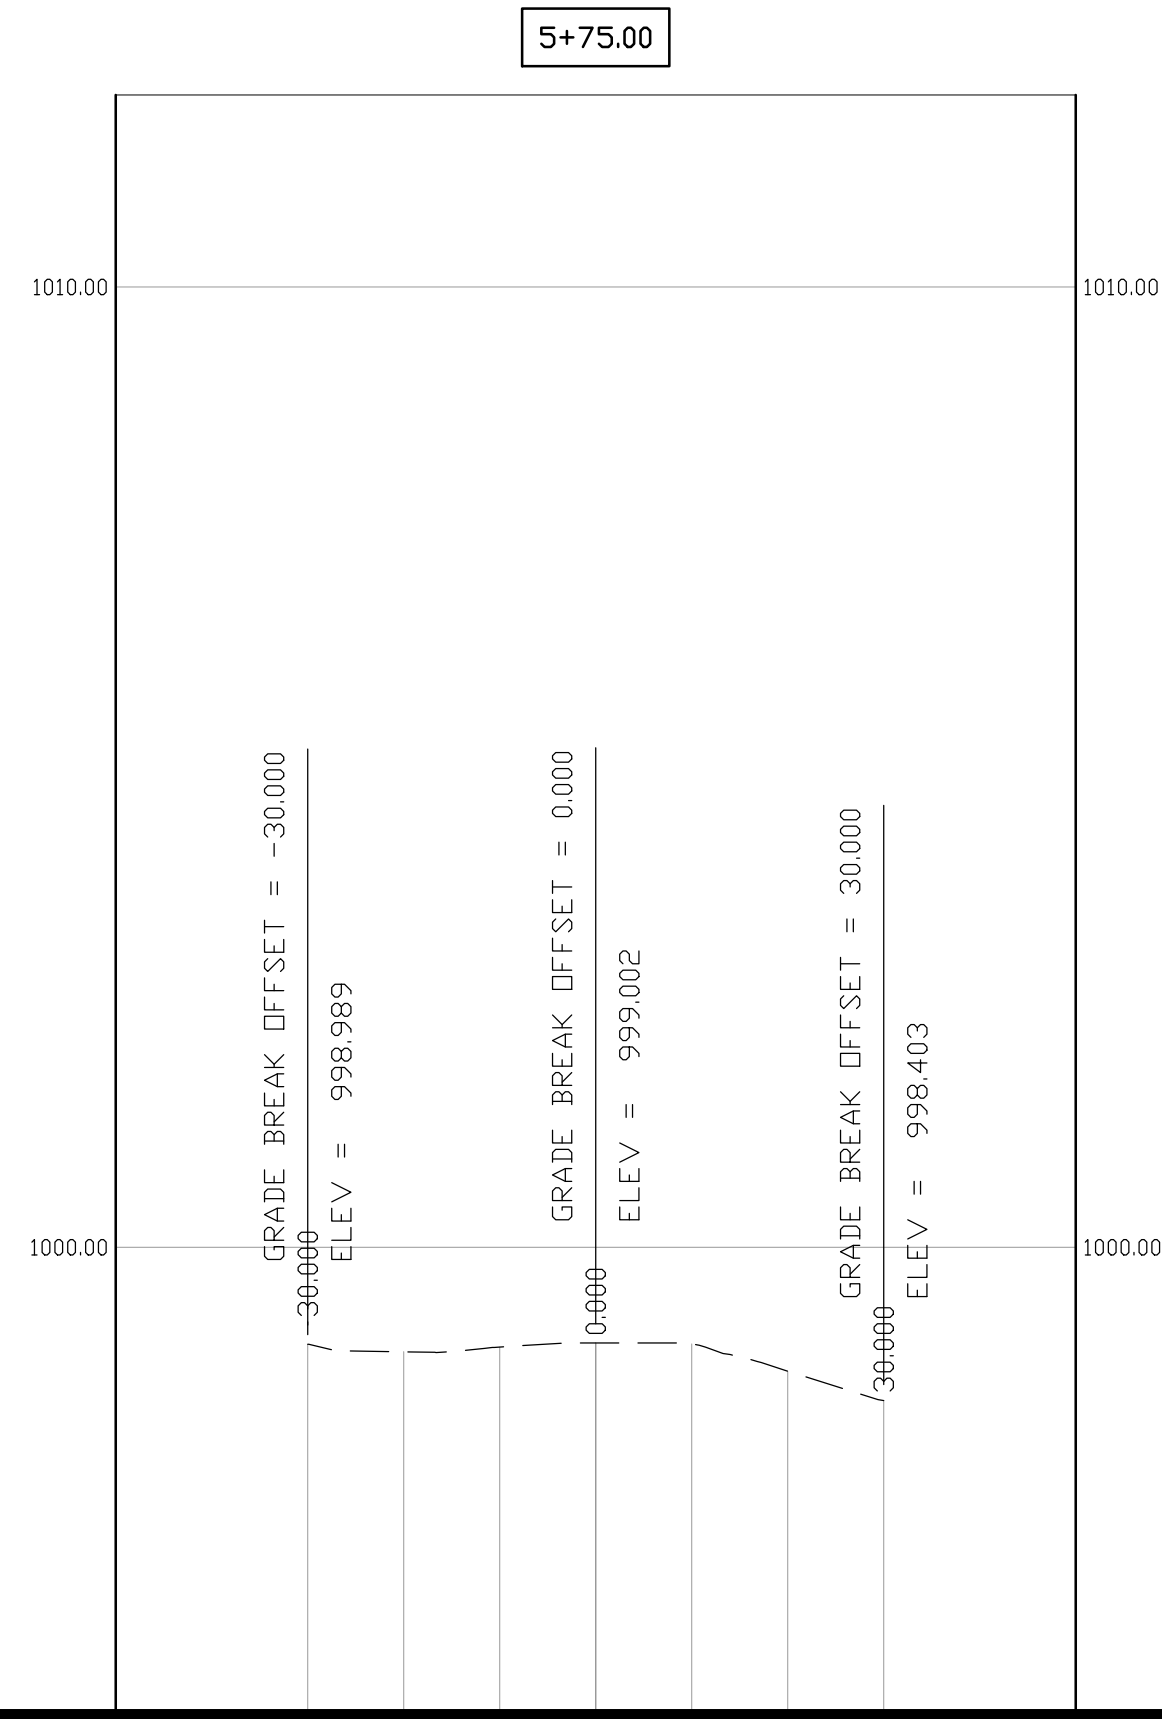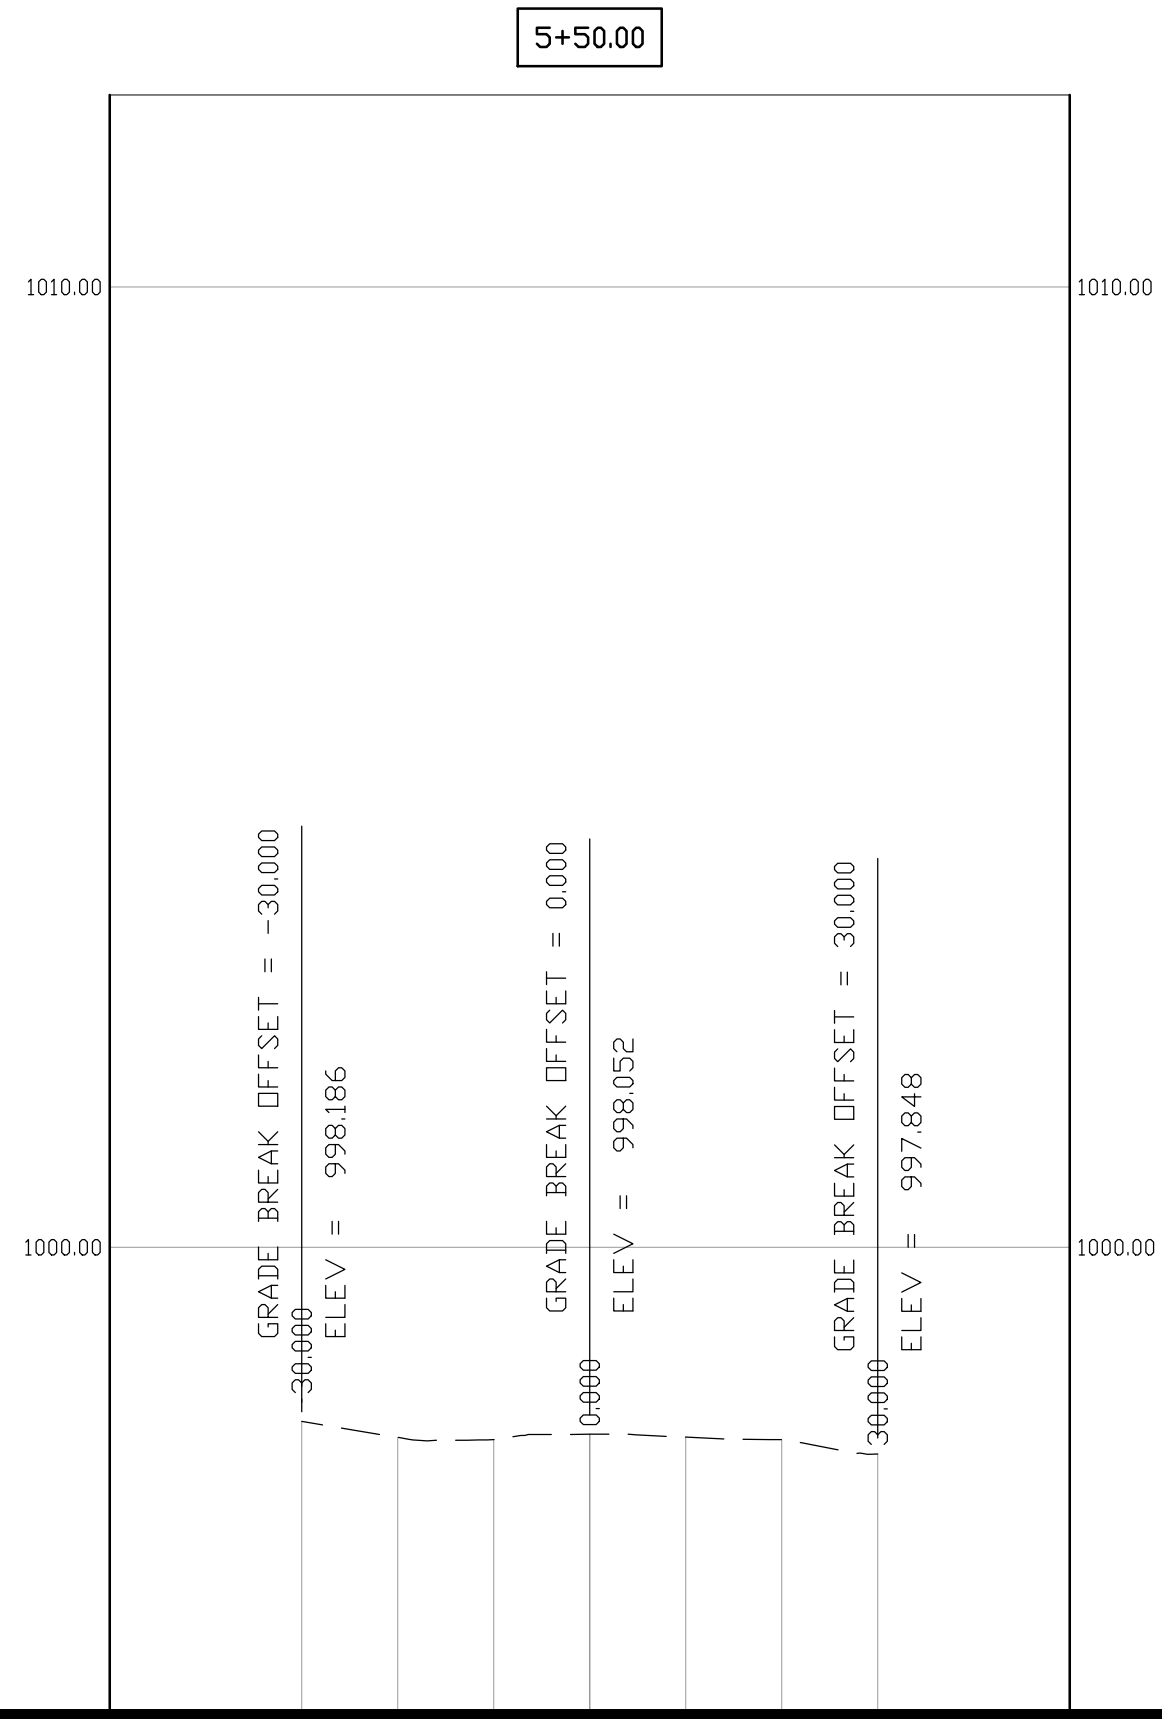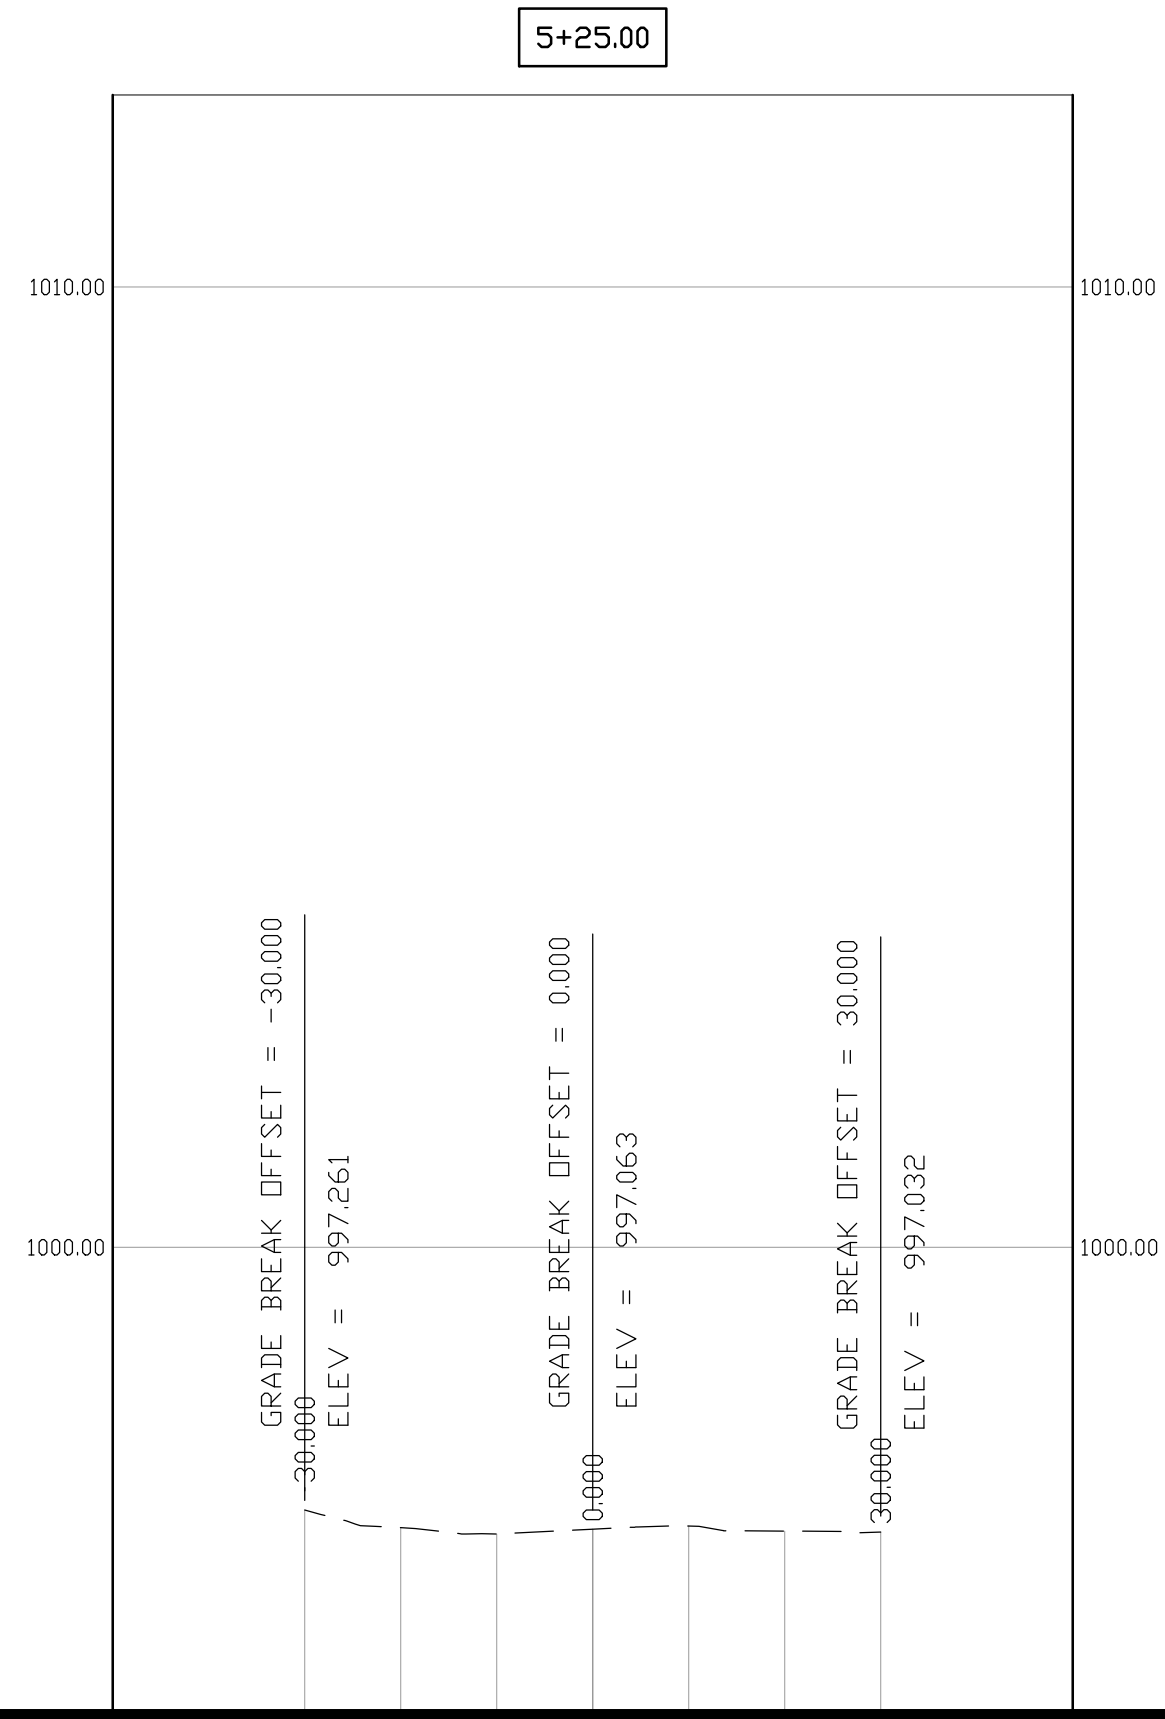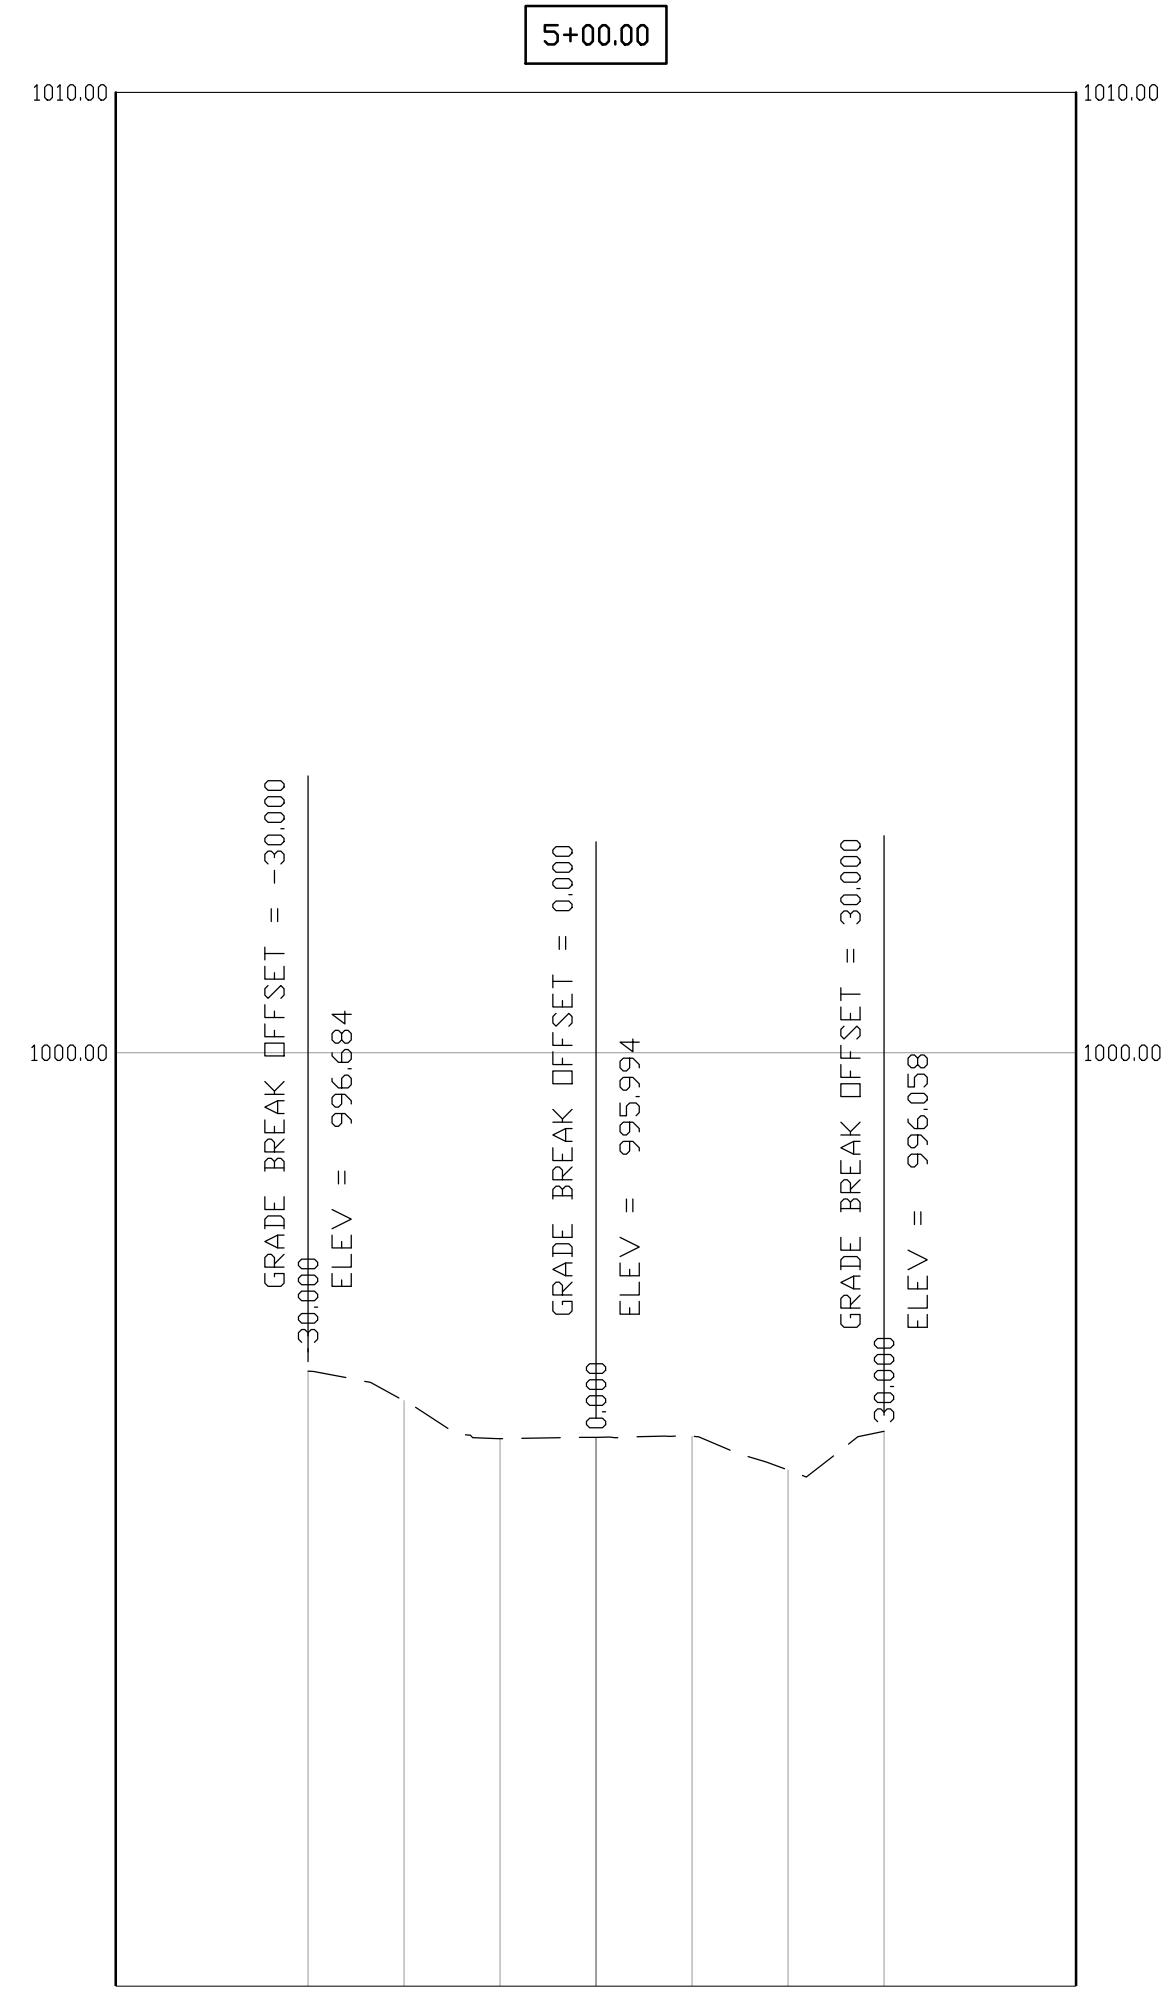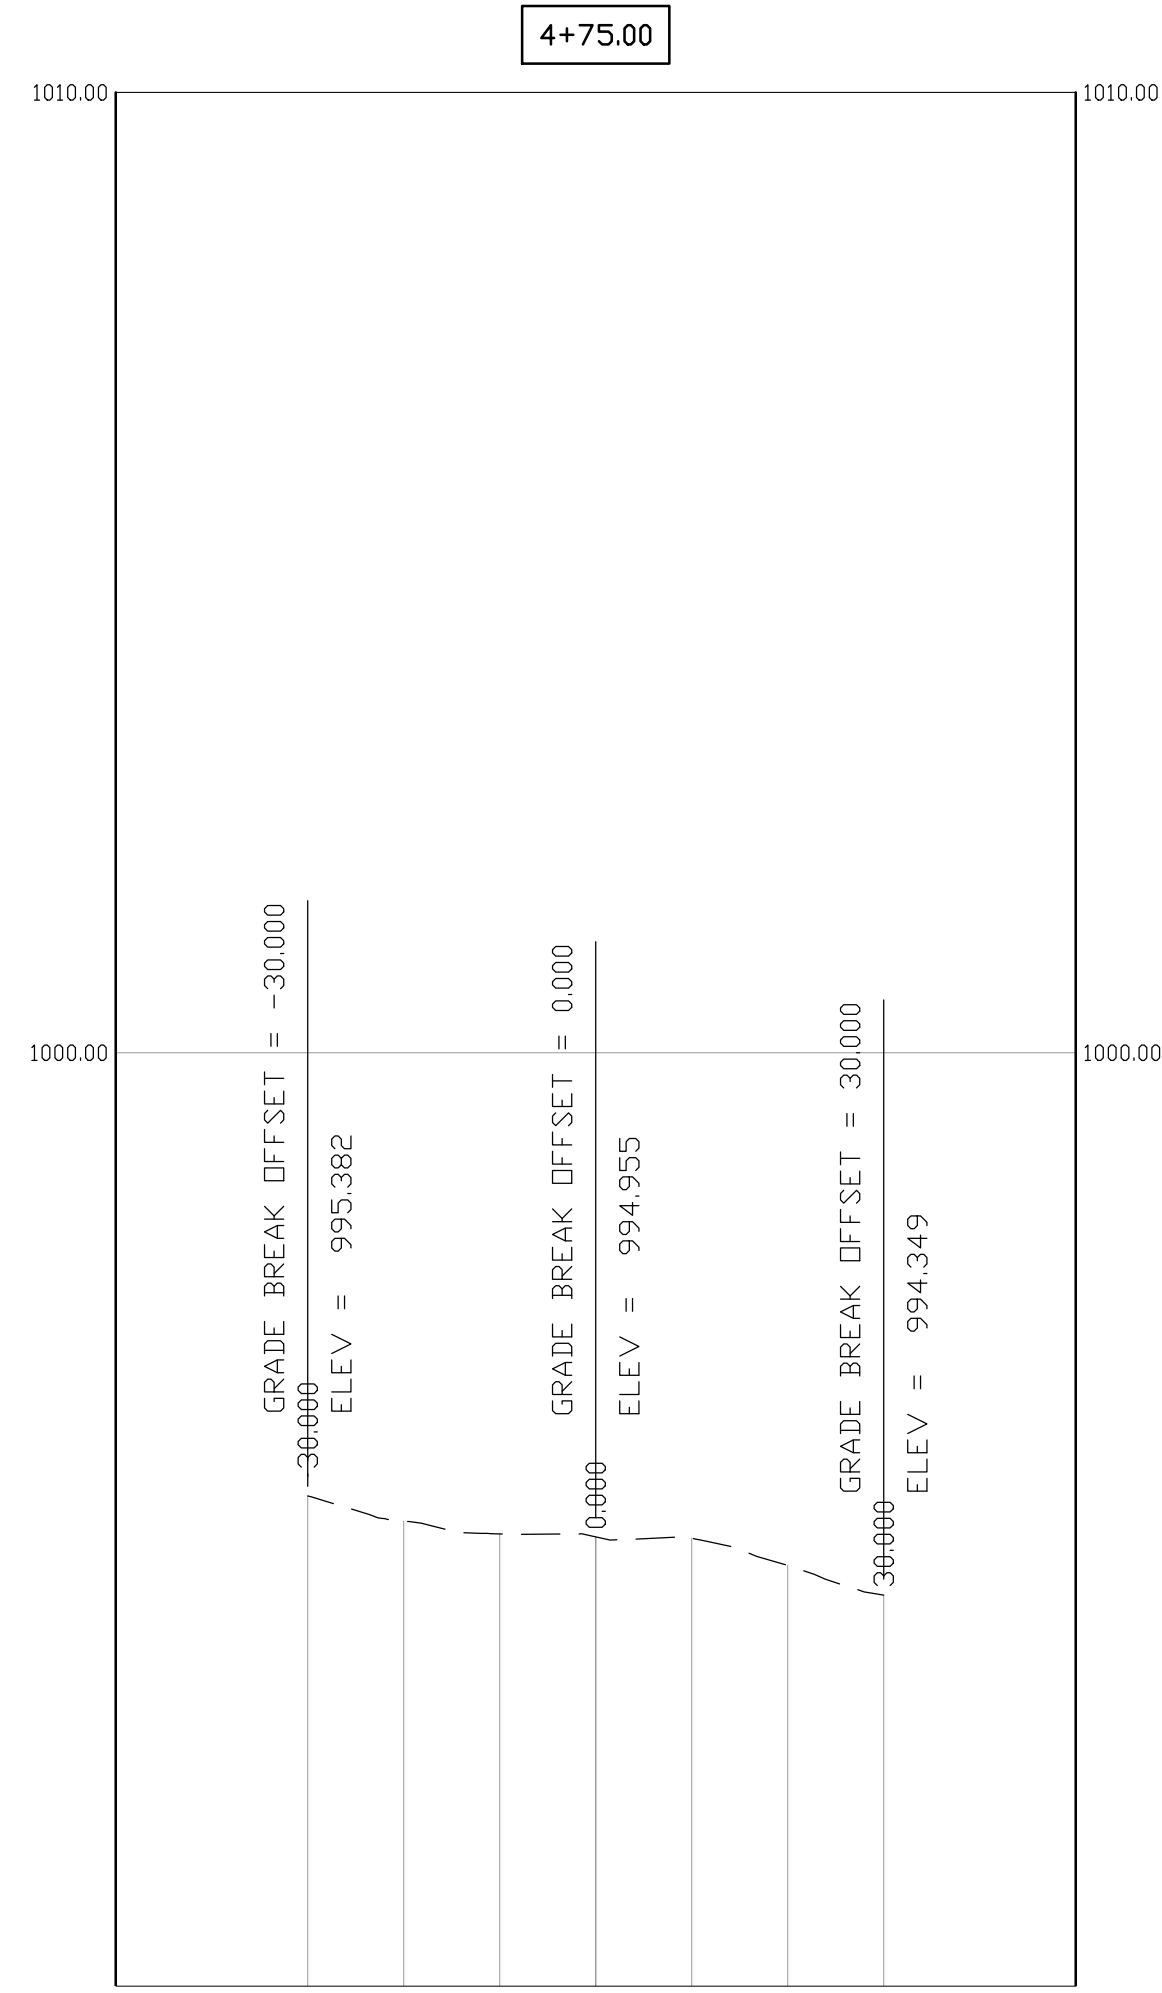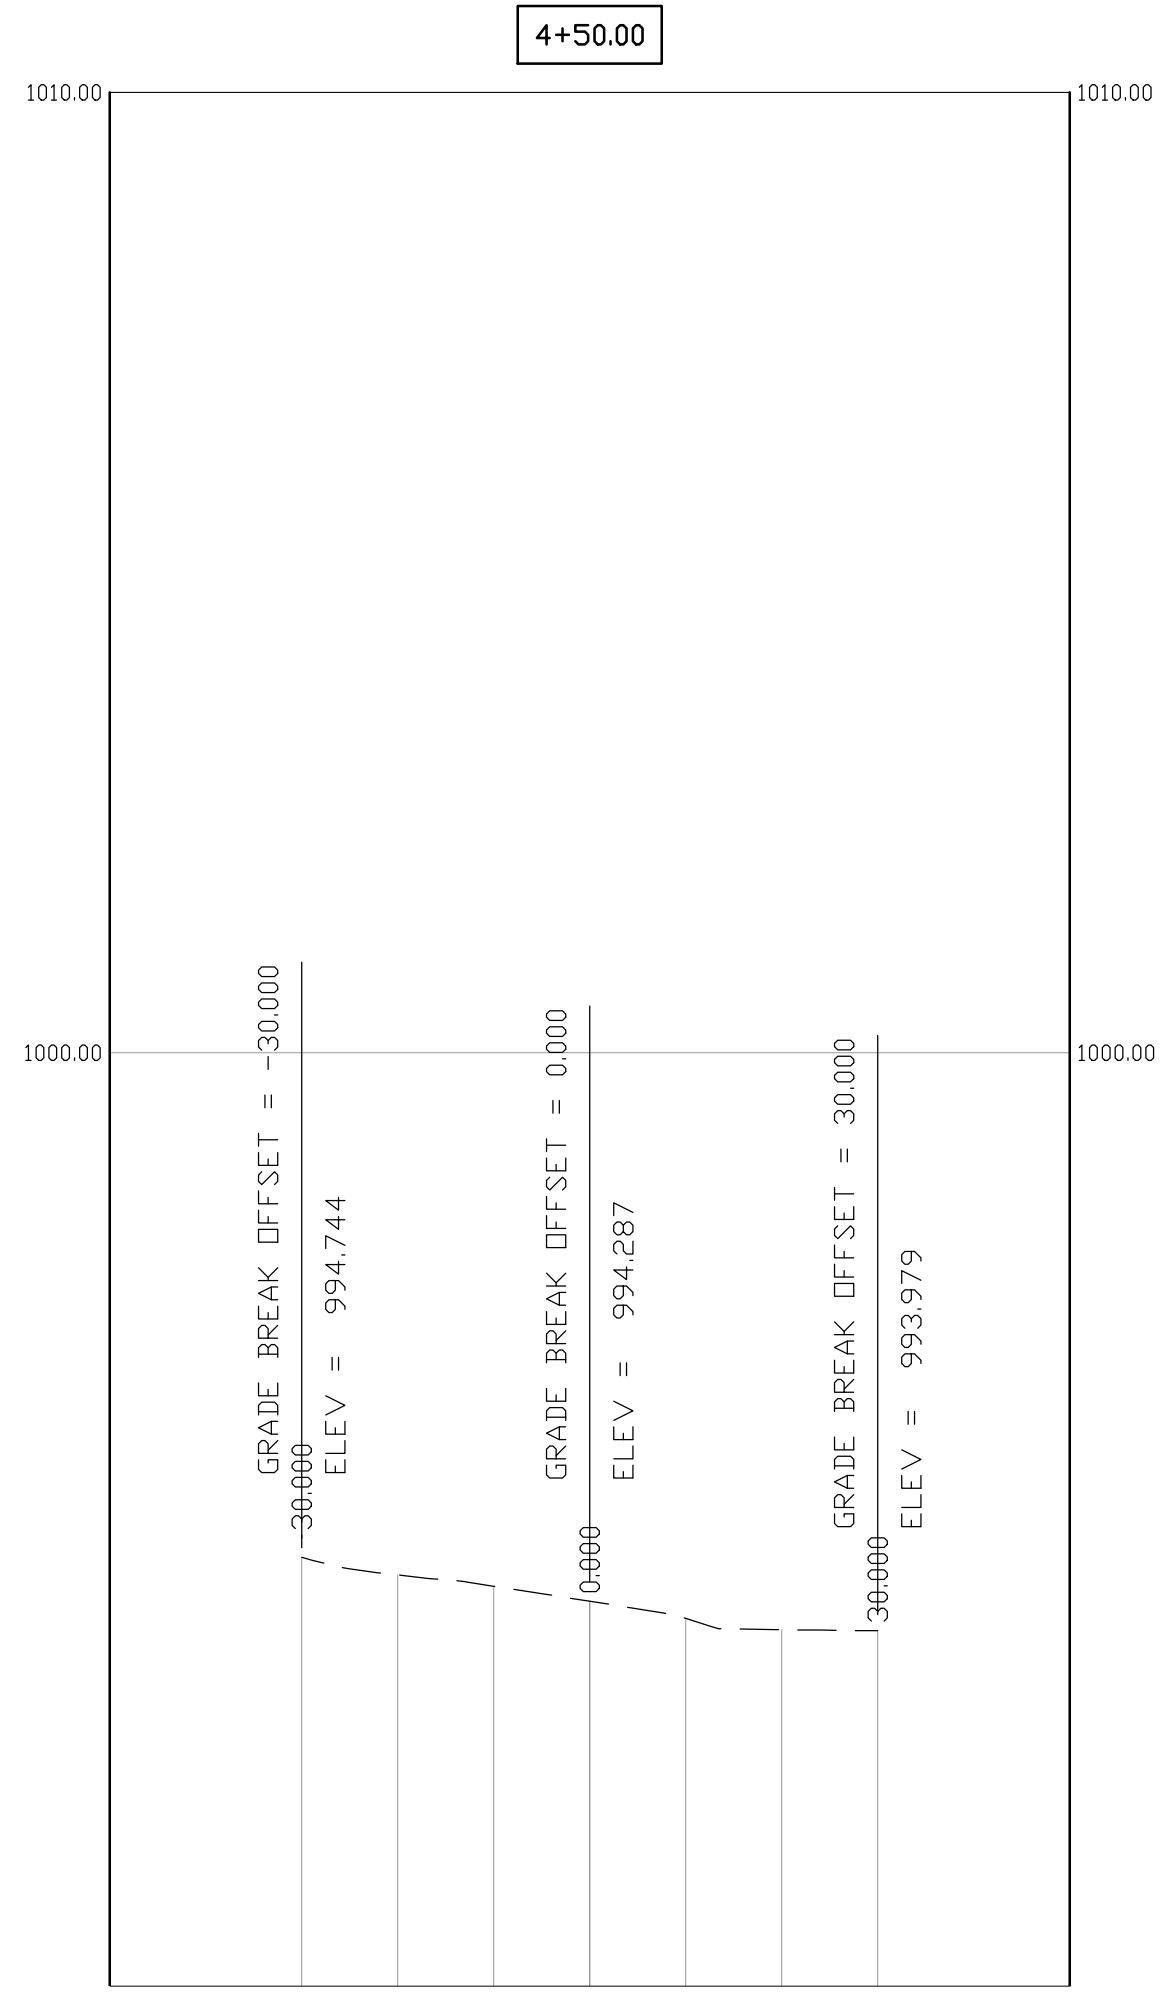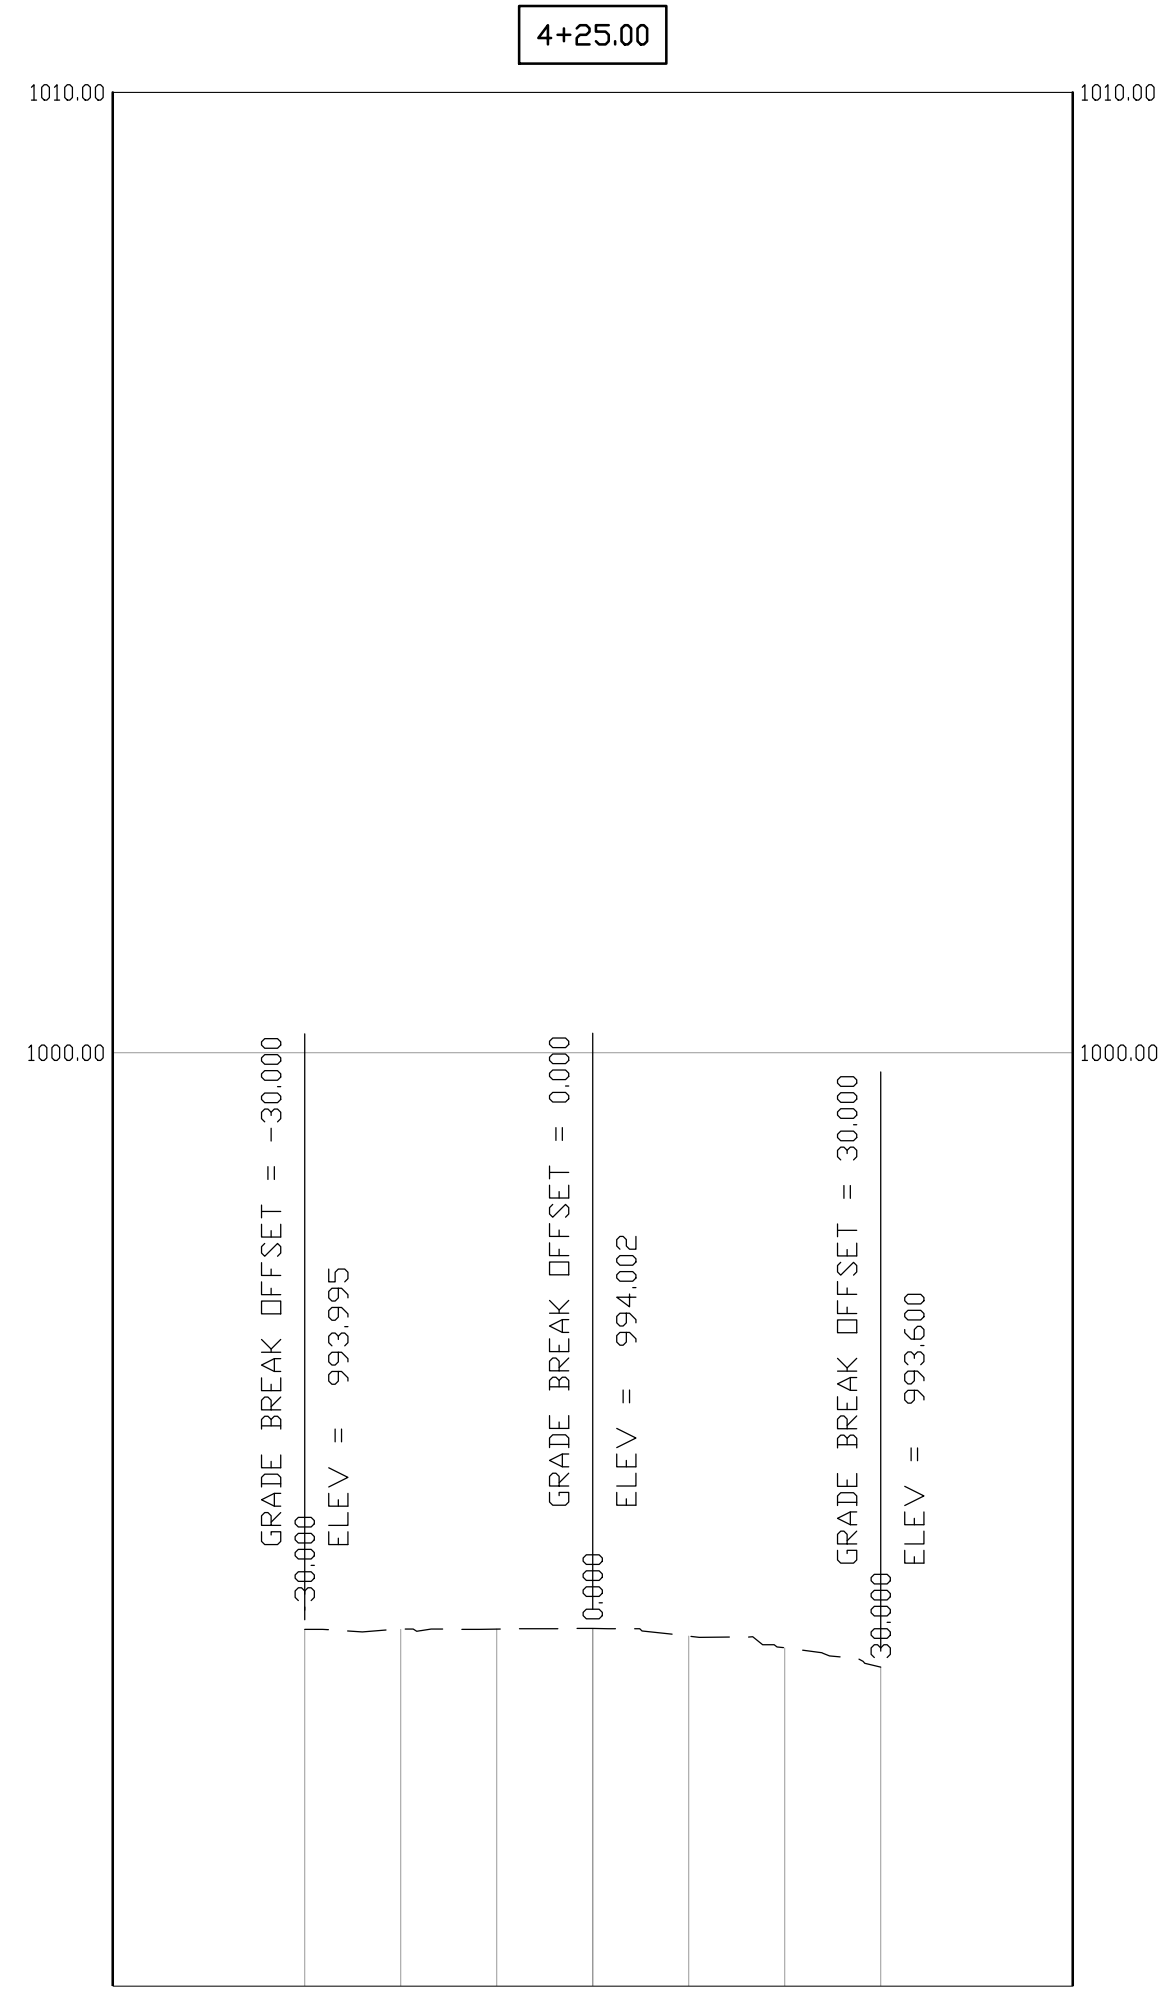

100% SUBMITTAL




CITY OF WOODCREEK
 DEERFIELD DRIVE
 WOODCREEK Texas, 78676

REVISION	
NO.	DATE


PROJECT #
 ISSUE:
 DATE:
 DRAWN BY:

EXIST. CROSS SECTIONS

C6.04
 3 OF 4

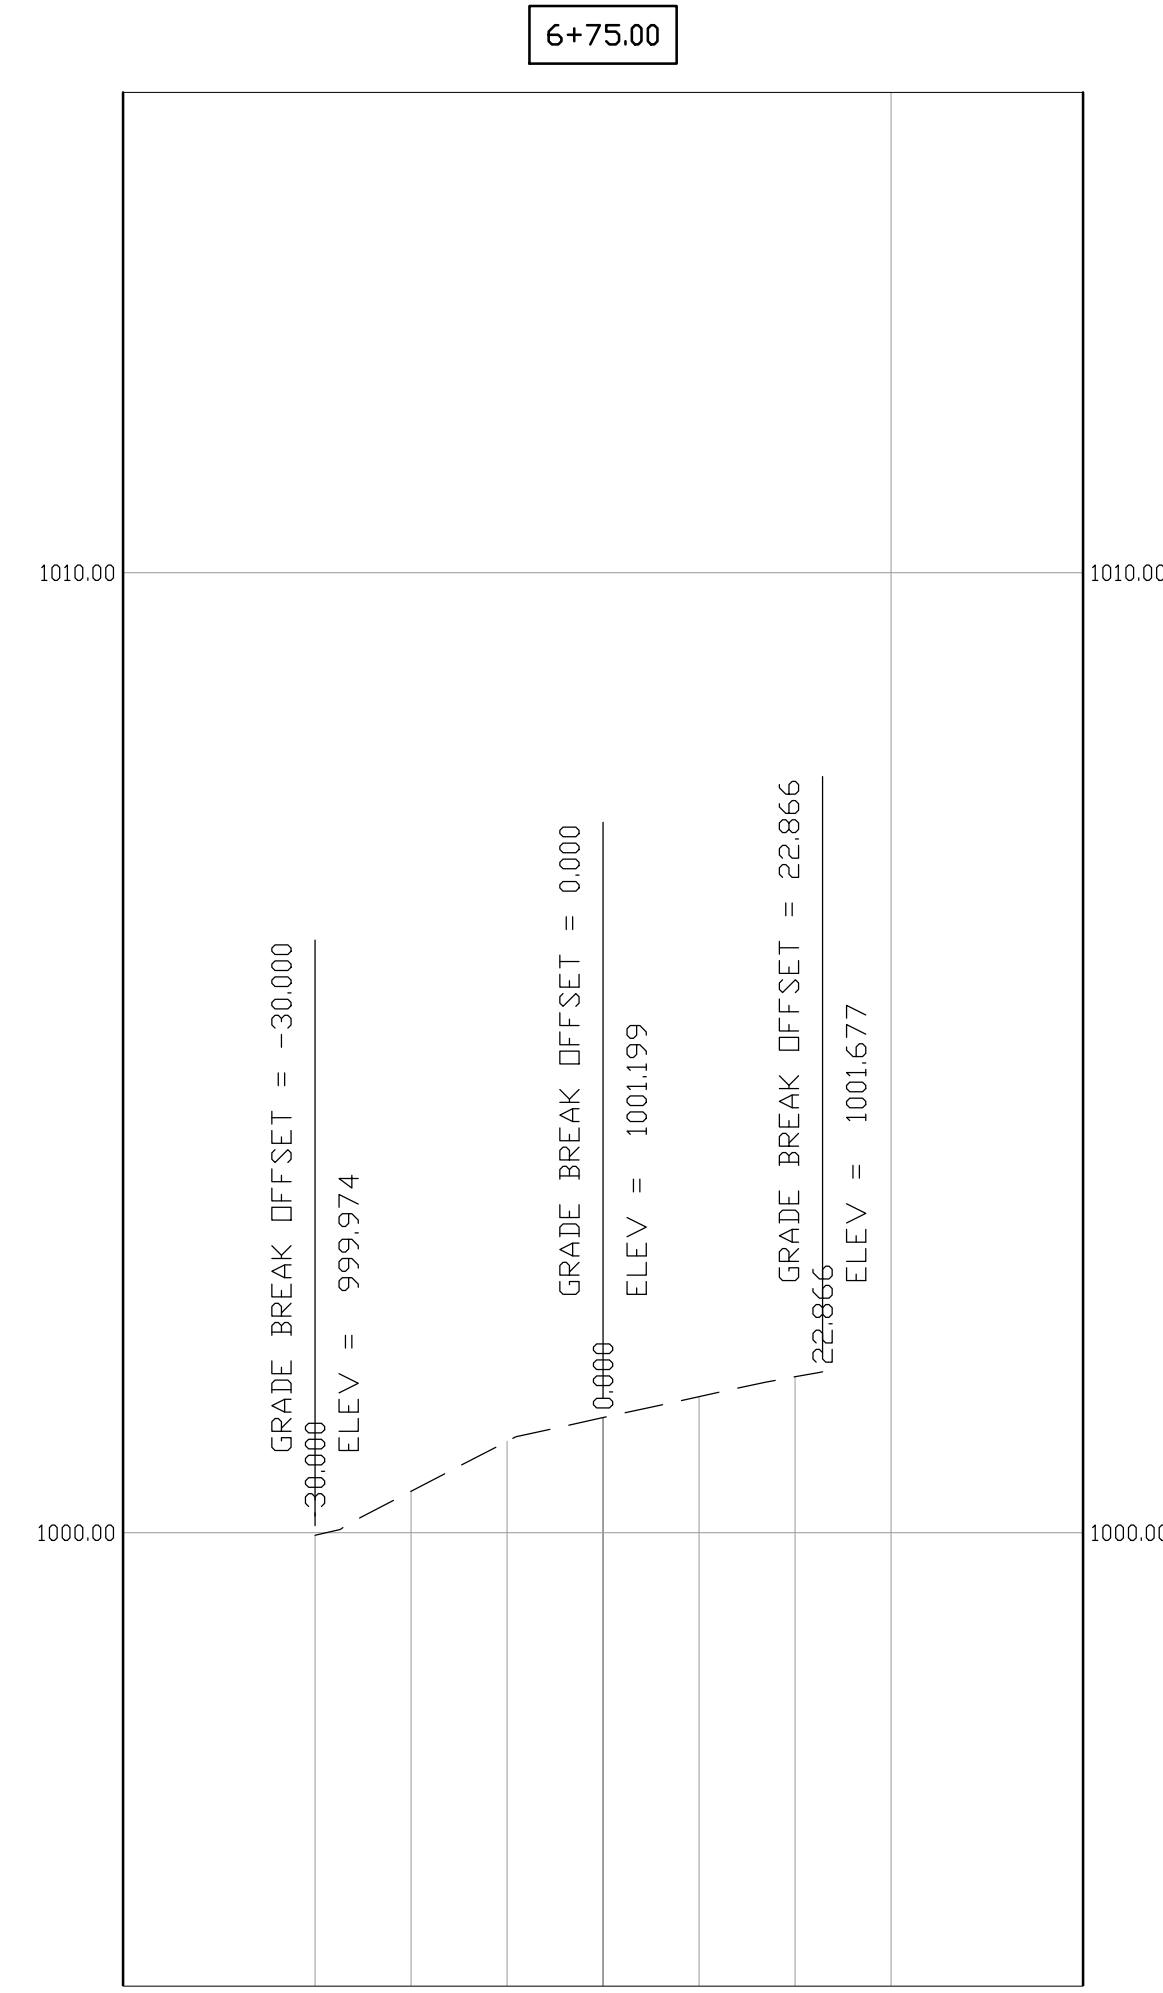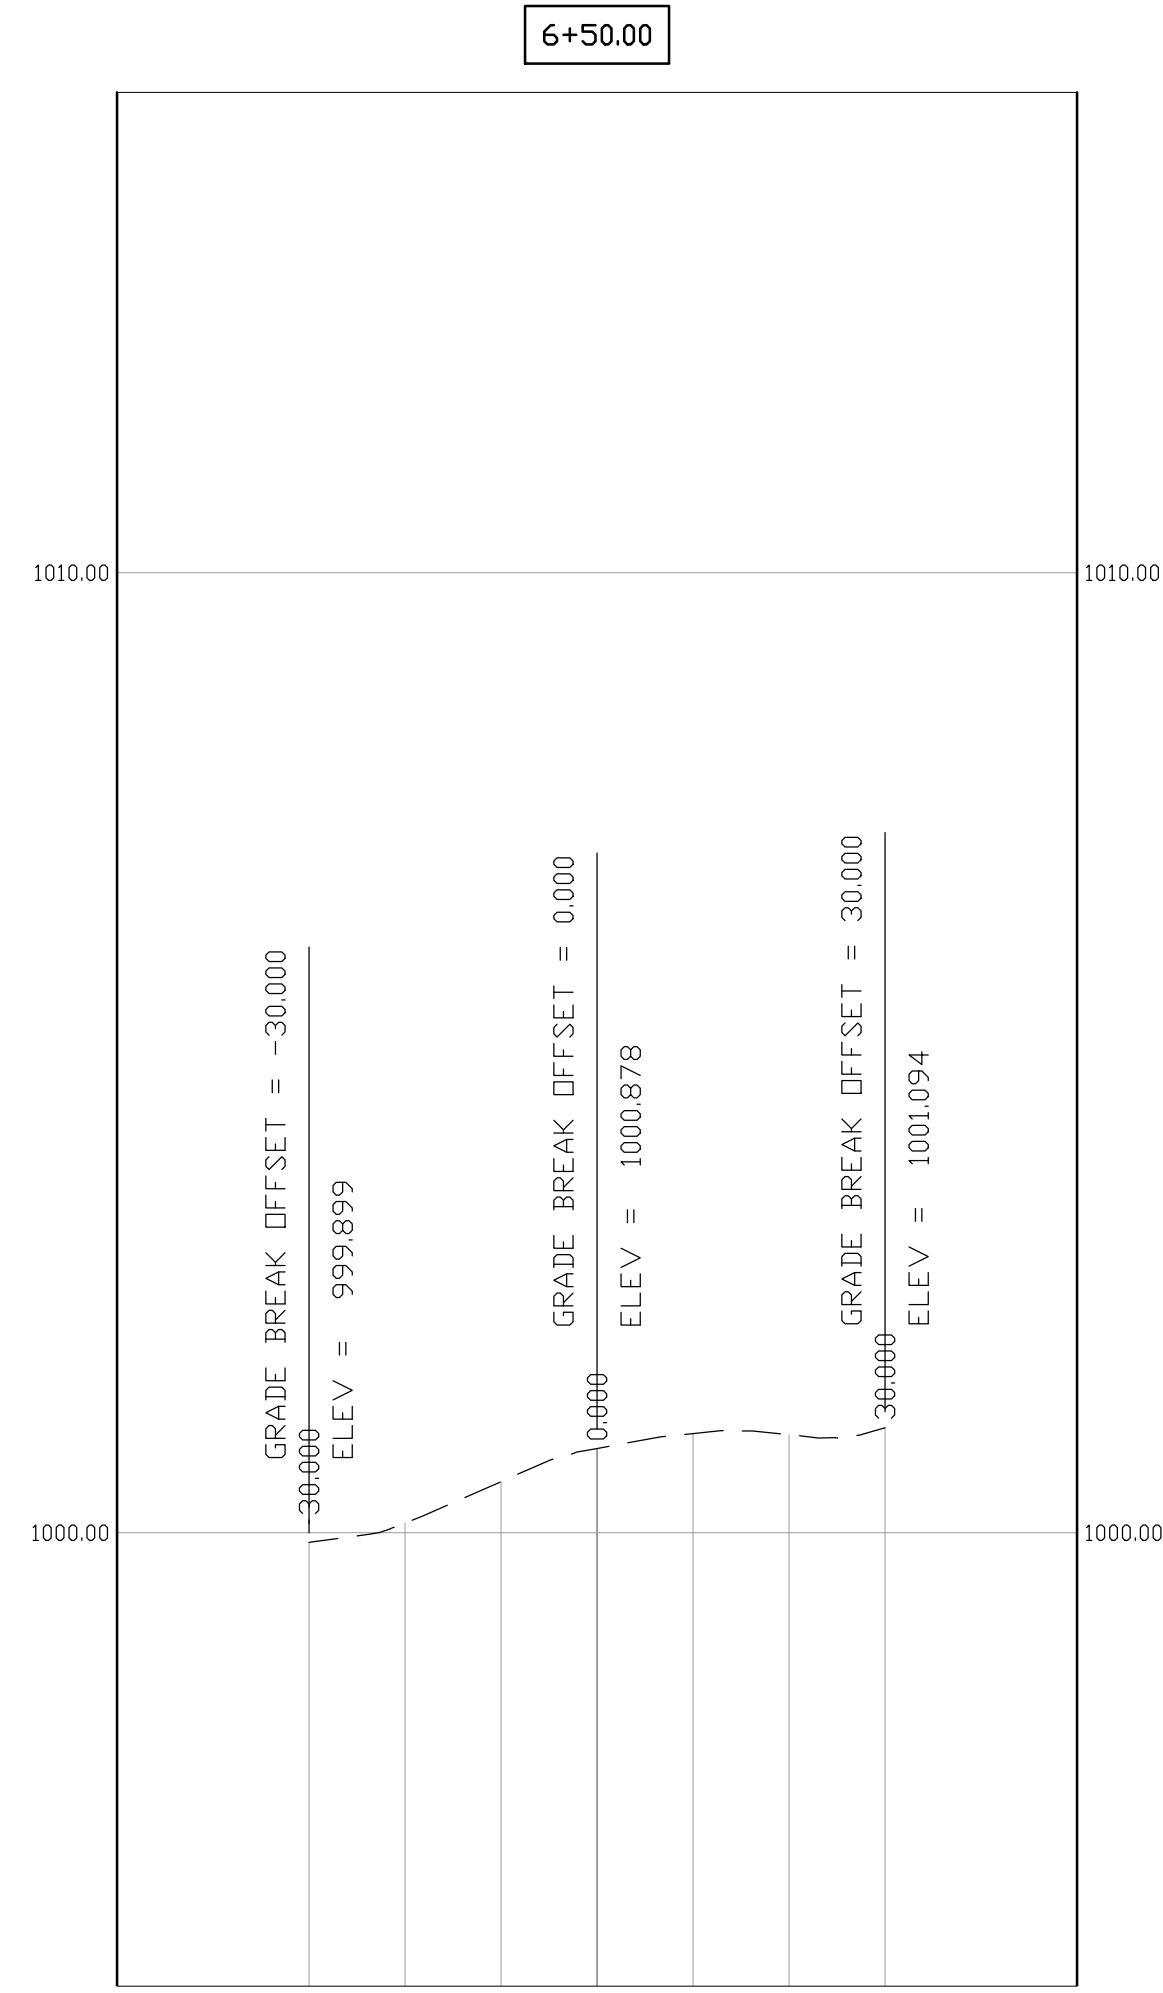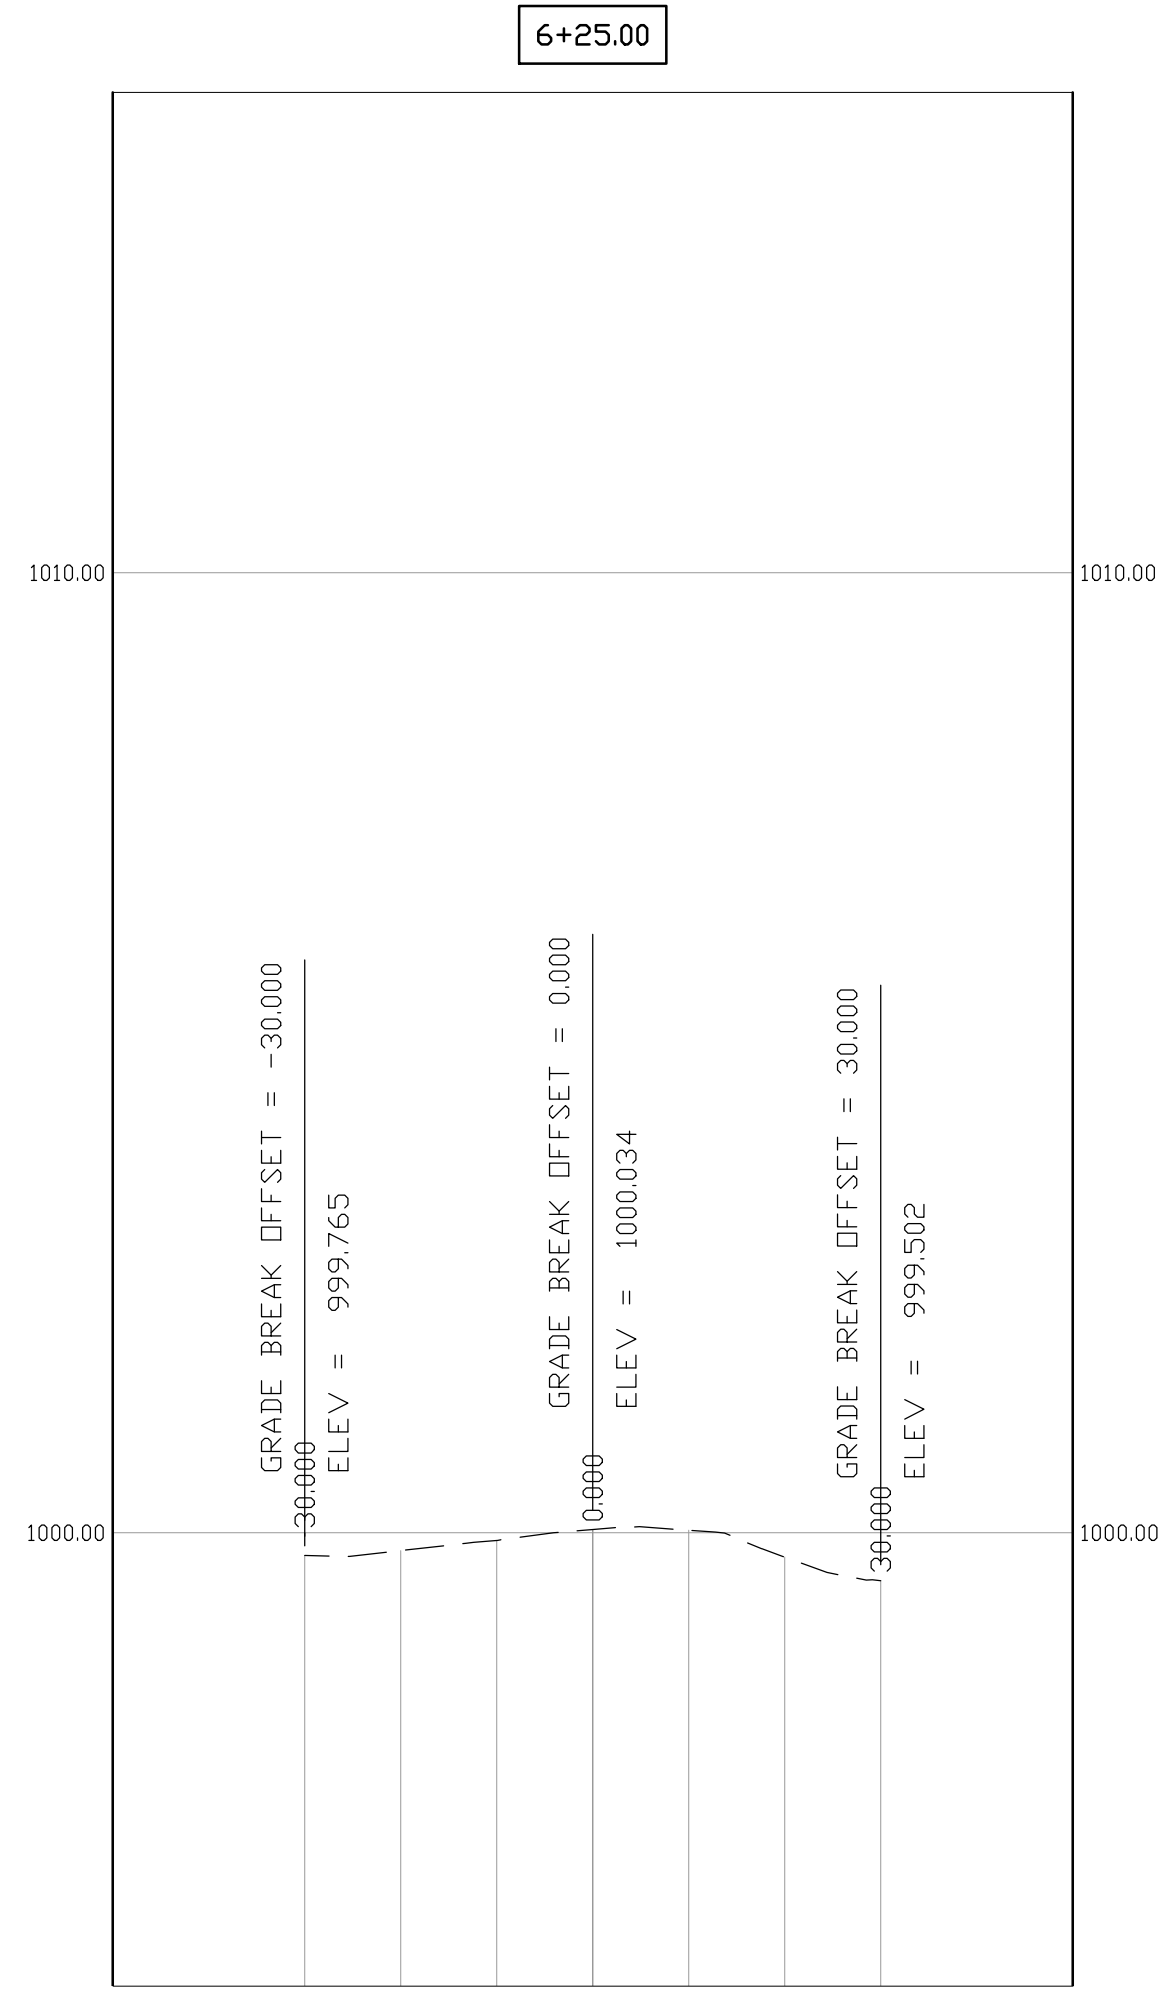

ENGINEERING
 8204 Westglen Drive
 Houston, Texas 77063
 713.868.0001 WWW.TLCeng.com
 F-4066

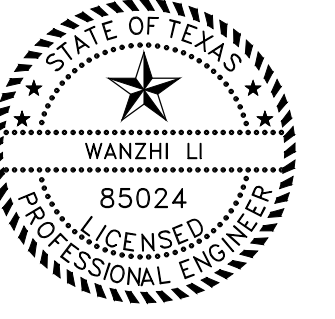

100% SUBMITTAL

CITY OF WOODCREEK
DEERFIELD DRIVE
WOODCREEK Texas, 78676

REVISION NO.	DATE




PROJECT #
 ISSUE:
 DATE:
 DRAWN BY:

EXIST. CROSS SECTIONS

C6.05
 4 OF 4

DISCLAIMER: THIS STANDARD IS GOVERNED BY THE "TEXAS ENGINEERING PRACTICE ACT". NO WARRANTY OF ANY KIND IS MADE BY TREC FOR ANY PURPOSE WHATSOEVER. TREC ASSUMES NO RESPONSIBILITY FOR THE CORRECTION OF THIS STANDARD TO OTHER FORMATS OR FOR INCORRECT RESULTS OR DAMAGES RESULTING FROM ITS USE.

DATE: _____
FILE: _____

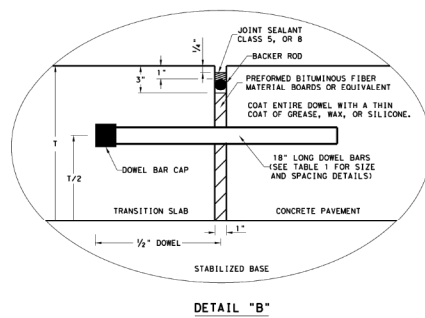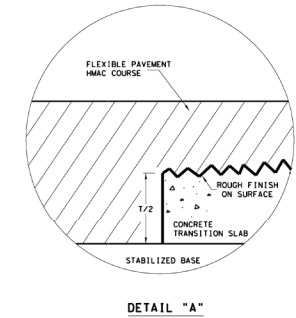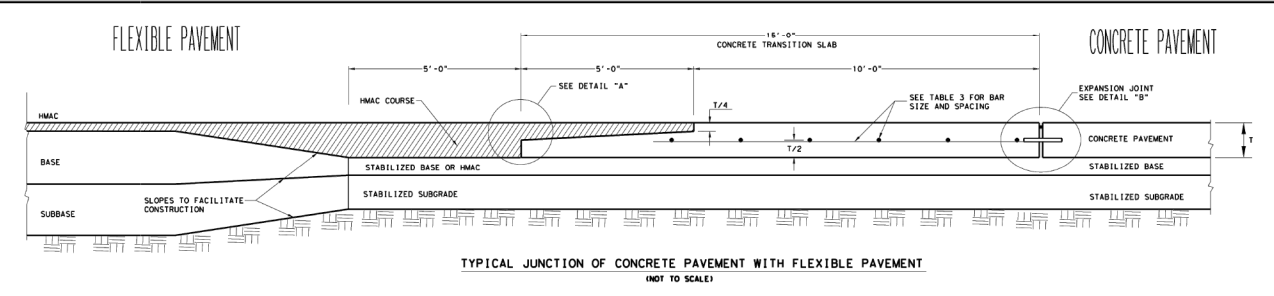

GENERAL NOTES

1. FOR FURTHER INFORMATION REGARDING THE PLACEMENT OF CONCRETE AND LOAD TRANSFER DEVICES REFER TO THE GOVERNING SPECIFICATIONS FOR "CONCRETE PAVEMENT" AND "REINFORCING STEEL."
2. DETAILS FOR PAVEMENT WIDTH AND THE CROWN CROSS-SLOPE SHALL BE SHOWN ELSEWHERE IN THE PLANS.
3. MATCH THE LONGITUDINAL JOINTS OF THE CONCRETE TRANSITION SLAB WITH ADJOINING CONCRETE PAVEMENT. PROVIDE EQUIVALENT TIEBARS OR TRANSVERSE BARS AT THESE LONGITUDINAL JOINTS; SEE TABLE NO. 2.
4. REFER TO DNS-6310, "JOINT SEALANTS AND FILLERS" FOR THE CLASSIFICATIONS.
5. TRANSITION SLABS WILL BE PAID UNDER ITEM 360, "CONCRETE PAVEMENTS."

TABLE NO. 1 DOWELS (SMOOTH BARS)

SLAB THICKNESS T (IN.)	BAR DIA. AND LENGTH (IN.)	SPACING (IN.)
7 TO 7.5	1" X 18"	12
8 TO 10	1 1/4" X 18"	12
10 TO 13	1 1/2" X 18"	12

TABLE NO. 2 TIE BARS (DEFORMED BARS)

SLAB THICKNESS T (IN.)	BAR SIZE (IN.)	SPACING (IN.)
7 TO 7.5	#5	24
8 TO 13	#6	24

TABLE NO. 3 TRANSITION SLAB STEEL (DEFORMED BARS)

SLAB THICKNESS T (IN.)	BAR SIZE (IN.)	SPACING (IN.) TRANSVERSE DIRECTION	SPACING (IN.) LONGITUDINAL DIRECTION
7 TO 7.5	#5	24	12
8 TO 13	#6	24	12

ADJUST SPACING OF LONGITUDINAL BARS AS NEEDED TO ACCOMMODATE DOWEL BAR SPACING.

Texas Department of Transportation Design Division Standard


CONCRETE PAVEMENT DETAILS
TRANSITION SLAB
T-7 TO 13 INCHES

TRANS-20

FILE: HPM0111-001 DATE: 11/01/07 DWG: T-20 DWG: ENR: 11/01/07
 11/01/07 NOVEMBER 2007 DWG: T-20 JOB: HOVWAY
 11/01/07
 SHEET: COUNTY: SHEET NO.:

DISCLAIMER: THIS STANDARD IS GOVERNED BY THE "TEXAS ENGINEERING PRACTICE ACT". NO WARRANTY OF ANY KIND IS MADE BY TREC FOR ANY PURPOSE WHATSOEVER. TREC ASSUMES NO RESPONSIBILITY FOR THE CORRECTION OF THIS STANDARD TO OTHER FORMATS OR FOR INCORRECT RESULTS OR DAMAGES RESULTING FROM ITS USE.

DATE: _____
FILE: _____

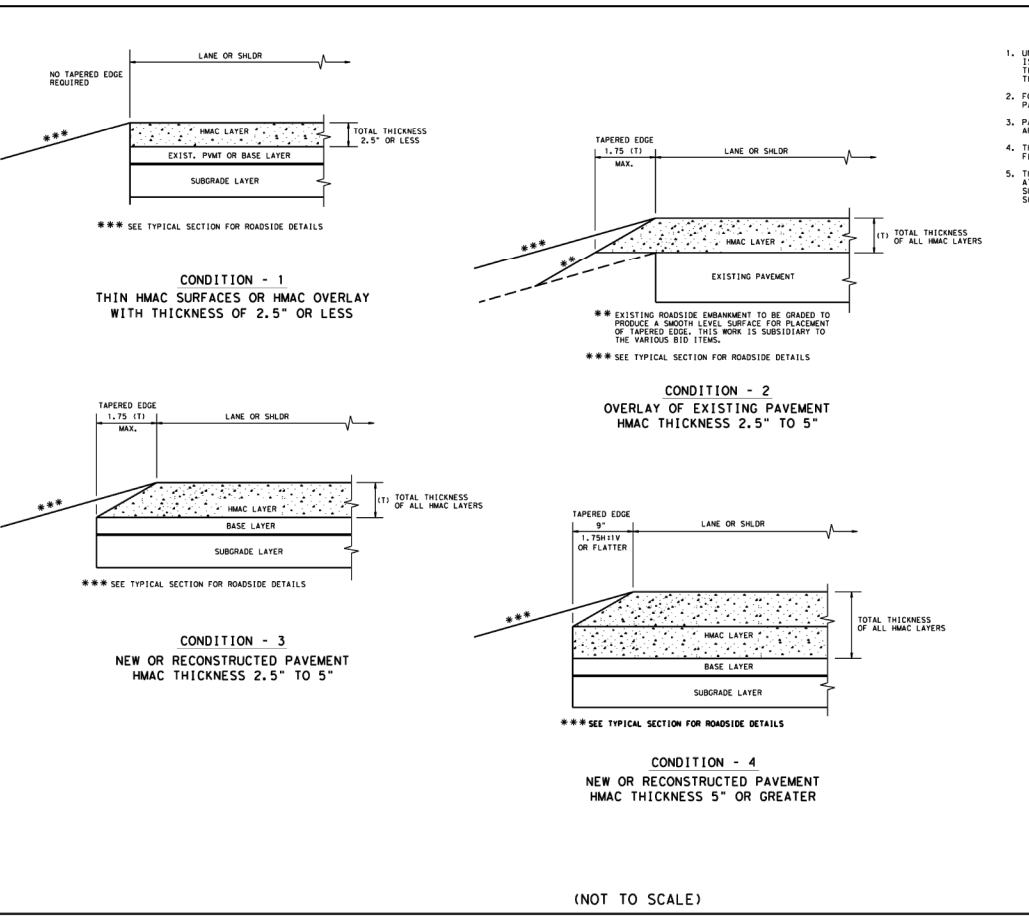

GENERAL NOTES

1. UNLESS OTHERWISE SHOWN IN THE PLANS, A VERTICAL EDGE IS PERMISSIBLE FOR HMAC PLACED GREATER THAN 5' BELOW THE EDGE OF PAVEMENT AND FOR THICKNESS OF HMAC LESS THAN 2.5'.
2. FOR FURTHER INFORMATION REGARDING THE ROADSIDE AND PAVEMENT DETAILS, SEE TYPICAL SECTIONS.
3. PAYMENT FOR TAPERED EDGE WILL BE IN ACCORDANCE WITH APPLICABLE ITEMS IN THE CONTRACT.
4. THE SLOPE OF THE TAPERED EDGE SHALL BE 1.75H:1V OR FLATTER.
5. THE TAPERED EDGE SHALL BE PRODUCED BY USE OF A SCREEN ATTACHMENT CAPABLE OF PRODUCING A SMOOTH COMPACTED SURFACE. ADDITIONAL COMPACTING EFFORT BEHIND THE SCREEN IS NOT REQUIRED.

Texas Department of Transportation Design Division Standard

TAPERED EDGE DETAILS
HMAC PAVEMENT
TE (HMAC) - 11

FILE: HPM0111-001 DATE: 11/01/07 DWG: T-11 DWG: ENR: 11/01/07
 11/01/07 JANUARY 2011 DWG: T-11 JOB: HOVWAY
 11/01/07
 SHEET: COUNTY: SHEET NO.:



8204 Westgen Drive
Houston, Texas 77063
713.868.0001 WWW.TLCeng.com
F-4066



100% SUBMITTAL

CITY OF WOODCREEK
DEERFIELD DRIVE
WOODCREEK Texas, 78676

REVISION

NO.	DATE


PROJECT #
ISSUE:
DATE:
DRAWN BY:

PAVING DETAILS

C7.01



ENGINEERING
 8204 Westglen Drive
 Houston, Texas 77063
 713.868.0001 WWW.TLCeng.com
 F-4066

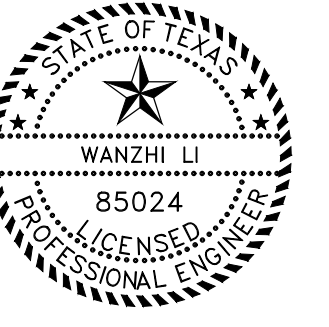

100% SUBMITTAL

CITY OF WOODCREEK
DEERFIELD DRIVE
WOODCREEK Texas, 78676

REVISION	NO.	DATE


PROJECT #
 ISSUE:
 DATE:
 DRAWN BY:

DRIVEWAY DETAILS


C7.02

NOTES:


1. SAWCUT EXISTING DRIVEWAY AT R.O.W. LINE OR AS SHOWN ON DRAWING AND REMOVE EXISTING DRIVEWAY TO SAWCUT LINE.
2. IF THERE IS EXISTING CURB ON DRIVEWAY, CONNECT PROPOSED CURB TO EXISTING CURB; OTHERWISE TAPER CURB HEIGHT AS SHOWN.
3. SEE PAVEMENT DETAIL SHEET FOR CONCRETE CURB REINFORCEMENT.
4. THIS DRIVEWAY INSTALLATION IS GOVERNED BY ITEM 360.
5. LIMIT OF SAWCUT OF PAVEMENT TO APPROACH TO EXISTING DRIVEWAYS:
 (A) UP TO THE R.O.W. ALONG WEST SHOULDER
 (B) UP TO 4'-0" BEYOND THE EAST BOUNDARY OF PAVEMENT.

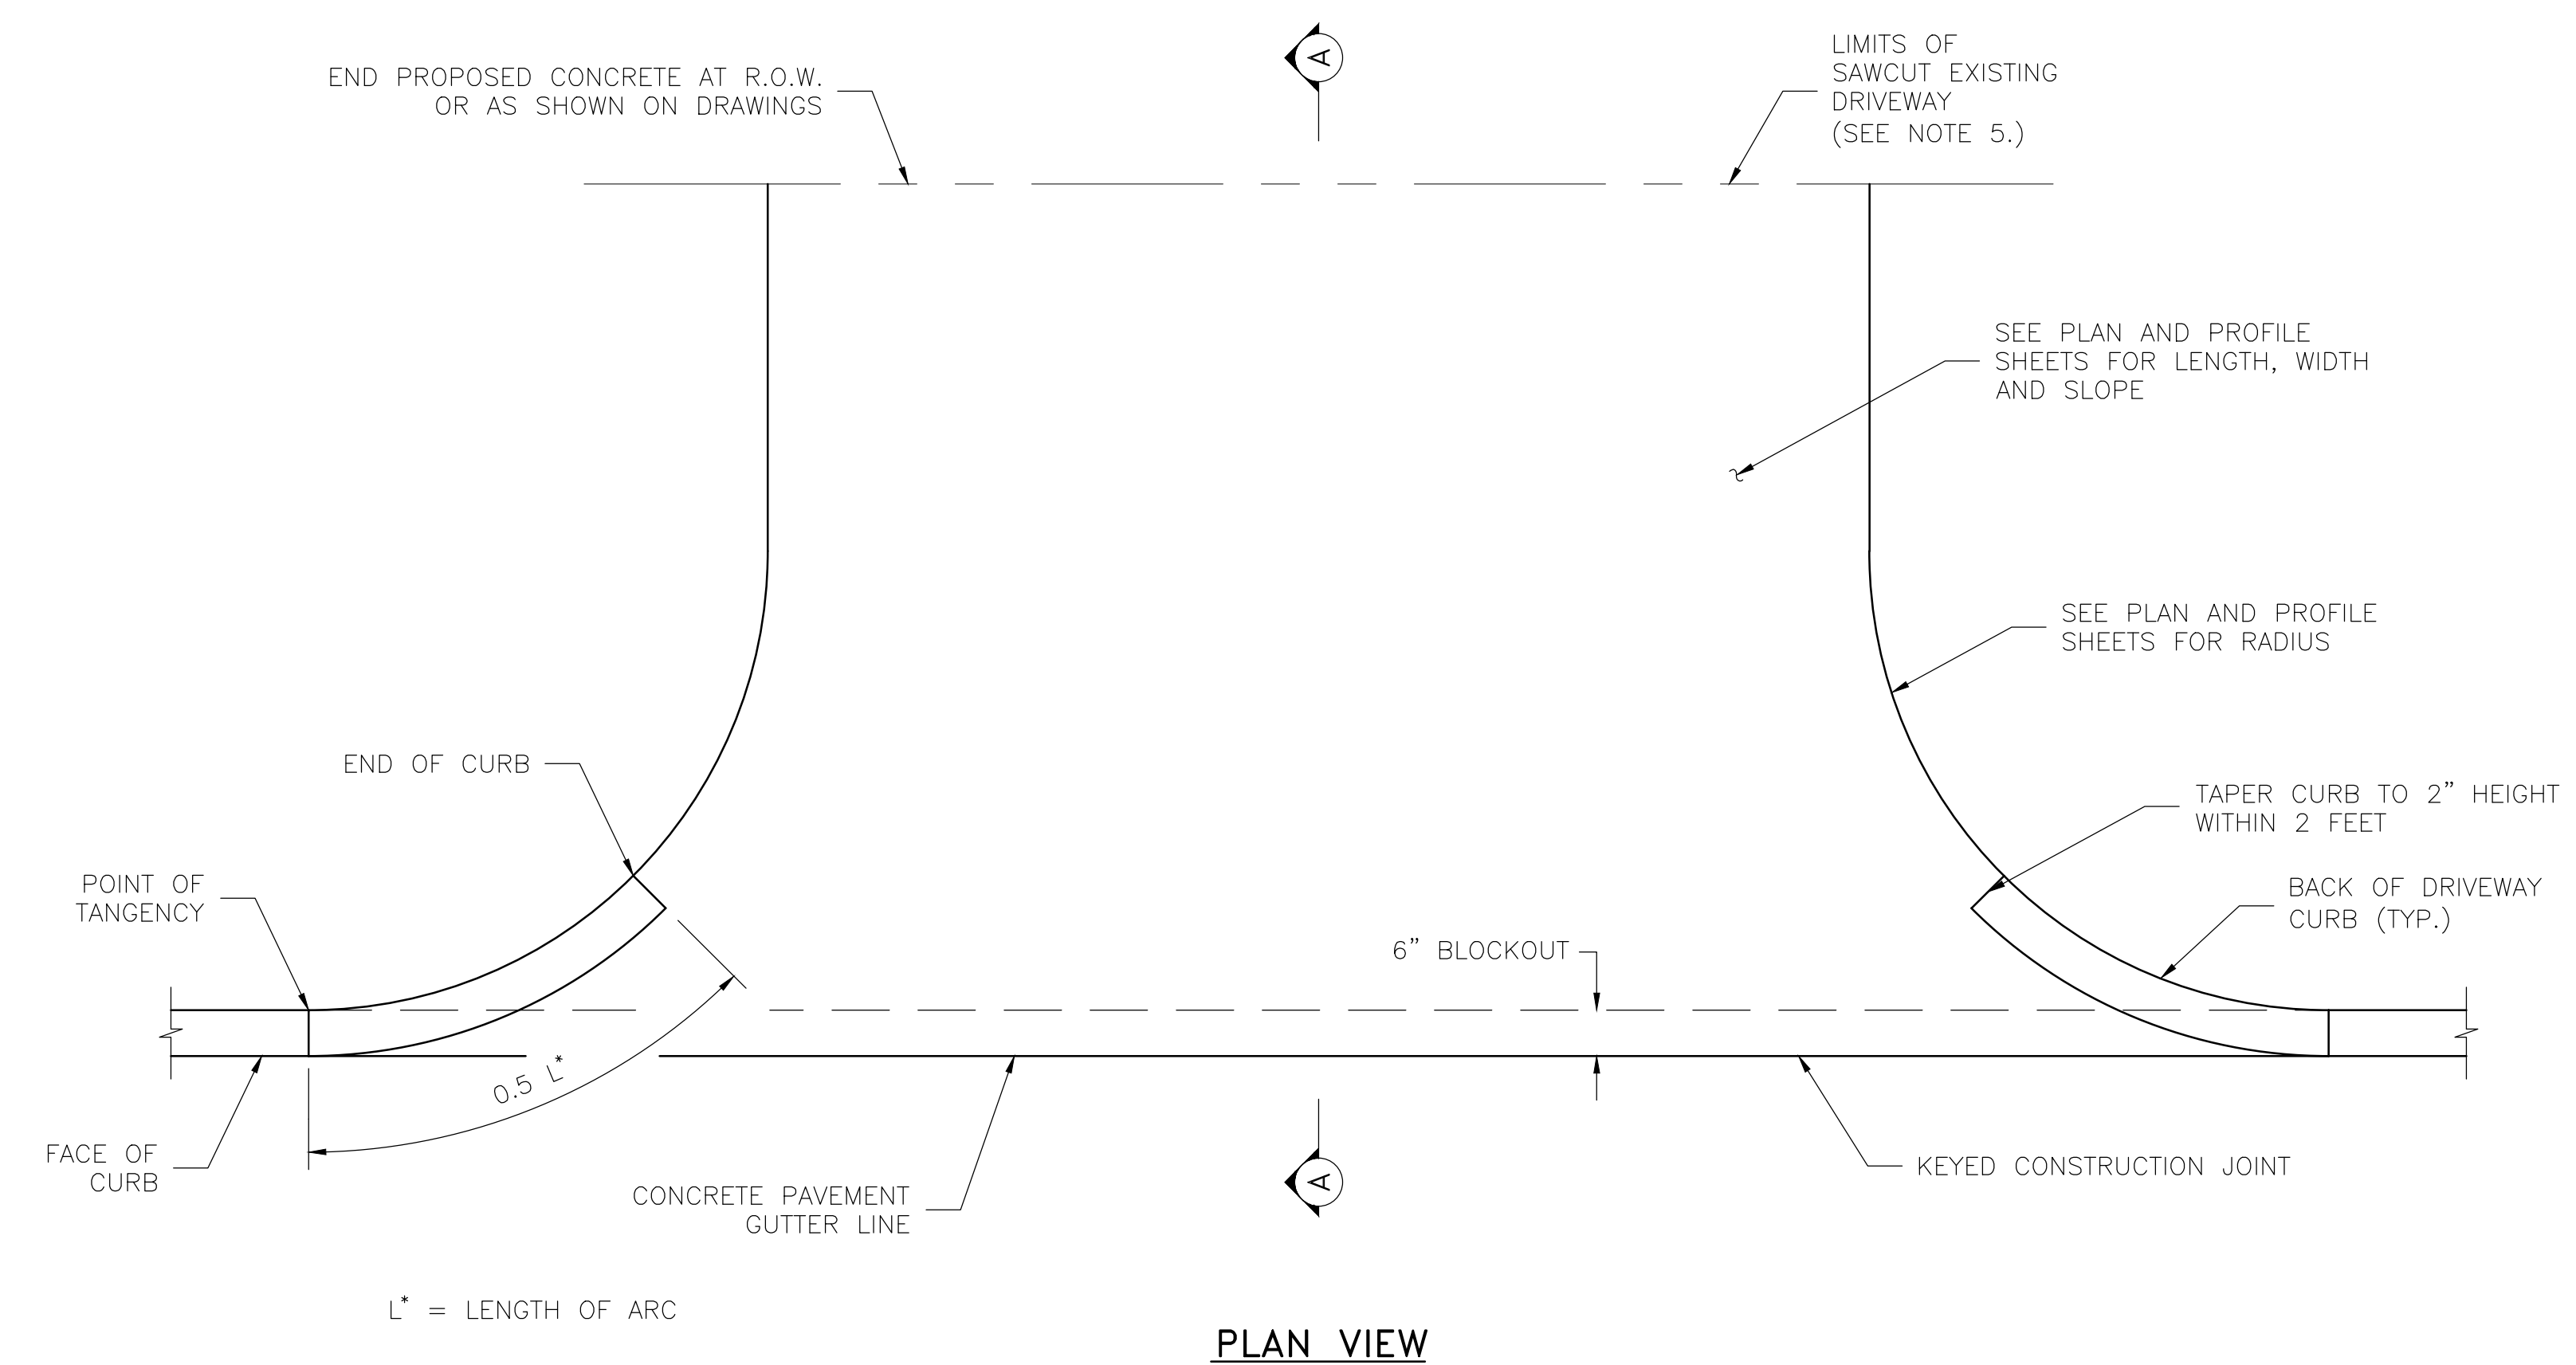

PLAN VIEW

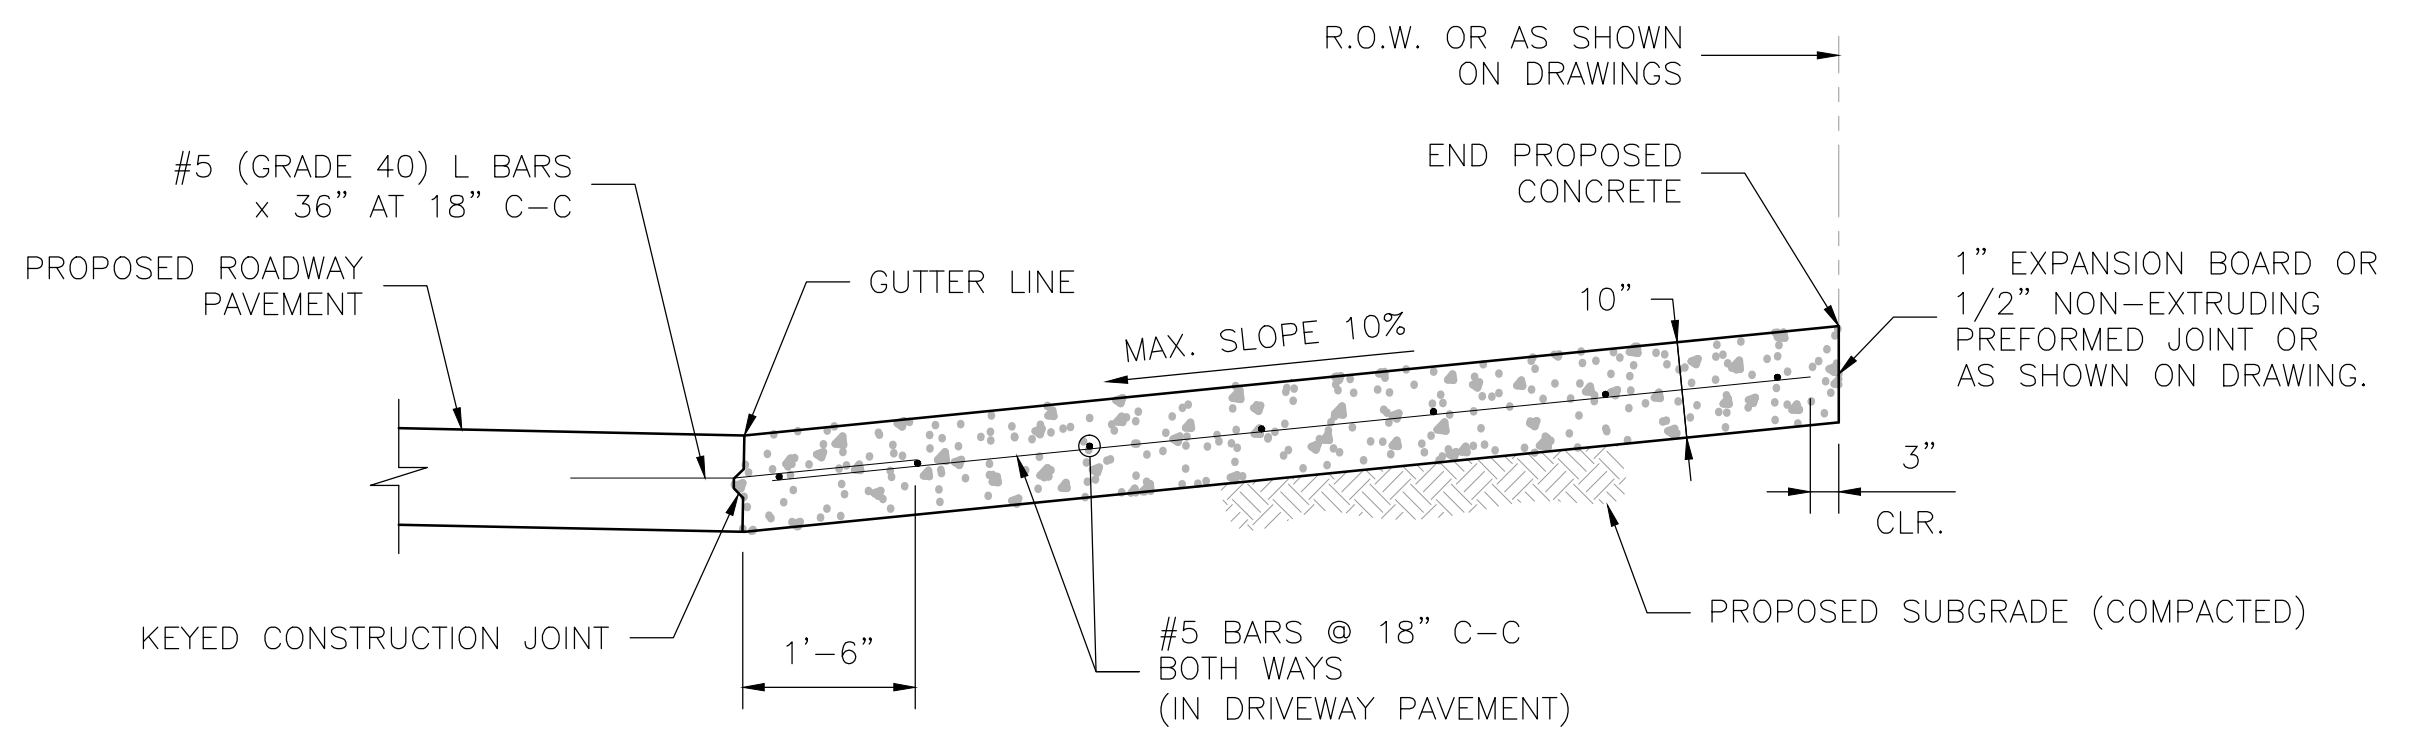

SECTION A-A
 (DRIVEWAY SLOPES TO ROADWAY)

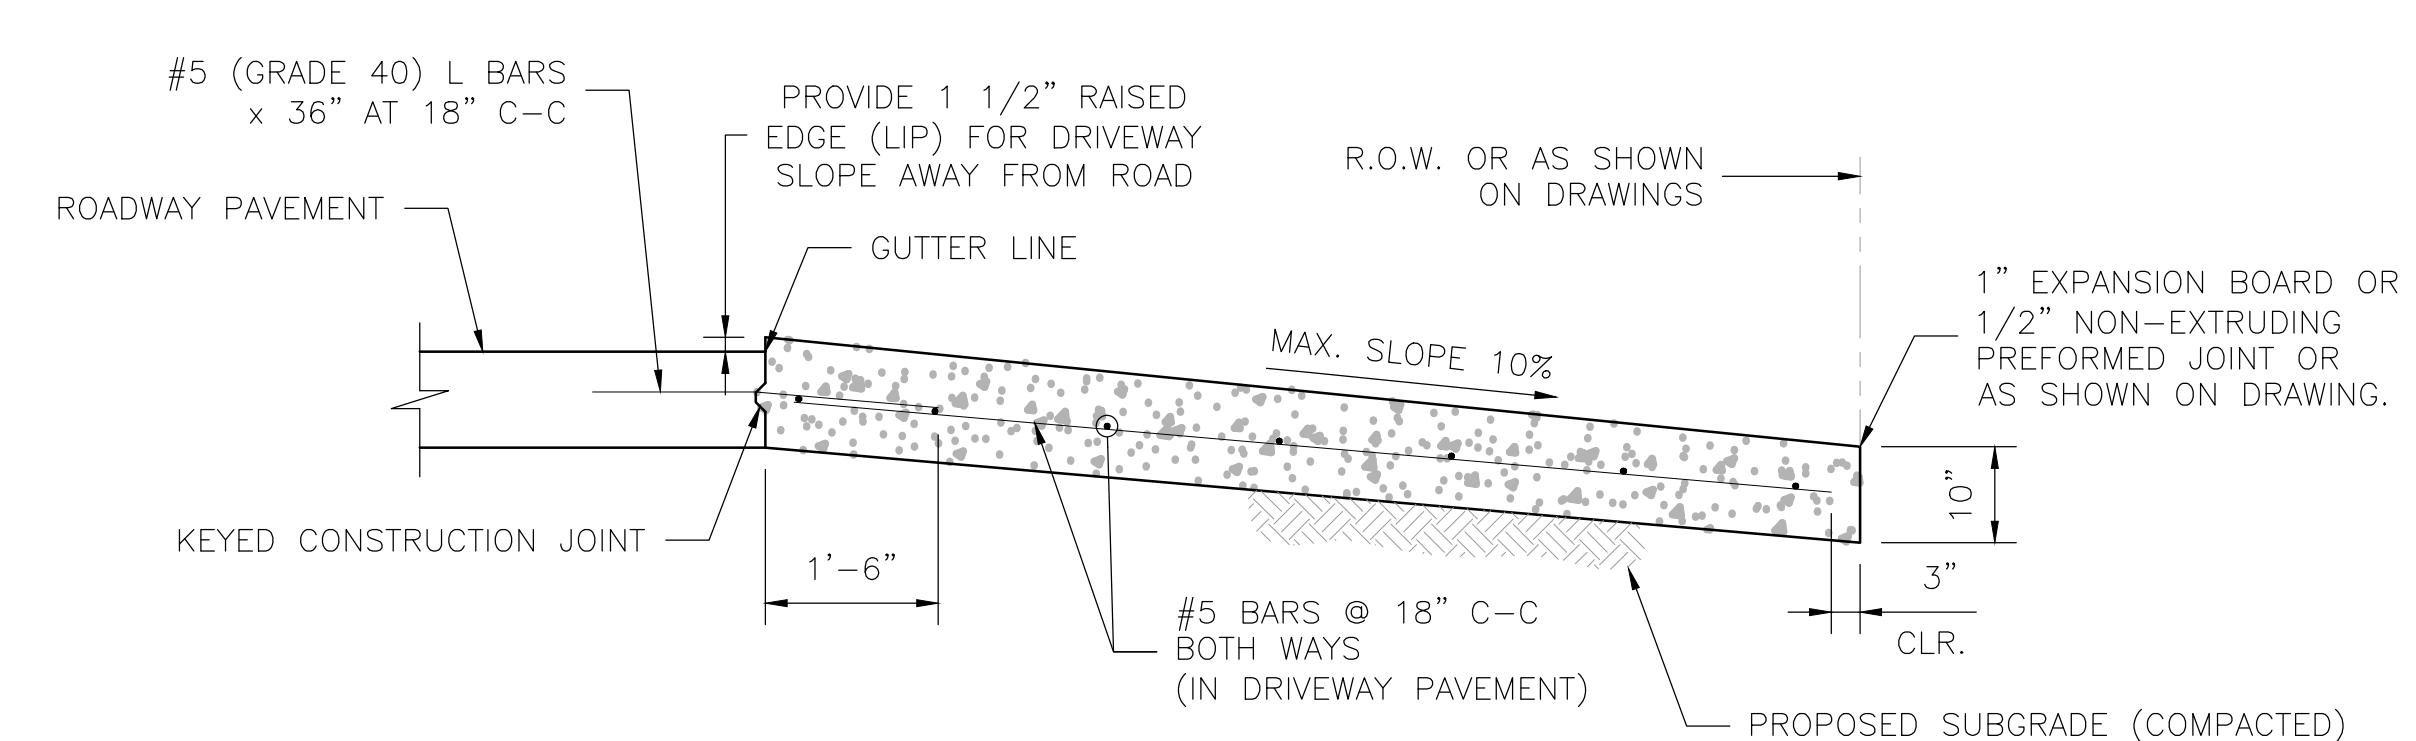


SECTION A-A
 (DRIVEWAY SLOPES AWAY FROM ROADWAY)





ENGINEERING

8204 Westglen Drive
Houston, Texas 77063
713.868.0001 WWW.TLCeng.com
E-4066

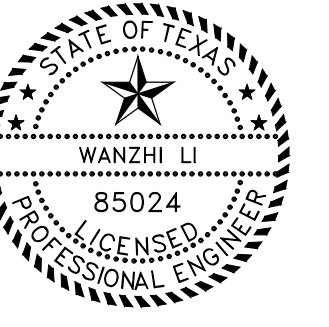

100% SUBMITTAL

CITY OF WOODCREEK
DEERFIELD DRIVE
WOODCREEK Texas, 78676

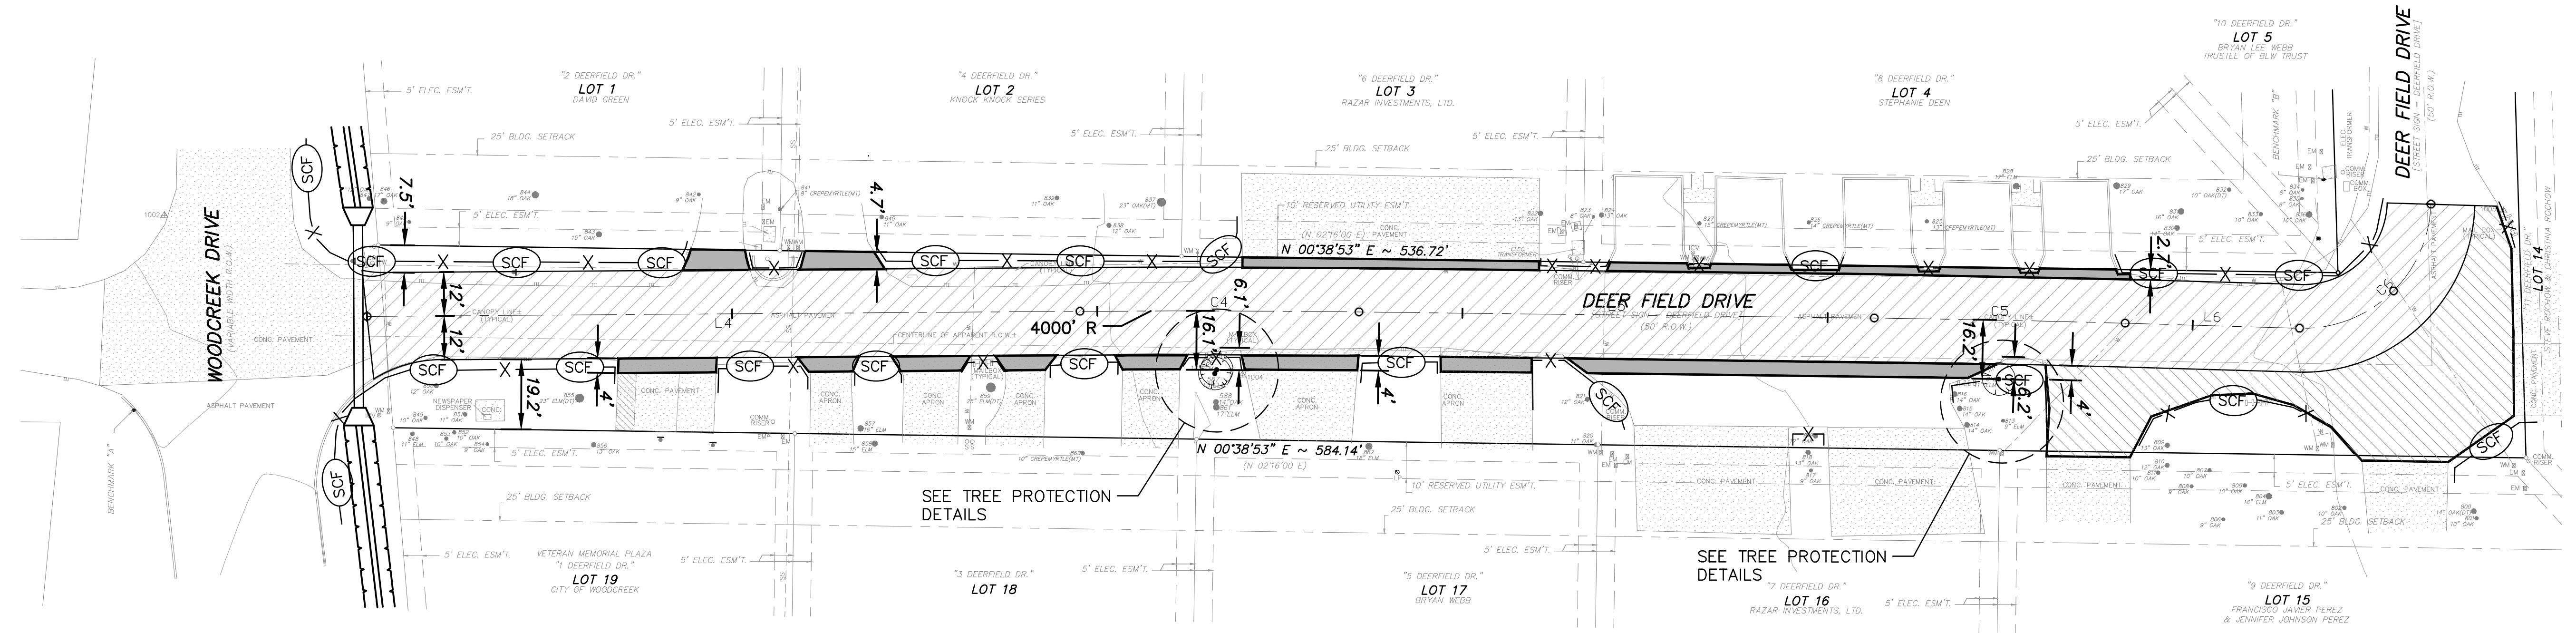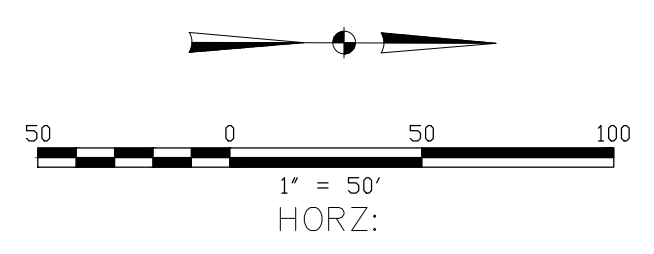

NOTES:

1. STABILIZED CONSTRUCTION ACCESS QUANTITY INCLUDED FOR CONSTRUCTION EXITS ACTUAL LOCATION TO BE DETERMINED BY CONTRACTOR.
2. FILTER FENCING IS NOT TYPICALLY REQUIRED ALONG THE R.O.W. LINE UNLESS STORM WATER FLOWS FROM THE R.O.W. ONTO PRIVATE PROPERTY, WHICH SHOULD BE AVOIDED.

LEGEND:

- X — (SCF) — X SEDIMENT CONTROL FENCE (SEE TXDOT DETAIL EC(1)-16)
- (Symbol with circle and cross) REFER TO TREE PROTECTION DETAILS (TXDOT DETAIL TPD-19)
- (Hatched box) PROPOSED ROAD PAVING
- (Hatched box) PROPOSED APRON PAVING

REVISION	
NO.	DATE


PROJECT #
ISSUE:
DATE:
DRAWN BY:

SWPPP SHEET

C7.03


DISCLAIMER: The use of this standard is governed by the "Texas Engineering Practice Act". No warranty of any kind is made by TxDOT for any purpose whatsoever. TxDOT assumes no responsibility for the conversion of this standard to other formats or for incorrect results or damages resulting from its use.

DATE FILE

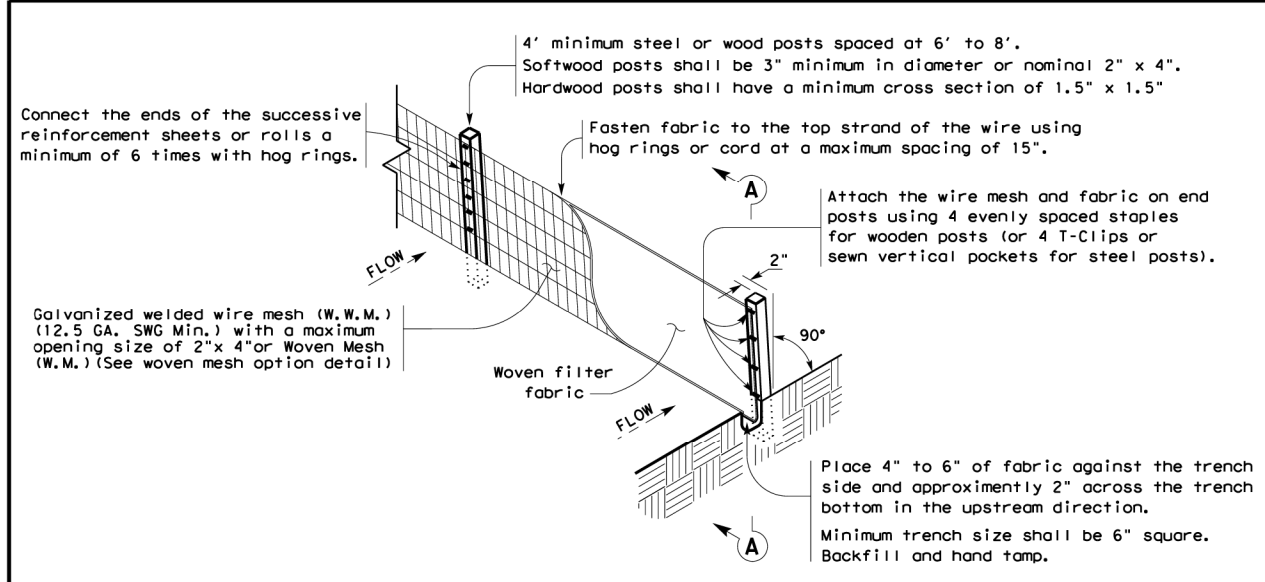

TEMPORARY SEDIMENT CONTROL FENCE

SCF

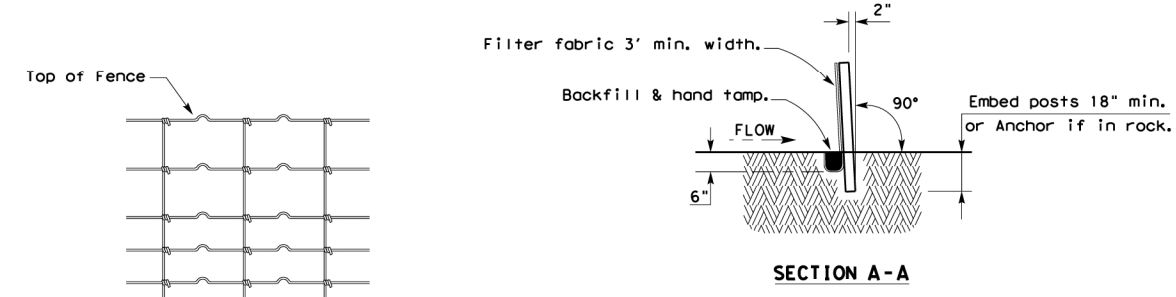

HINGE JOINT KNOT WOVEN MESH (OPTION) DETAIL

Galvanized hinge joint knot woven mesh (12.5 GA. SWG Min.) requires a minimum of five horizontal wires spaced at a maximum of 12 inches apart and all vertical wires spaced at a maximum of 12 inches apart.

SEDIMENT CONTROL FENCE USAGE GUIDELINES

A sediment control fence may be constructed near the downstream perimeter of a disturbed area along a contour to intercept sediment from overland runoff. A 2 year storm frequency may be used to calculate the flow rate to be filtered.


Sediment control fence should be sized to filter a maximum flow through rate of 100 GPM/FT². Sediment control fence is not recommended to control erosion from a drainage area larger than 2 acres.

LEGEND

Sediment Control Fence
SCF

GENERAL NOTES

- Vertical tracking is required on projects where soil distributing activities have occurred unless otherwise approved.
- Perform vertical tracking on slopes to temporarily stabilize soil.
- Provide equipment with a track undercarriage capable of producing linear soil impressions measuring a minimum of 12" in length by 2" to 4" in width by 1/2" to 2" in depth.
- Do not exceed 12" between track impressions.
- Install continuous linear track impressions where the minimum 12" length impressions are perpendicular to the slope or direction of water flow.

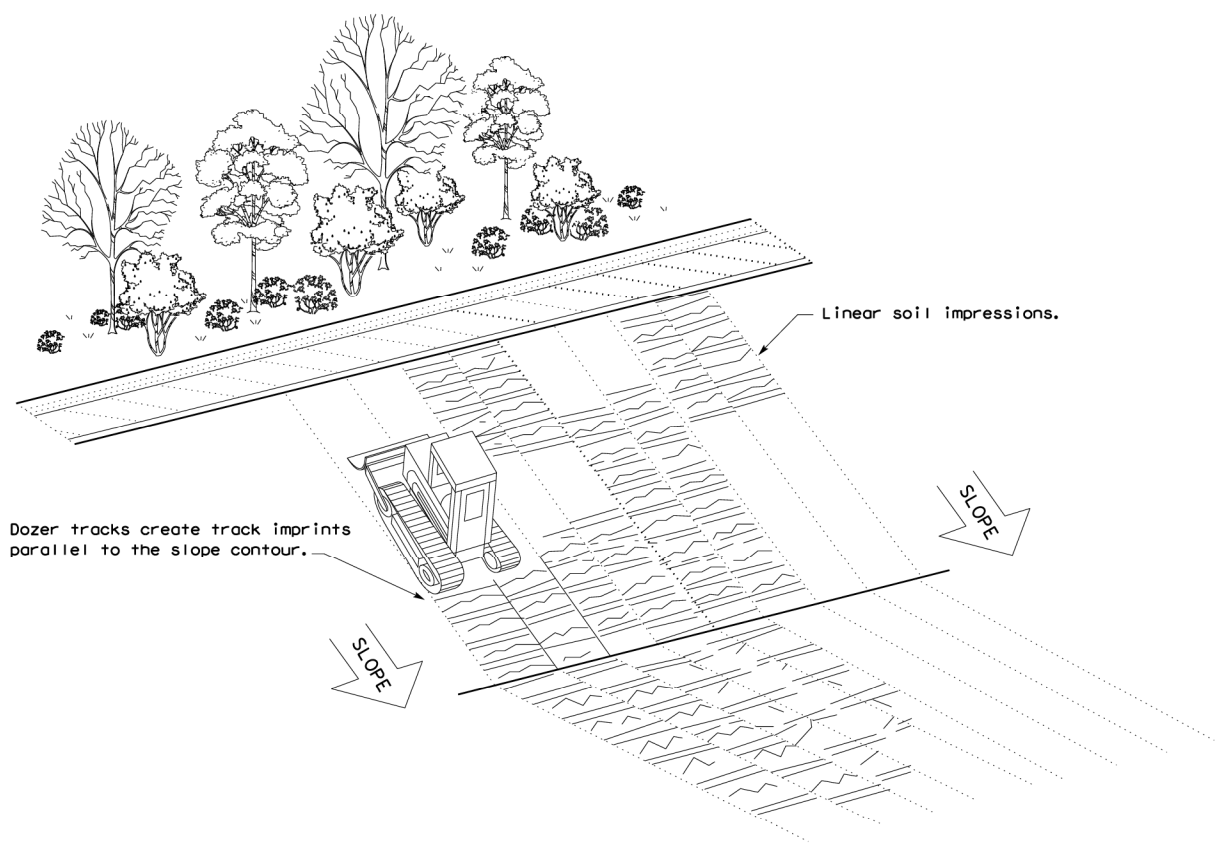

VERTICAL TRACKING

Texas Department of Transportation
Design Division Standard

TEMPORARY EROSION, SEDIMENT AND WATER POLLUTION CONTROL MEASURES FENCE & VERTICAL TRACKING

EC(1)-16

FILE: ec116	DN: TxDOT	CK: KM	DR: VP	DN/CK: LS
© TxDOT: JULY 2016	CONT	SECT	JOB	HIGHWAY
REVISIONS				
	DIST	COUNTY		SHEET NO.



100% SUBMITTAL

CITY OF WOODCREEK
DEERFIELD DRIVE
WOODCREEK Texas, 78676

REVISION

NO.	DATE

PROJECT #
ISSUE:
DATE:
DRAWN BY:


SWPPP DETAILS

C7.04

PATH: Z:\2022 Open Projects\Woodcreek, Tx Engineering Project TDA\CADD\100% Submittal\DEERFIELD DRIVE_Construct Road_Plan and Profile.dwg
 USER: Dec 31, 2024 3:21pm jsmart
 PLOT TAB: CONSTRUCTION SEQUENCE





ENGINEERING
 8204 Westglan Drive
 Houston, Texas 77063
 713.868.0001 WWW.TLCeng.com
 F-4066

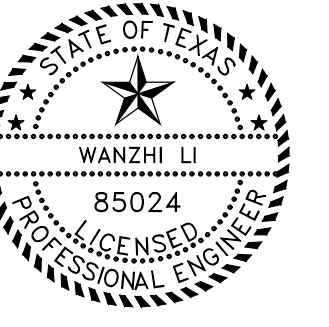

100% SUBMITTAL

CITY OF WOODCREEK
DEERFIELD DRIVE
WOODCREEK Texas, 78676

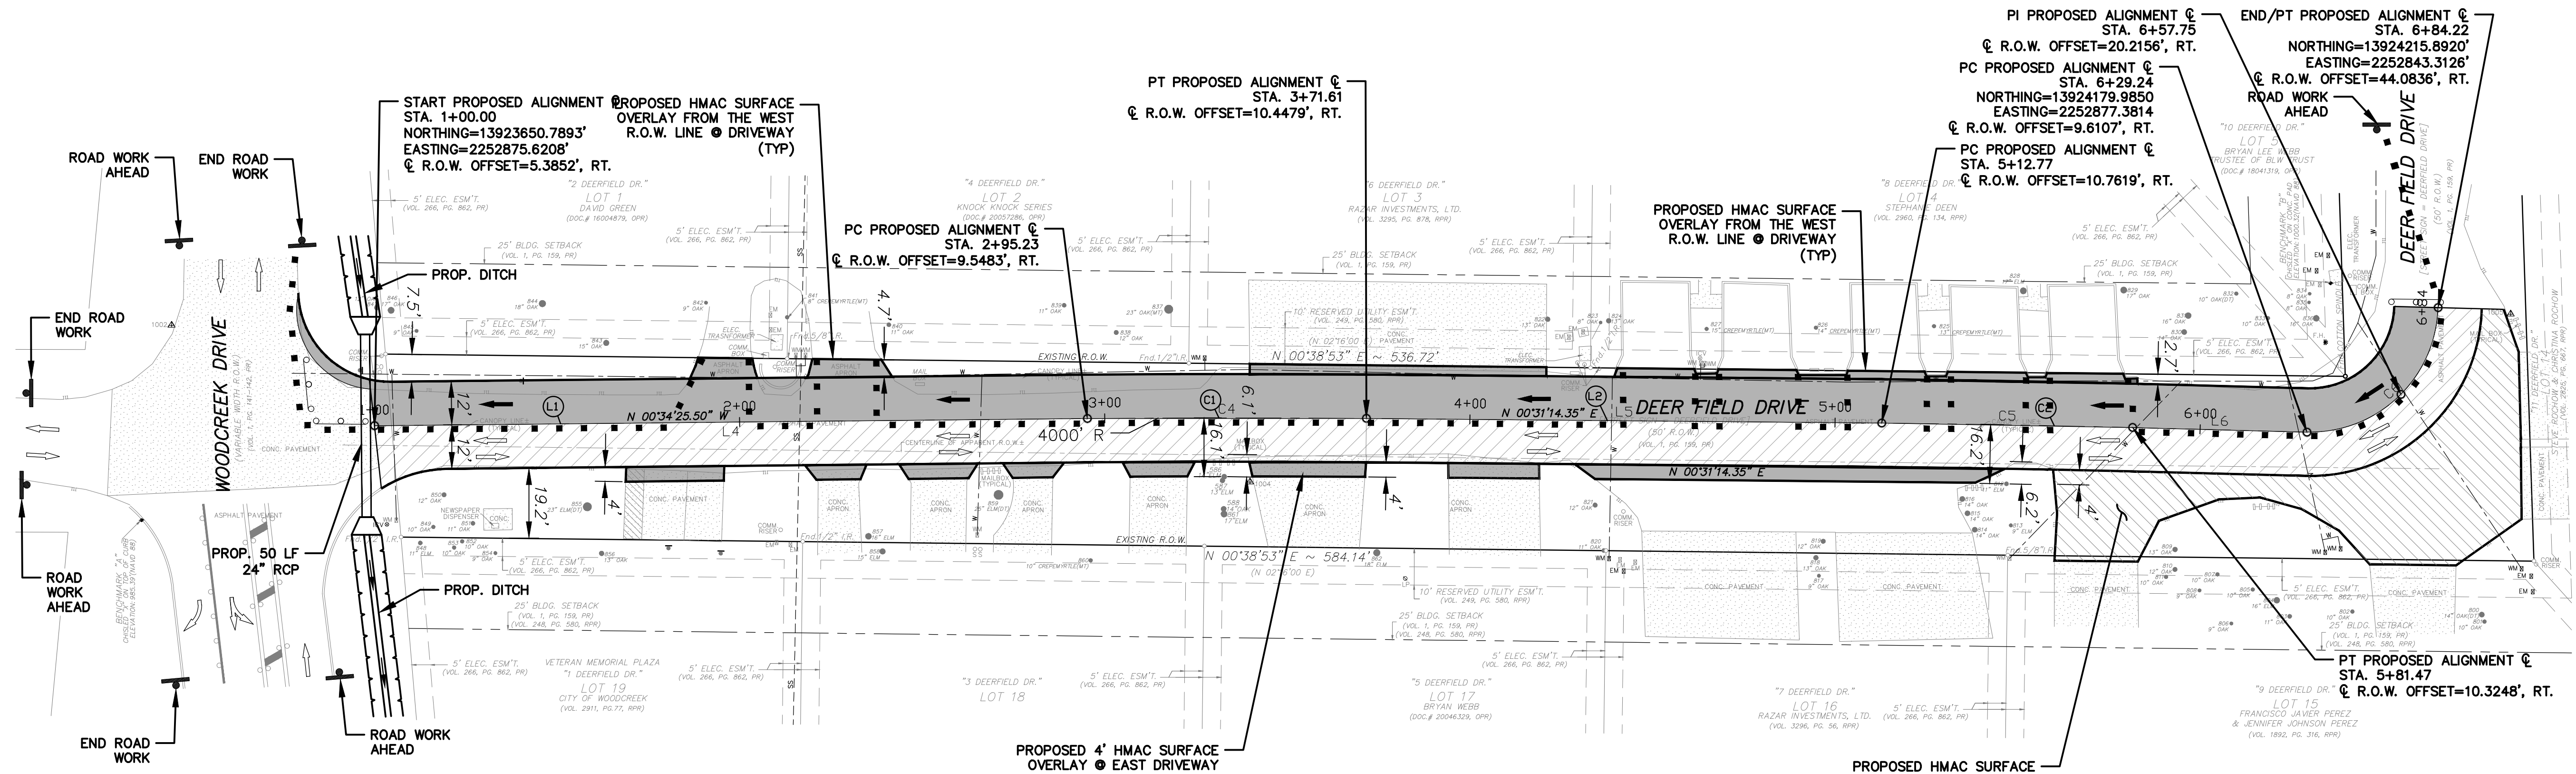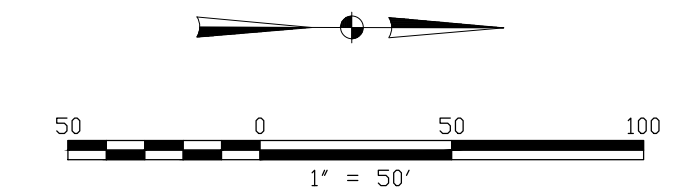

MAKE SURE ALL SPECIFICATION ITEMS MATCH PROJECT MANUAL

- CONSTRUCTION W. TRAVEL LANE (PHASE 1)
- CONSTRUCTION E. TRAVEL LANE (PHASE 2)
- CONSTRUCTION PROP. APRON (PHASE 2)
- DIRECTION OF TRAVEL (PROPOSED)
- DIRECTION OF TRAVEL (EXISTING)
- TYPE III BARRICADE
- CHANNELIZING DEVICES
- VERTICAL PANELS
- CONSTRUCTION SIGN

GENERAL NOTES:

1. PRIOR TO ANY PHASE, IMPLEMENT ADVANCE WARNING SIGNS IN ACCORDANCE WITH HAYS COUNTY BARRICADE AND CONSTRUCTION STANDARDS (BC) AND SHOWN IN THE TCP.
2. PRIOR TO ANY PHASE, PLACE CHANNELIZING DEVICES AND BARRICADES AS SHOWN IN THE PLANS.
3. MAINTAIN ACCESS TO ALL PROPERTY OWNER'S DRIVEWAY THROUGHOUT CONSTRUCTION. REFER TO TCP ITEM ____, TEMPORARY ACCESS DRIVEWAYS SHALL PROVIDE AN ALL-WEATHER SURFACE AND SHALL BE MAINTAINED BY THE CONTRACTOR IN A CONDITION ACCEPTABLE TO THE ENGINEER. WHERE INDICATED IN THE BID DOCUMENTS, ASPHALT MILLINGS MAY BE USED FOR TEMPORARY DRIVEWAYS.

PHASE 1 SOUTHBOUND ROADWAY CONSTRUCTION:

TRAFFIC OPERATIONS:

1. BEGIN TRAFFIC MERGE AT WOODCREEK DRIVE.
2. CONTRACTOR TO REFER TO ITEM ____ FOR INSTALLING TEMPOARY PAVEMENT.
3. THE EXISTING NORTHBOUND TRAFFIC LANE WILL BE SWITCHED TO ONE LANE FOR NORTHBOUND AND SOUTHBOUND TRAFFIC.

CONSTRUCTION:

1. DEMOLISH EXISTING SOUTHBOUND LANE (SEE SHEET C2.01, DEMOLITION PLAN).
2. CONSTRUCT PROPOSED SOUTHBOUND 10' LANE AND 2" SHOULDER FROM STATION 1+00 TO STATION 6+85.22 (END).
3. ALL DRIVEWAYS ON THE WEST SIDE OF ROADWAY WILL BE INSTALLED ONE HALF AT A TIME TO ALLOW FOR RESIDENTS ACCESS.

PHASE 2 NORTHBOUND ROADWAY CONSTRUCTION:

TRAFFIC OPERATIONS:

1. THE TRAFFIC ON THE OLD NORTHBOUND ROADWAY WILL BE SWITCHED TO THE NEWLY CONSTRUCTED SOUTHBOUND LANES (TWO WAY TRAFFIC).
2. MODIFY TRANSITION FROM SOUTHBOUND TO NORTHBOUND BETWEEN WOODCREEK DRIVE AND TO STATION 6+85.22 (END).

CONSTRUCTION:

1. DEMOLISH EXISTING NORTHBOUND LANE (SEE SHEET C2.01, DEMOLITION PLAN)
2. CONSTRUCT 10' TRAFFIC LANE AND 2' SHOULDER PROPOSED NORTHBOUND ROAD PAVEMENT FROM STATION 1+00 TO 6+84.22 (END) TO W. BELFORT BLVD.
3. ALL DRIVEWAYS ON THE EAST SIDE OF ROADWAY WILL BE INSTALLED ONE HALF SIDE AT A TIME TO ALLOW FOR RESIDENTS ACCESS.

REVISION NO.	DATE



PROJECT #
 ISSUE:
 DATE:
 DRAWN BY:

CONSTRUCTION SEQUENCE

C7.05
 1 OF 1

PATH: Z:\2022 Open Projects\Woodcreek, Tx Engineering Project TDA\CADD\100% Submittal\DEERFIELD DRIVE _Construct Road_Plan and Profile.dwg
 USER: Dec 31, 2024 3:21pm ismart
 PLOT TAB: PAVEMENT MARKINGS AND SIGNAGE

WILL THIS PROJECT REQUIRE NEW STOP SIGN OR IS THIS ONE BEING RECYCLED?

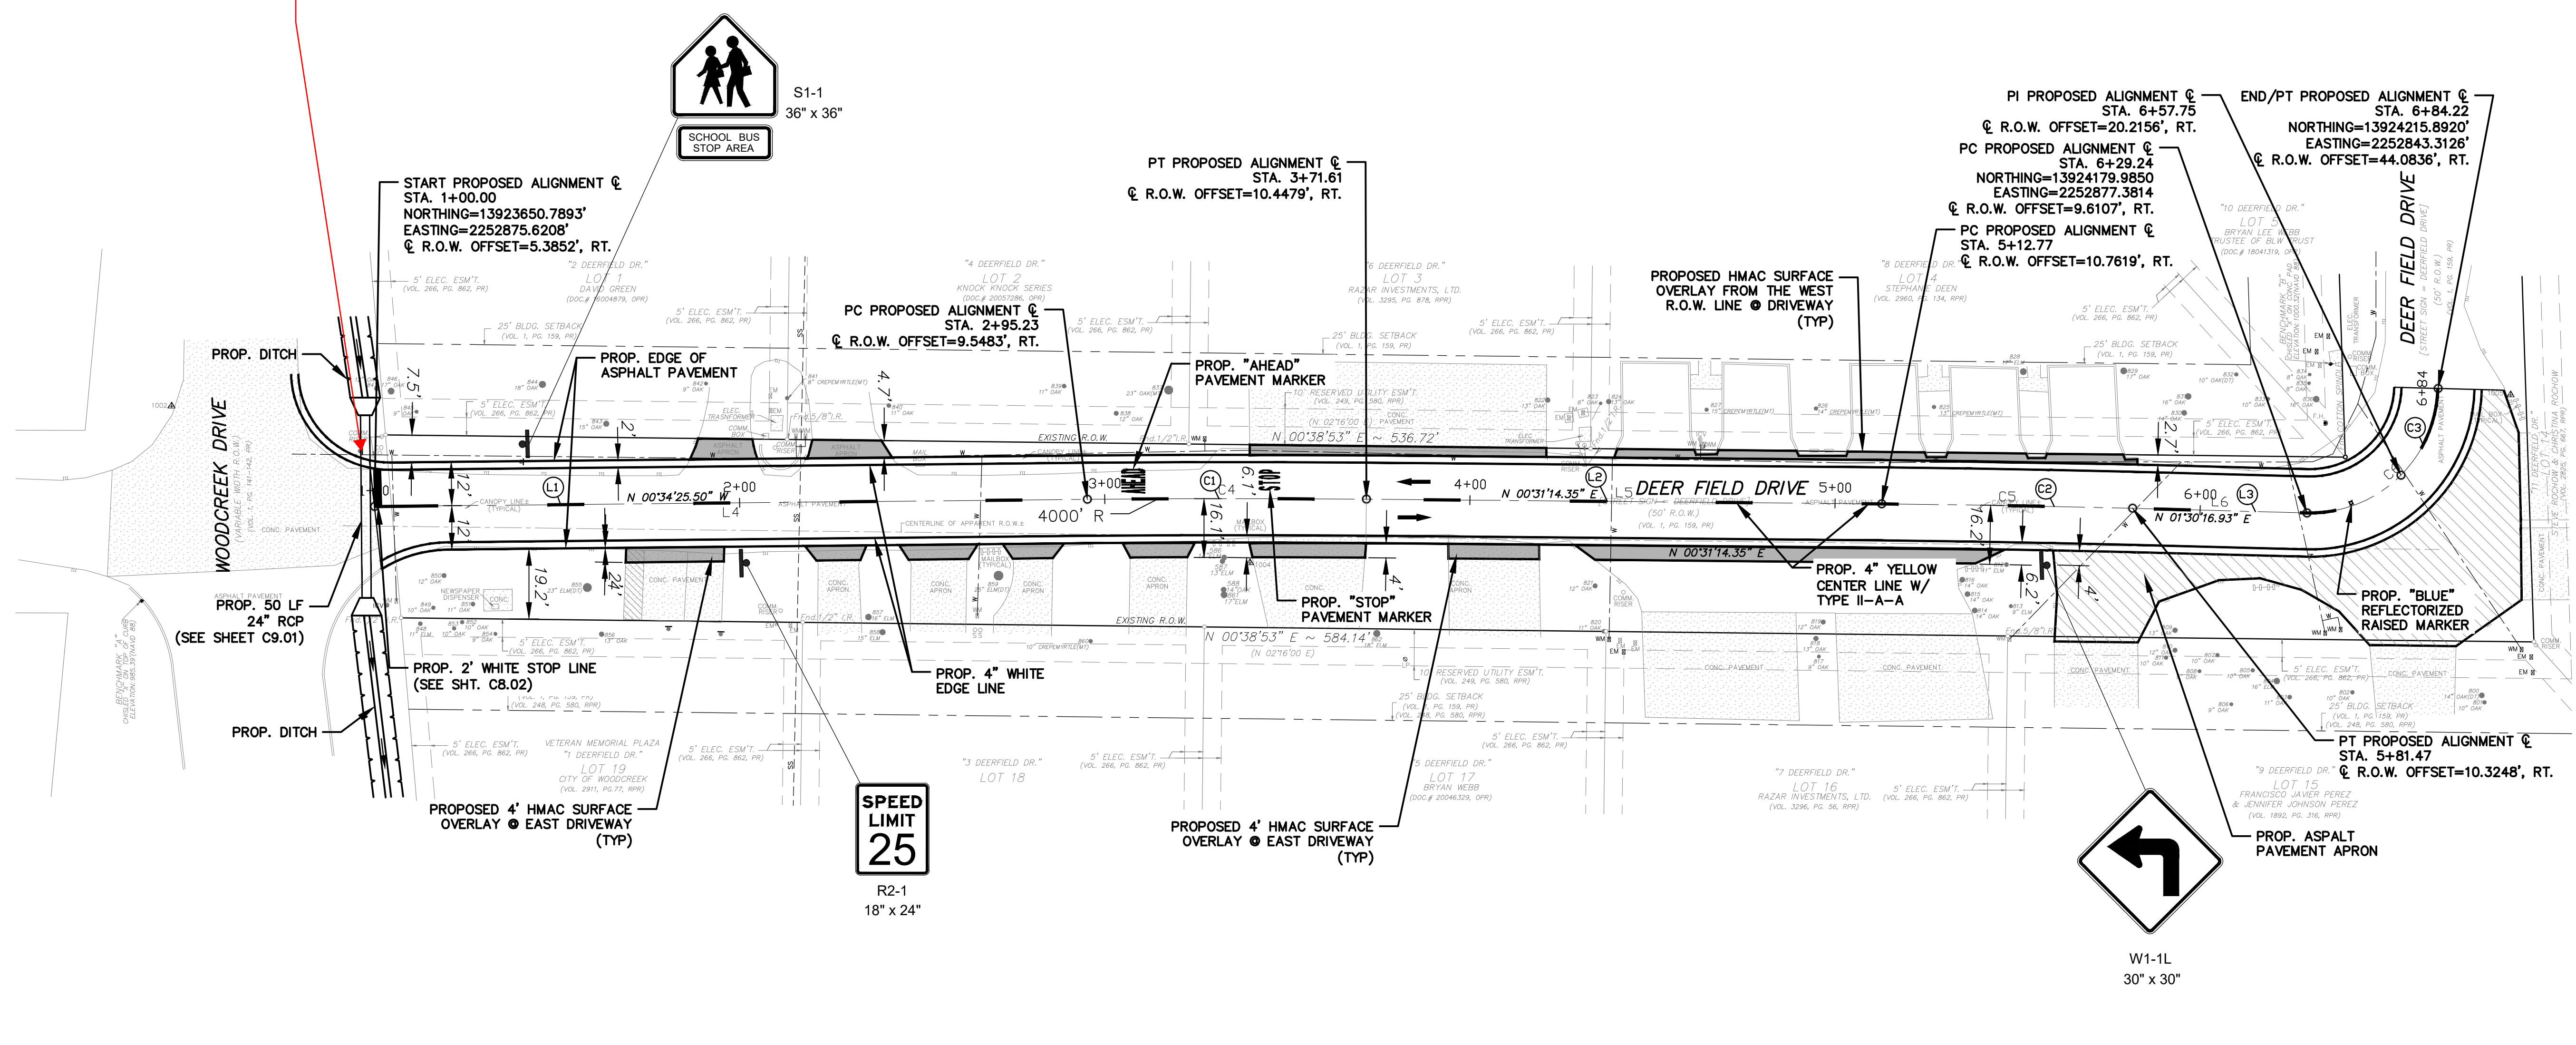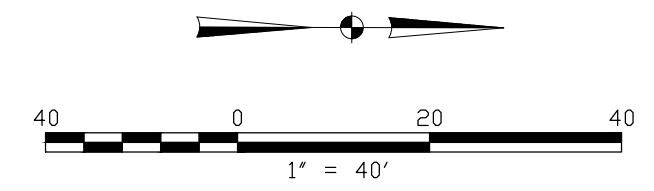

- LEGEND:**
- PROP. 2" "STOP LINE" PAVEMENT MARKING (SEE SHT. C8.02)
 - PROP. "AHEAD" WHITE PAVEMENT MARKING WORD
 - PROP. "STOP" WHITE PAVEMENT MARKING WORD
 - PROP. 4" "YELLOW" CENTER LINE W/ TYPE II-A-A
 - PROP. 4" WHITE EDGE LINE OF 2" SHOULDER
 - PROP. "BLUE" REFLECTORIZE TYPE II-B-B RAISED MARKER
 - PROP. ASPHALT PAVEMENT APRON
 - PROP. ASPHALT PAVEMENT @ DRIVEWAY

- NOTES:**
1. ALL OF THE PROPOSED MARKINGS SHOWN ARE TO BE INSTALLED IN ACCORDANCE WITH THE TEXAS DEPARTMENT OF TRANSPORTATION STANDARD PAVEMENT MARKING DETAILS AND THE TEXAS M.U.T.C.D. MANUAL, PART 3.
 2. CONTRACTOR SHALL REMOVE ANY EXISTING PAVEMENT MARKINGS IN ACCORDANCE WITH THE TEXAS DEPARTMENT OF TRANSPORTATION WHERE PROPOSED PAVEMENT MARKINGS ARE TO BE INSTALLED.
 3. CONTRACTOR TO FIELD VERIFY THE LOCATION AND LIMITS OF THE EXISTING OR PROPOSED ROADWAY BEFORE THE INSTALLATION OR REMOVAL OF ANY PAVEMENT MARKINGS.
 3. REFER TO SHEET C8.03 FOR SIGN MOUNTING DETAILS.

8204 Westglen Drive
Houston, Texas 77063
713.868.0001 WWW.TLCeng.com
F-4066

100% SUBMITTAL



CITY OF WOODCREEK
 DEERFIELD DRIVE
 WOODCREEK Texas, 78676

REVISION	NO.	DATE

PROJECT #
 ISSUE:
 DATE:
 DRAWN BY:

PAVEMENT MARKINGS AND SIGNAGE

C8.01
 1 OF 1

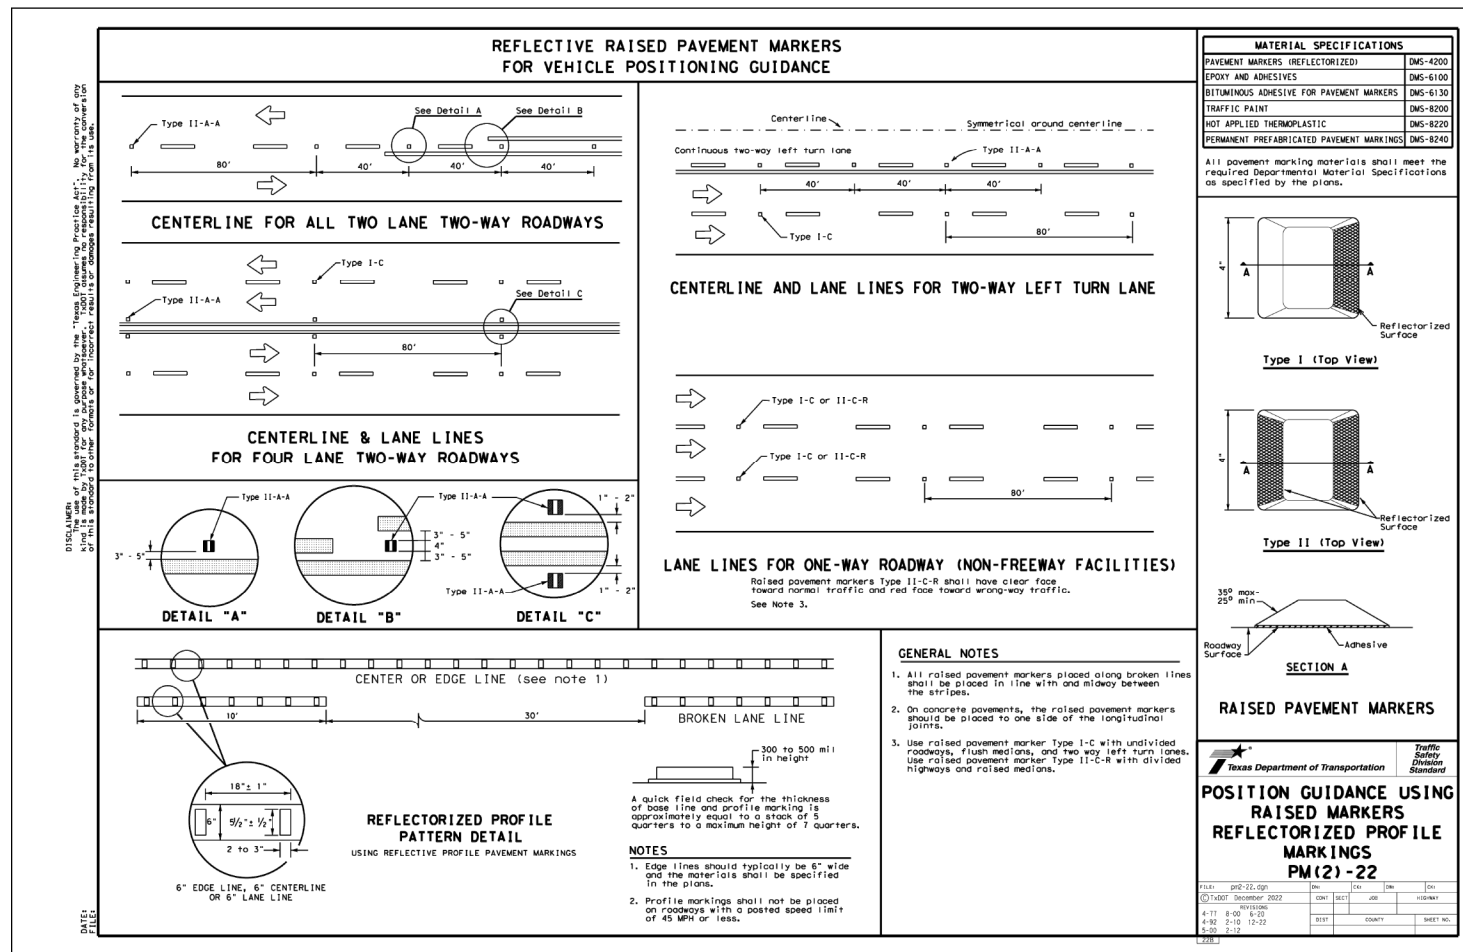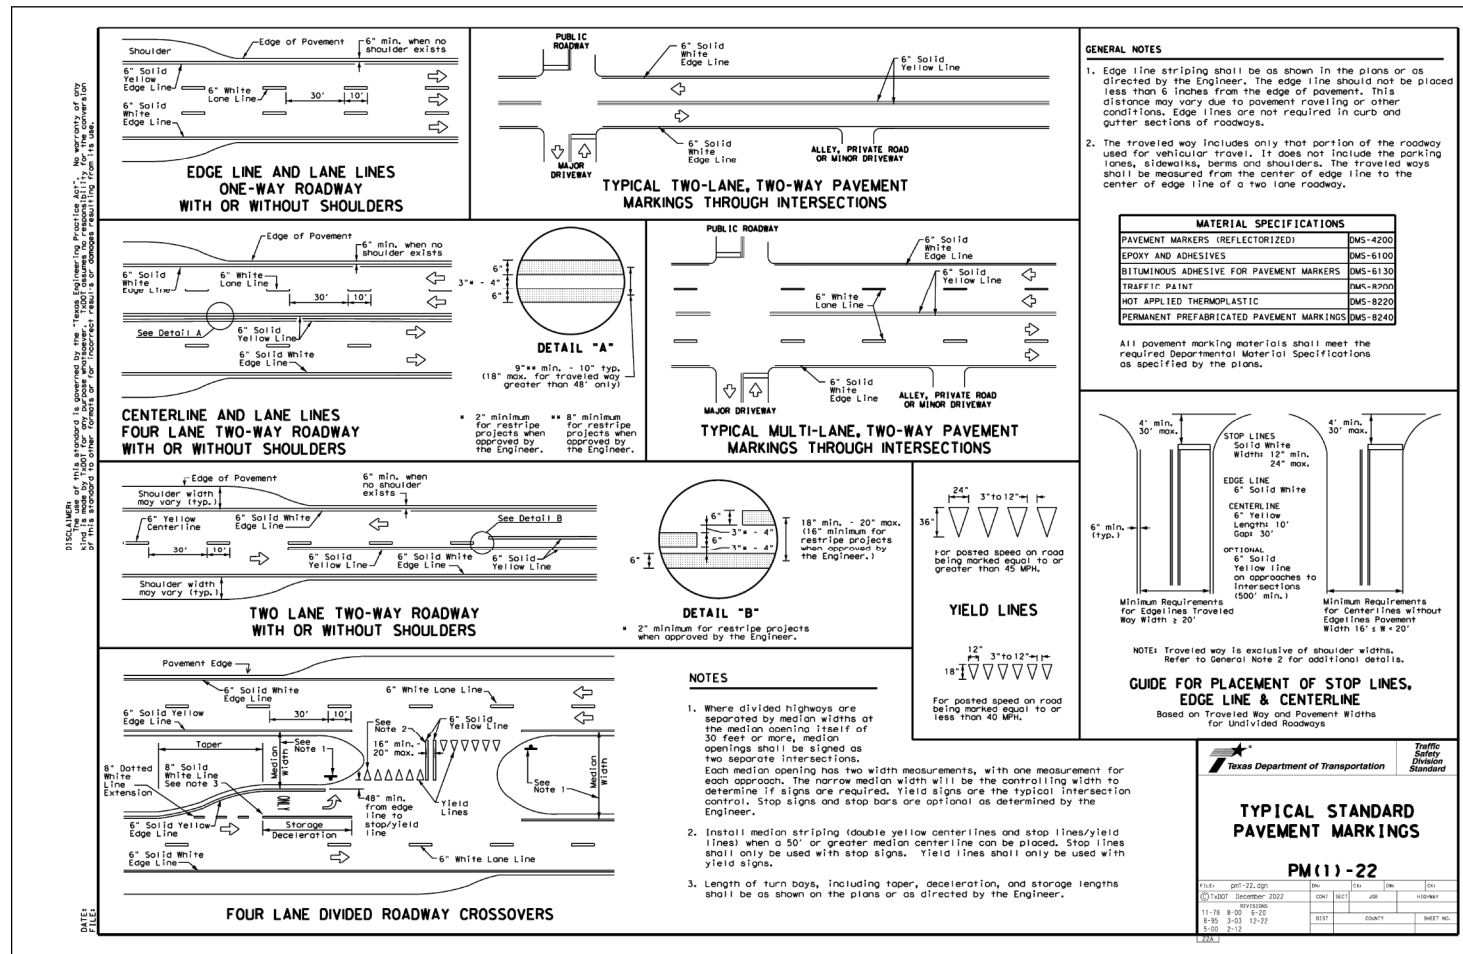

ENGINEERING
 8204 Westglen Drive
 Houston, Texas 77063
 713.868.0001 WWW.TLCeng.com
 F-4066



100% SUBMITTAL

CITY OF WOODCREEK
DEERFIELD DRIVE
WOODCREEK Texas, 78676

REVISION NO.	DATE


PROJECT #
 ISSUE:
 DATE:
 DRAWN BY:

PAVEMENT MARKINGS DETAILS

C8.02

DISCLAIMER: The use of this drawing is governed by the terms, conditions and provisions of the contract. No warranty of any kind is made by the Engineer for the design or construction of the project. The Engineer shall not be responsible for any damage resulting from the use of this drawing.

TRIANGULAR SLIPBASE INSTALLATION GENERAL REQUIREMENTS

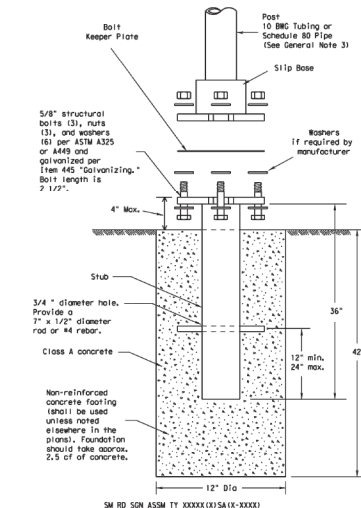


NOTE
There are various devices approved for the Triangular Slipbase System. Please reference the Material Producer List for approved slip base systems. http://www.txdot.gov/business/producer_list.htm The devices shall be installed per manufacturer's recommendations. Installation procedures shall be provided to the Engineer by Contractor.

- GENERAL NOTES:**
- Slip base shall be permanently marked to indicate manufacturer, Method, design, and location of marking are subject to approval of the TxDOT Traffic Standards Engineer.
 - Material used as post with this system shall conform to the following specifications:
 - 10 BNC Tubing (2.675" outside diameter)
 - 0.134" nominal wall thickness
 - Seamless or electric-resistance welded steel tubing or pipe
 - Steel shall be A513 or 55 per ASTM A1011 or ASTM A1008
 - Other steels may be used if they meet the following:
 - 50,000 PSI minimum yield strength
 - 70,000 PSI minimum tensile strength
 - 20% minimum elongation in 2"
 - Wall thickness (uncoated) shall be within the range of 0.122" to 0.138"
 - Outside diameter (uncoated) shall be within the range of 2.667" to 2.683"
 - Galvanization per ASTM A123 or ASTM A581 G15. For precast steel tubing (ASTM A653), recast schedule 80 pipe (2.875" outside diameter)
 - 0.276" nominal wall thickness
 - Steel tubing per ASTM A307 or C
 - Other seamless or electric-resistance welded steel tubing or pipe with equivalent outside diameter and wall thickness may be used if they meet the following:
 - 46,000 PSI minimum yield strength
 - 62,000 PSI minimum tensile strength
 - 21% minimum elongation in 2"
 - Wall thickness (uncoated) shall be within the range of 0.248" to 0.304"
 - Outside diameter (uncoated) shall be within the range of 2.855" to 2.885"
 - Galvanization per ASTM A123
 - See the Traffic Operations Division website for detailed drawings of sign clips and Texas Universal Triangular Slipbase System components. The website address is <http://www.txdot.gov/publications/traffic.htm>
 - Sign supports shall not be applied except where shown. Sign support posts shall not be applied.

- ASSEMBLY PROCEDURE**
- Foundation:
 - Prepare 12-inch diameter by 42-inch deep hole. If solid rock is encountered, the depth of the foundation may be reduced such that it is embedded a minimum of 18 inches into the solid rock.
 - The Engineer may permit bottom of concrete less than 2 cubic yards, to be mixed with a portable, motor-or-man concrete mixer. For small placements less than 0.5 cubic yards, hand mixing in a suitable container may be allowed by Engineer. Concrete shall be Class A.
 - Push the pipe and end of the slip base stub into the center of the concrete. Rotate the stub back and forth until it is pushing it down into the concrete to ensure good contact between the concrete and stub. Continue to work the stub into the concrete until it is between 2 to 4 inches above the ground.
 - Place the stub. Allow a minimum of 4 days to set, unless otherwise directed by the Engineer.
 - The triangular slipbase system is multidirectional and is designed to release when struck from any direction.
 - Support:
 - Cut support so that the bottom of the sign will be 7 to 7.5 feet above the edge of the roadway (i.e., edge of the closest lane) when slip plate is below the edge of pavement or 7 to 7.5 feet above slip plate when the slip plate is above the edge of the roadway. The cut shall be square and straight.
 - Attach sign to support using connections shown. When multiple signs are installed on the same support, ensure the minimum clearance between each sign is maintained. See SMD(SLP-2) for clearances based on sign types.

CONCRETE ANCHOR

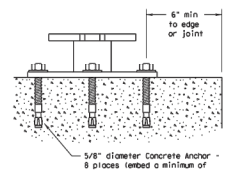

Concrete anchor consists of 5/8" diameter stud bolt with UNC series bolt threads on the upper end, heavy hex nut per ASTM A563, and hardened washer per ASTM F436. The stud bolt shall have a minimum yield and ultimate tensile strength of 50 and 75 ksi, respectively. Nuts, bolts and washers shall be galvanized per Item 445, "Galvanizing." Adhesive type anchors shall have stud bolts installed with type III epoxy per SMD-6100, "Epoxy and Adhesives." Adhesive anchors may be loaded after adequate epoxy cure time per the manufacturer's recommendations. Top of bolt shall extend at least flush with top of the nut when installed. The anchor, when installed in 4000 psi normal weight concrete with a 1/2" minimum embedment, shall have a minimum of tensile strength and shear of 3900 and 3100 psi, respectively.


Texas Department of Transportation
Traffic Operations Division

**SIGN MOUNTING DETAILS
SMALL ROADSIDE SIGNS
TRIANGULAR SLIPBASE SYSTEM**

SMD (SLIP-1) - 08

DATE: July 2002	REV:	BY:	CHK:	APP:	DATE:
9-08	1				

DISCLAIMER: The use of this drawing is governed by the terms, conditions and provisions of the contract. No warranty of any kind is made by the Engineer for the design or construction of the project. The Engineer shall not be responsible for any damage resulting from the use of this drawing.

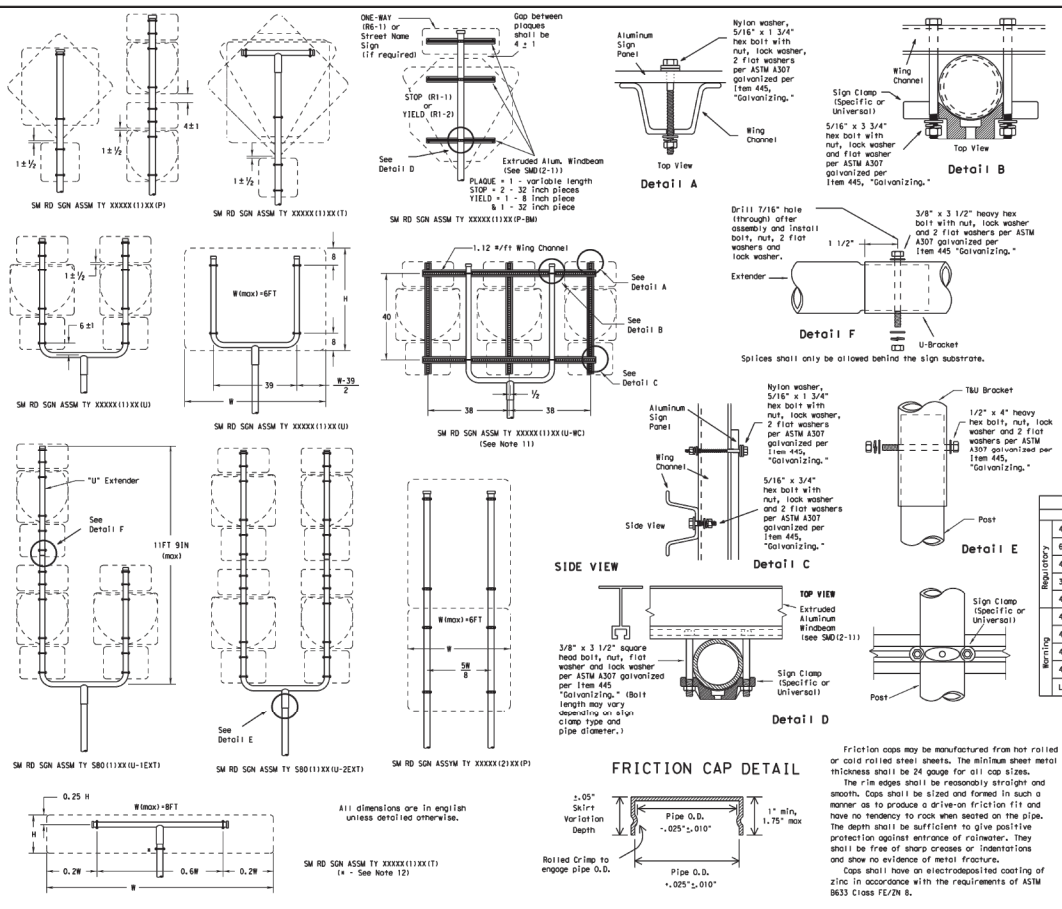

GENERAL NOTES:

- Sign supports shall be permanently marked to indicate manufacturer, Method, design, and location of marking are subject to approval of the TxDOT Traffic Standards Engineer.
- Material used as post with this system shall conform to the following specifications:
 - 10 BNC Tubing (2.675" outside diameter)
 - 0.134" nominal wall thickness
 - Seamless or electric-resistance welded steel tubing or pipe
 - Steel shall be A513 or 55 per ASTM A1011 or ASTM A1008
 - Other steels may be used if they meet the following:
 - 50,000 PSI minimum yield strength
 - 70,000 PSI minimum tensile strength
 - 20% minimum elongation in 2"
 - Wall thickness (uncoated) shall be within the range of 0.122" to 0.138"
 - Outside diameter (uncoated) shall be within the range of 2.667" to 2.683"
 - Galvanization per ASTM A123 or ASTM A581 G15. For precast steel tubing (ASTM A653), recast schedule 80 pipe (2.875" outside diameter)
 - 0.276" nominal wall thickness
 - Steel tubing per ASTM A307 or C
 - Other seamless or electric-resistance welded steel tubing or pipe with equivalent outside diameter and wall thickness may be used if they meet the following:
 - 46,000 PSI minimum yield strength
 - 62,000 PSI minimum tensile strength
 - 21% minimum elongation in 2"
 - Wall thickness (uncoated) shall be within the range of 0.248" to 0.304"
 - Outside diameter (uncoated) shall be within the range of 2.855" to 2.885"
 - Galvanization per ASTM A123
 - See the Traffic Operations Division website for detailed drawings of sign clips and Texas Universal Triangular Slipbase System components. The website address is <http://www.txdot.gov/publications/traffic.htm>
 - Sign supports shall not be applied except where shown. Sign support posts shall not be applied.

REQUIRED SUPPORT

SIGN DESCRIPTION	SUPPORT
48-inch STOP sign (81-1)	TY 10BNC(11)X(11)
60-inch YIELD sign (81-2)	TY 10BNC(11)X(11)
48x16-inch ONE-BAY sign (88-1)	TY 10BNC(11)X(11)
36x48, 48x36, and 48x48-inch signs	TY 10BNC(11)X(11)
48x60-inch signs	TY 580(11)X(11)
48x48-inch signs (diamond or square)	TY 10BNC(11)X(11)
48x60-inch signs	TY 580(11)X(11)
48-inch Advance School X-ing sign (51-1)	TY 10BNC(11)X(11)
48-inch School X-ing sign (52-1)	TY 10BNC(11)X(11)
Large Arrow sign (81-6 & 81-7)	TY 10BNC(11)X(11)

Texas Department of Transportation
Traffic Operations Division

**SIGN MOUNTING DETAILS
SMALL ROADSIDE SIGNS
TRIANGULAR SLIPBASE SYSTEM**

SMD (SLIP-2) - 08

DATE: July 2002	REV:	BY:	CHK:	APP:	DATE:
9-08	1				



ENGINEERING
8204 Westglen Drive
Houston, Texas 77063
713.868.0001 WWW.TLCeng.com
F-4066



100% SUBMITTAL

CITY OF WOODCREEK
DEERFIELD DRIVE
WOODCREEK Texas, 78676

REVISION


NO.	DATE

PROJECT #
ISSUE:
DATE:
DRAWN BY:

SIGN MOUNTING
DETAILS
C8.03

PATH: Z:\2022 Open Projects\Woodcreek, Tx Engineering Project TDA\CADD\100% Submittal\DEERFIELD DRIVE_CULVERT-EXHIBIT.dwg
 USER: Jan 02, 2025 10:16am jsmart
 PLOT TAB: CULVERT EXHIBIT


ADD PROVISION FOR STEEL PLATING OVER CONCRETE FOR CURING. THIS WOULD INCLUDE CONCRETE CURBS AS WELL

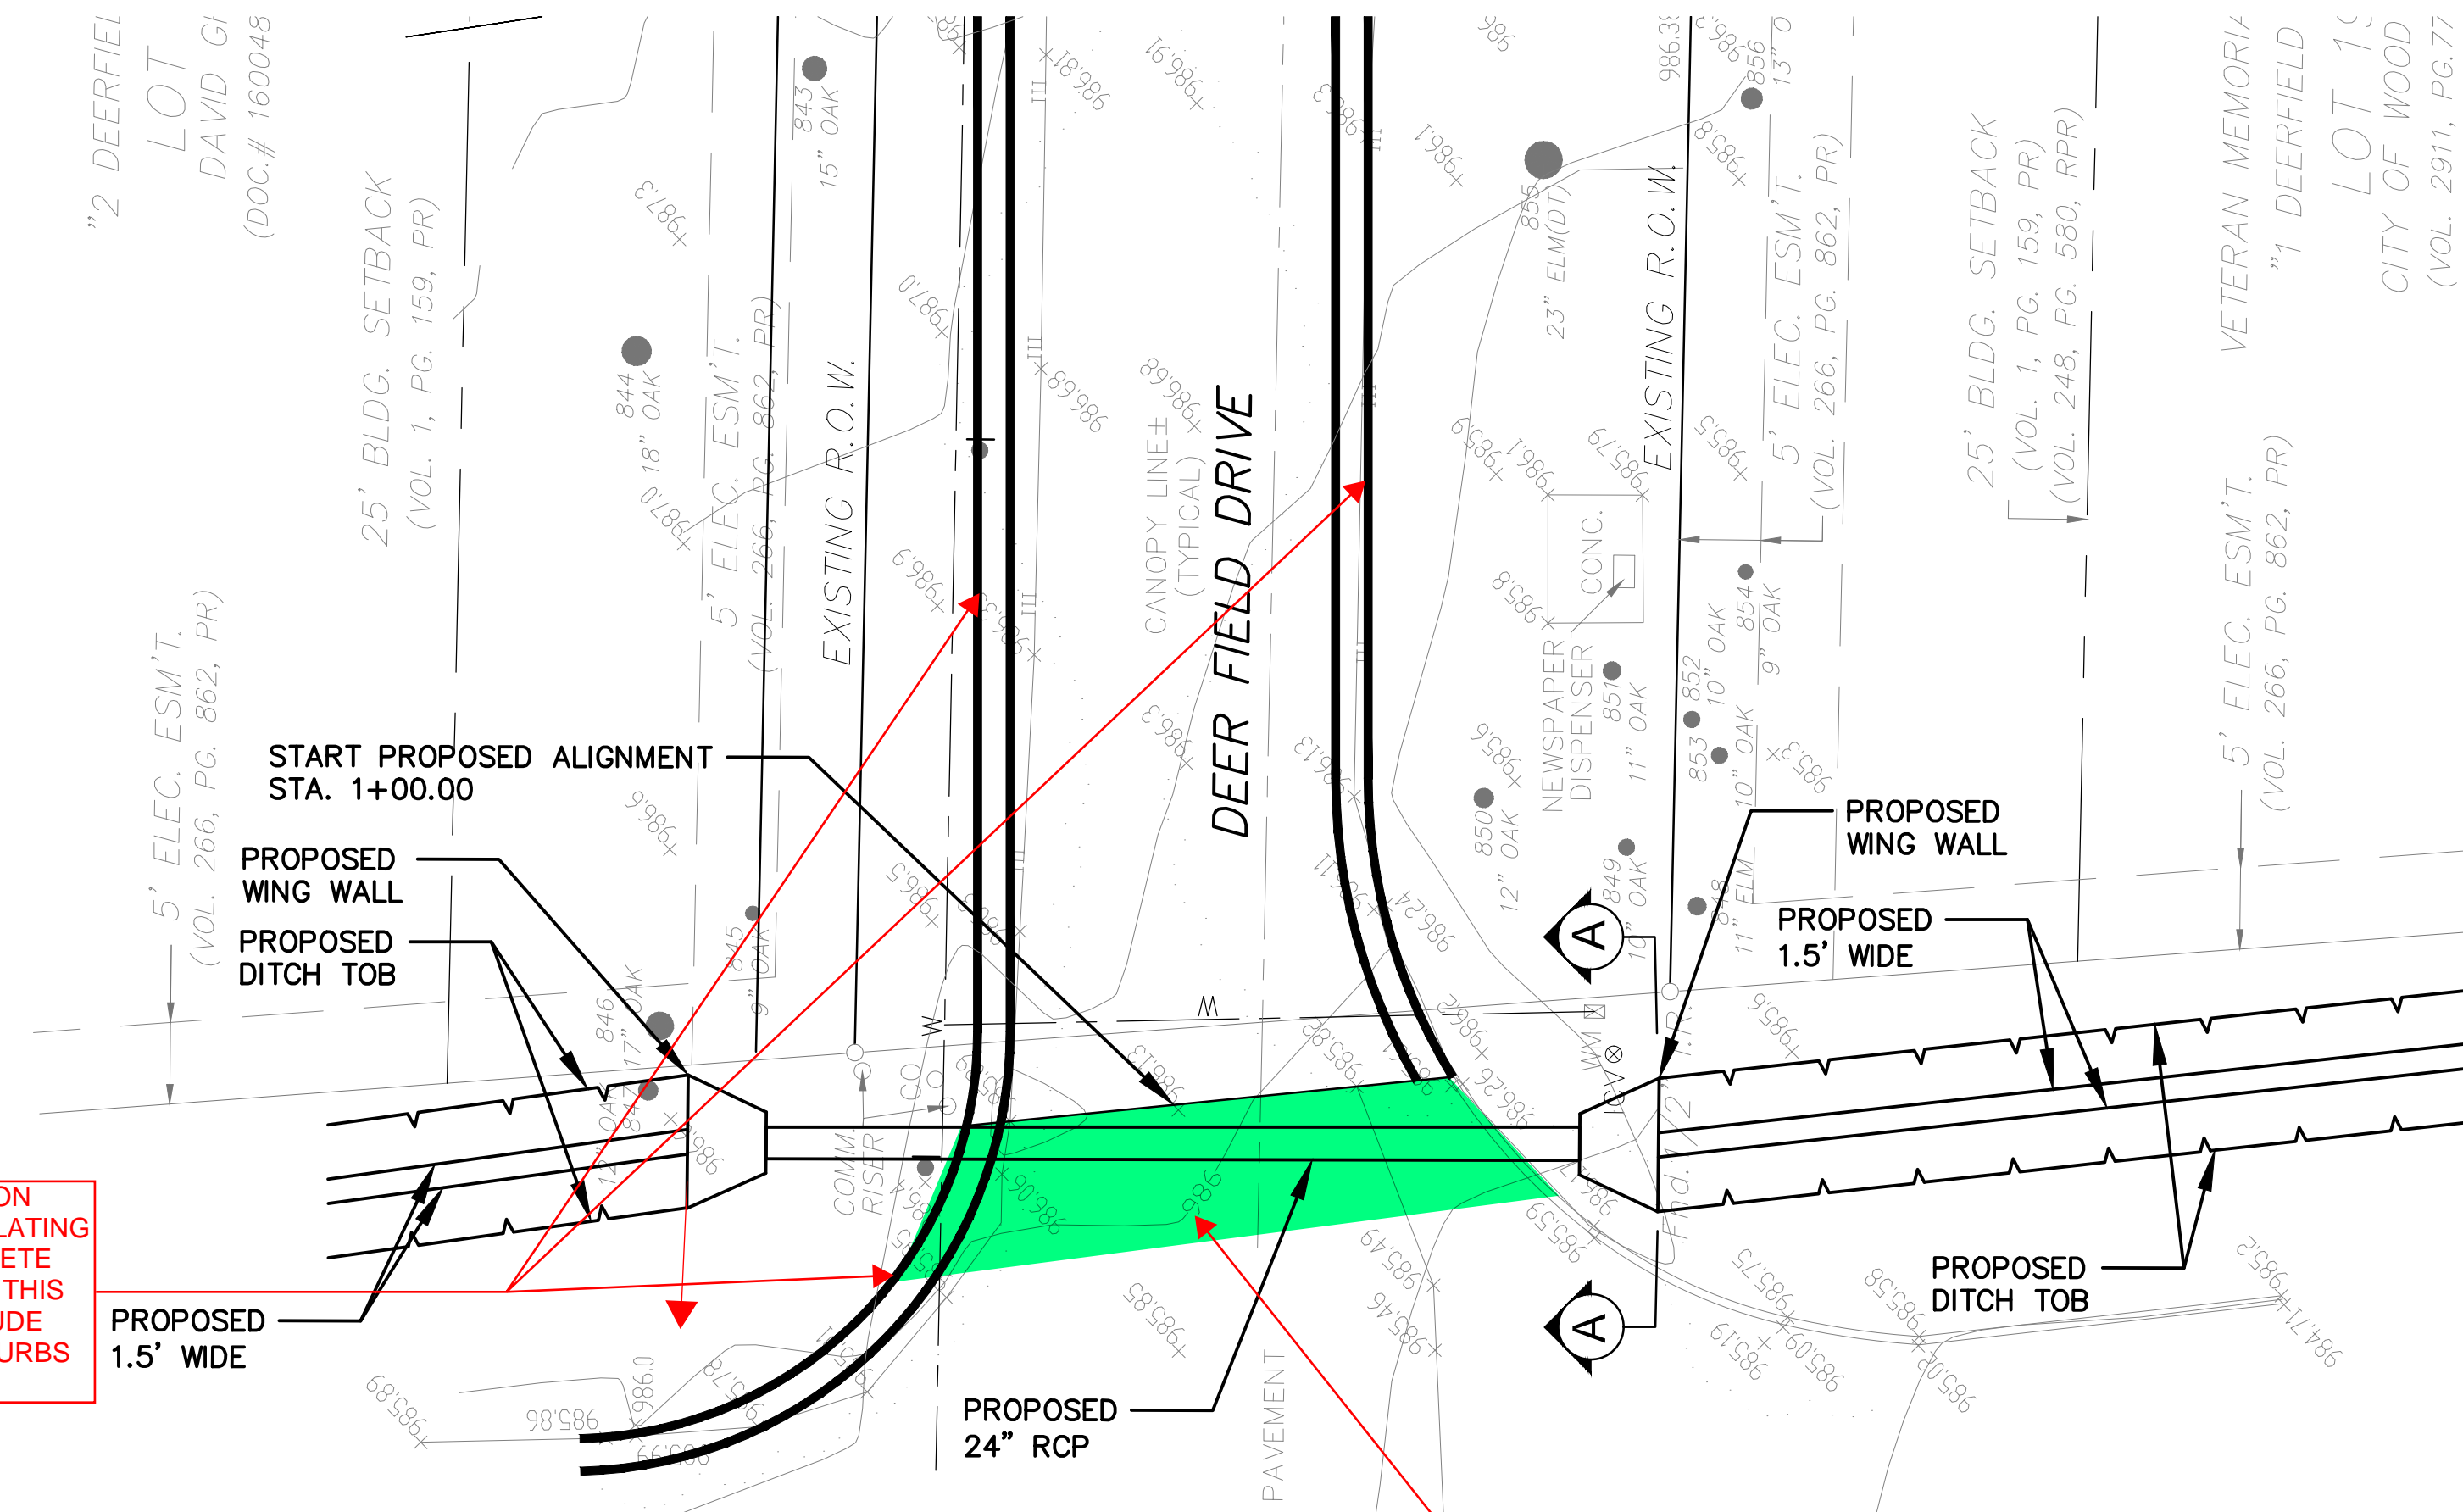



MAKE TRENCH REPAIR CONCRETE SECTION ON C7.02 TO REDUCE MINIMUM COVER DISTANCE OVER PIPE. CAN THEN HAVE 10' MIN ON COVER

EXHIBIT NOTES:


1. PROPOSED SWALE ON E SIDE OF DEERCREEK TO BE GRADED AT MINIMUM 1%.
2. FIELD VERIFY LOCATION OF WATERLINE TO ENSURE NO CONFLICT WITH PROPOSED 24" CULVERT.
3. SIDE SLOPE ON SWALE MAXIMUM TO BE 1:1.
4. WINGWALL DETAIL SEE TXDOT STANDARD REFERENCED IN SHEET C9.02.

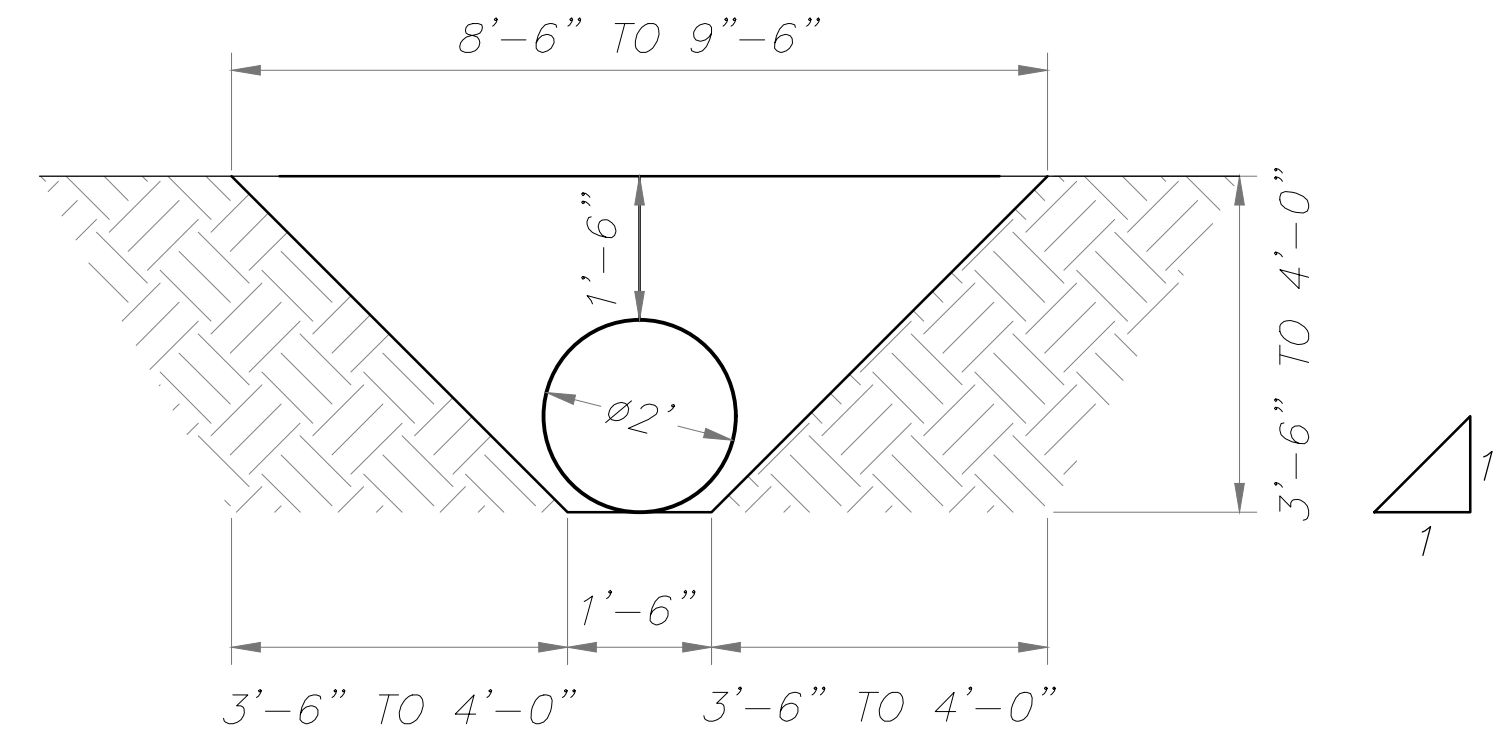

SECTION "A-A"

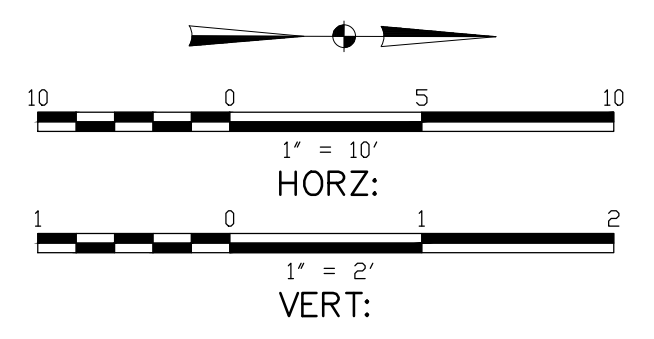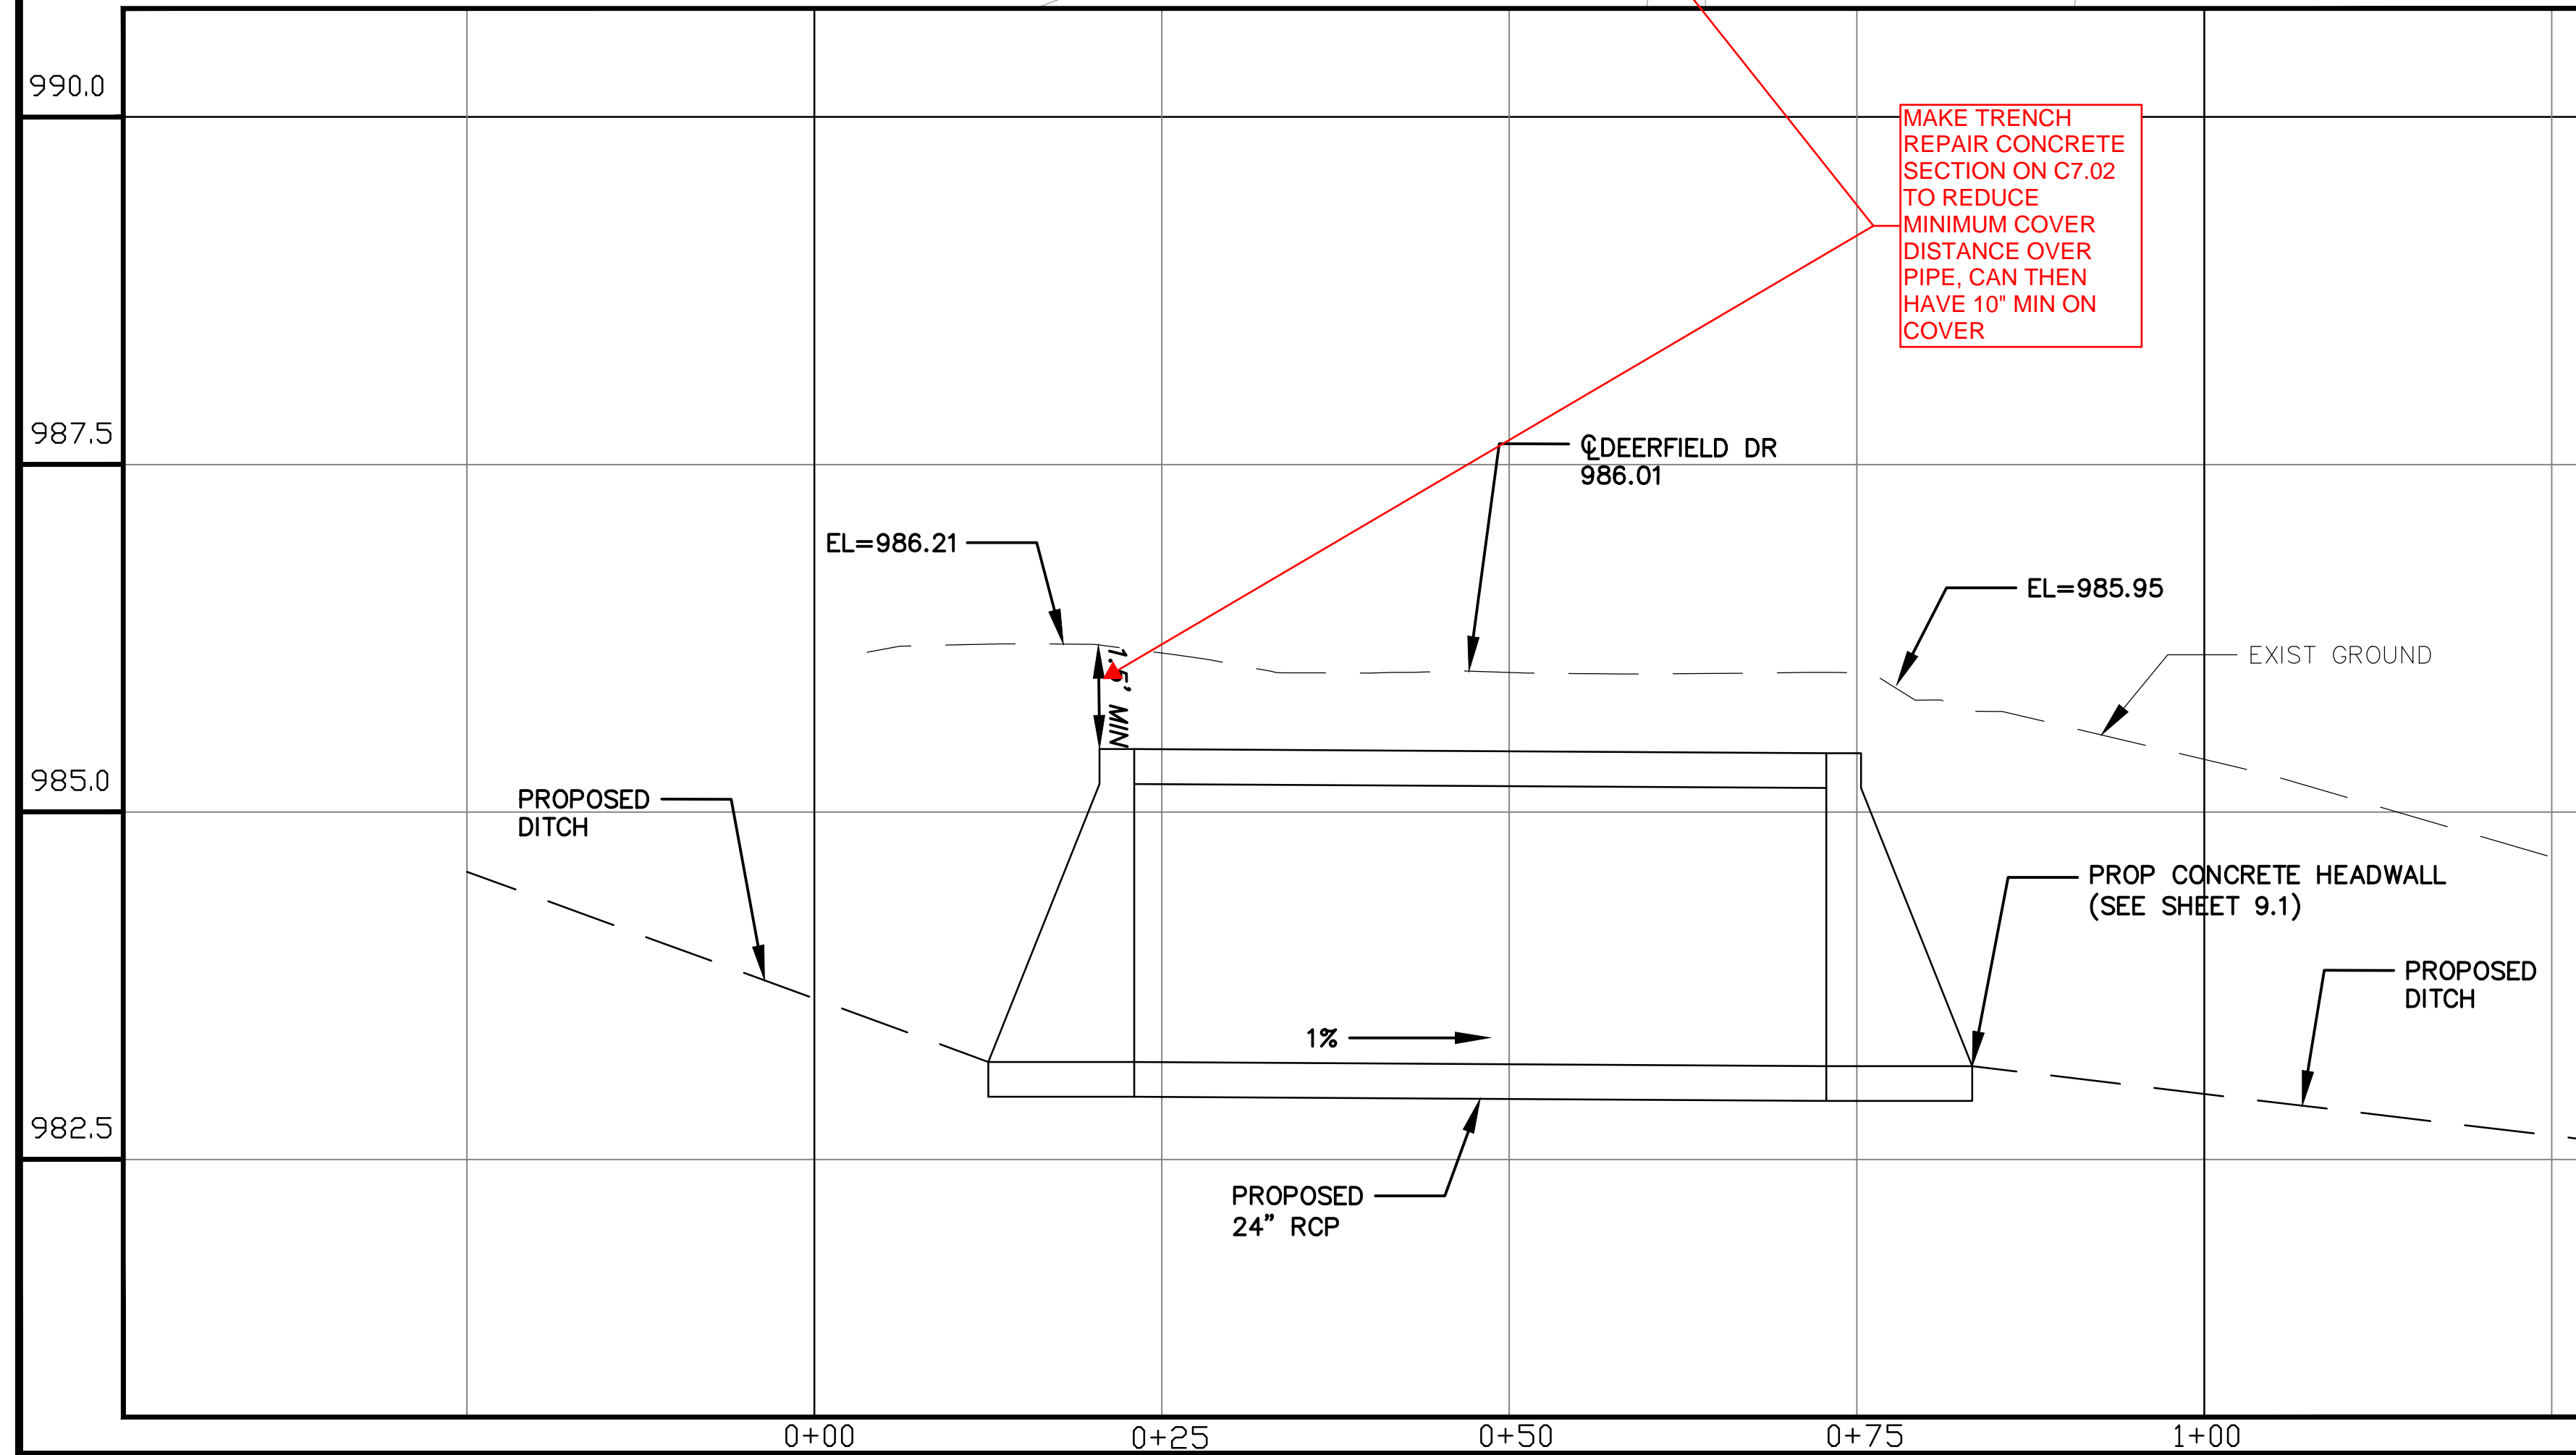

TLC
ENGINEERING
 8204 Westglenn Drive
 Houston, Texas 77063
 713.868.0001 WWW.TLCeng.com
 F-4066

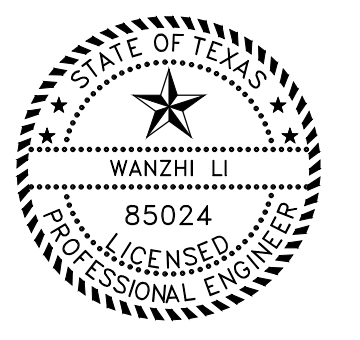

100% SUBMITTAL

CITY OF WOODCREEK
 DEERFIELD DRIVE
 WOODCREEK Texas, 78676

REVISION NO.	DATE

PROJECT #
 ISSUE:
 DATE:
 DRAWN BY:

CULVERT EXHIBIT

C9.01
 1 OF 1



ENGINEERING
 8204 Westglen Drive
 Houston, Texas 77063
 713.868.0001 WWW.TLCeng.com
 E-4066



100% SUBMITTAL

CITY OF WOODCREEK
DEERFIELD DRIVE
WOODCREEK Texas, 78676

TABLE OF VARIABLE DIMENSIONS AND QUANTITIES FOR ONE HEADWALL

Values to be Added for Each Add'l Pipe

Slope	Dia of Pipe (D)	Values for One Pipe				Reinf (lbs)	Conc (CY)	Values to be Added for Each Add'l Pipe	
		W	X	Y	L			X and W	Reinf (lbs)
12°	4'-7 1/2"	2'-6"	2'-10"	3'-3 1/2"	88	0.6	1'-9"	20	0.2
15°	5'-5 1/2"	2'-9 1/2"	3'-4"	3'-10 1/2"	103	0.7	2'-2"	24	0.3
18°	6'-4 1/2"	2'-1"	3'-10"	4'-5"	124	0.9	2'-8"	32	0.3
21°	7'-2 1/2"	2'-4 1/2"	4'-4"	5'-0"	143	1.1	3'-1"	43	0.4
24°	8'-2 1/2"	2'-9 1/2"	4'-10"	5'-7"	164	1.3	3'-7"	50	0.5
27°	9'-1"	4'-1"	5'-4"	6'-2"	179	1.5	3'-11"	56	0.6
30°	9'-11 1/2"	4'-4 1/2"	5'-10"	6'-8 3/4"	203	1.7	4'-4"	65	0.8
33°	10'-10"	4'-8"	6'-4"	7'-3 3/4"	224	2.0	4'-8"	71	0.9
36°	11'-8 1/2"	4'-11 1/2"	6'-10"	7'-10 1/2"	249	2.2	5'-1"	81	1.0
42°	13'-5 1/2"	5'-6 1/2"	7'-10"	9'-0 1/2"	298	2.8	5'-10"	97	1.3
48°	15'-9"	6'-1 1/2"	9'-4"	10'-9 1/4"	360	3.0	6'-7"	117	1.7
54°	17'-5 1/2"	6'-8 3/4"	10'-4"	11'-11 1/2"	427	4.5	7'-6"	151	2.1
60°	19'-2 1/2"	7'-9 1/2"	11'-4"	13'-9 1/2"	481	5.3	8'-5"	174	2.5
66°	20'-11 1/2"	7'-10 1/2"	12'-4"	14'-3"	544	6.2	8'-9"	194	2.9
72°	22'-8 1/2"	8'-5 1/2"	13'-4"	15'-4 3/4"	601	7.1	9'-4"	213	3.3
12°	6'-3"	2'-6"	4'-3"	4'-11"	118	0.8	1'-9"	22	0.2
15°	7'-5"	2'-9 1/2"	5'-0"	5'-9 1/2"	137	1.1	2'-2"	28	0.3
18°	8'-6 1/2"	2'-1"	5'-9"	6'-7 3/4"	170	1.3	2'-8"	37	0.5
21°	9'-8 1/2"	2'-4 1/2"	7'-6"	7'-6"	195	1.6	3'-1"	48	0.6
24°	11'-0"	2'-9 1/2"	8'-4 1/2"	8'-4 1/2"	221	2.0	3'-7"	58	0.7
27°	12'-2"	4'-1"	8'-0"	9'-2 3/4"	251	2.3	3'-11"	67	0.8
30°	13'-4"	4'-4 1/2"	8'-9"	10'-1 1/2"	293	2.7	4'-4"	77	1.0
33°	14'-5 1/2"	4'-8"	9'-6"	10'-11 1/2"	318	3.1	4'-8"	84	1.2
36°	15'-7 1/2"	4'-11 1/2"	10'-3"	11'-10"	351	3.5	5'-1"	96	1.4
42°	17'-11 1/2"	5'-6 1/2"	11'-9"	13'-6 3/4"	432	4.5	5'-10"	119	1.7
48°	21'-1 1/2"	6'-1 1/2"	14'-0"	16'-2"	537	6.1	6'-7"	146	2.3
54°	23'-5 1/2"	6'-8 3/4"	15'-0"	17'-10 1/2"	630	7.3	7'-6"	186	2.9
60°	25'-9 1/2"	7'-3 1/2"	17'-0"	19'-7 1/2"	719	8.7	8'-3"	219	3.4
66°	28'-1"	7'-10 1/2"	18'-6"	21'-4 1/4"	811	10.1	8'-9"	242	3.9
72°	30'-4 1/2"	8'-5 1/2"	20'-0"	23'-1 1/4"	924	11.7	9'-4"	272	4.4
12°	7'-10 1/2"	2'-6"	5'-8"	6'-6 1/2"	148	1.1	1'-9"	24	0.3
15°	9'-4"	2'-9 1/2"	6'-8"	7'-8 1/2"	181	1.5	2'-2"	32	0.4
18°	10'-9 1/2"	2'-1"	7'-8"	8'-10 1/4"	221	1.9	2'-8"	42	0.5
21°	12'-2 1/2"	2'-4 1/2"	8'-0"	10'-0"	260	2.3	3'-1"	57	0.7
24°	13'-9 1/2"	2'-9 1/2"	9'-0"	11'-2"	301	2.8	3'-7"	67	0.8
27°	15'-3"	4'-1"	10'-8"	12'-3 3/4"	334	3.3	3'-11"	77	1.0
30°	16'-8 1/2"	4'-4 1/2"	11'-8"	13'-5 3/4"	385	3.8	4'-4"	89	1.3
33°	18'-1 1/2"	4'-8"	12'-8"	14'-7 1/2"	425	4.5	4'-8"	101	1.4
36°	19'-7"	4'-11 1/2"	13'-8"	15'-9 1/4"	472	5.1	5'-1"	115	1.7
42°	22'-5 1/2"	5'-6 1/2"	15'-8"	18'-1"	583	6.5	5'-10"	141	2.1
48°	26'-6 1/2"	6'-1 1/2"	18'-0"	21'-6 1/4"	730	8.9	6'-7"	175	2.8
54°	29'-5"	6'-8 3/4"	20'-0"	23'-10 1/2"	855	10.7	7'-6"	226	3.6
60°	32'-3 1/2"	7'-3 1/2"	22'-8"	26'-2"	996	12.7	8'-3"	264	4.3
66°	35'-2 1/2"	7'-10 1/2"	24'-8"	28'-5 3/4"	1,140	14.9	8'-9"	300	4.9
72°	38'-1 1/2"	8'-5 1/2"	26'-8"	30'-9 1/2"	1,297	17.3	9'-4"	334	5.6
12°	11'-2"	2'-6"	8'-6"	9'-9 3/4"	224	1.9	1'-9"	28	0.4
15°	13'-2 1/2"	2'-9 1/2"	10'-0"	11'-6 1/2"	268	2.5	2'-2"	37	0.5
18°	15'-2 1/2"	2'-1"	11'-6"	13'-3 1/4"	330	3.2	2'-8"	50	0.7
21°	17'-2 1/2"	2'-4 1/2"	13'-0"	15'-0 1/4"	387	3.9	3'-1"	69	0.9
24°	19'-4 1/2"	2'-9 1/2"	14'-6"	16'-9"	453	4.8	3'-7"	80	1.2
27°	21'-4 1/2"	4'-1"	16'-0"	18'-5 3/4"	512	5.7	3'-11"	96	1.4
30°	23'-5 1/2"	4'-4 1/2"	17'-6"	20'-2 1/2"	593	6.7	4'-4"	110	1.7
33°	25'-5 1/2"	4'-8"	19'-0"	21'-11 1/2"	675	7.8	4'-8"	127	2.0
36°	27'-5 1/2"	4'-11 1/2"	20'-6"	23'-8"	735	9.0	5'-1"	144	2.3
42°	31'-6 1/2"	5'-6 1/2"	23'-6"	27'-1 1/2"	922	11.5	5'-10"	179	3.0
48°	37'-3 1/2"	6'-1 1/2"	28'-0"	32'-4"	1,191	15.9	6'-7"	231	4.0
54°	41'-4 1/2"	6'-8 3/4"	31'-0"	35'-9 1/2"	1,424	19.2	7'-6"	300	5.0
60°	45'-4 1/2"	7'-3 1/2"	34'-0"	39'-3"	1,631	22.9	8'-3"	353	6.0

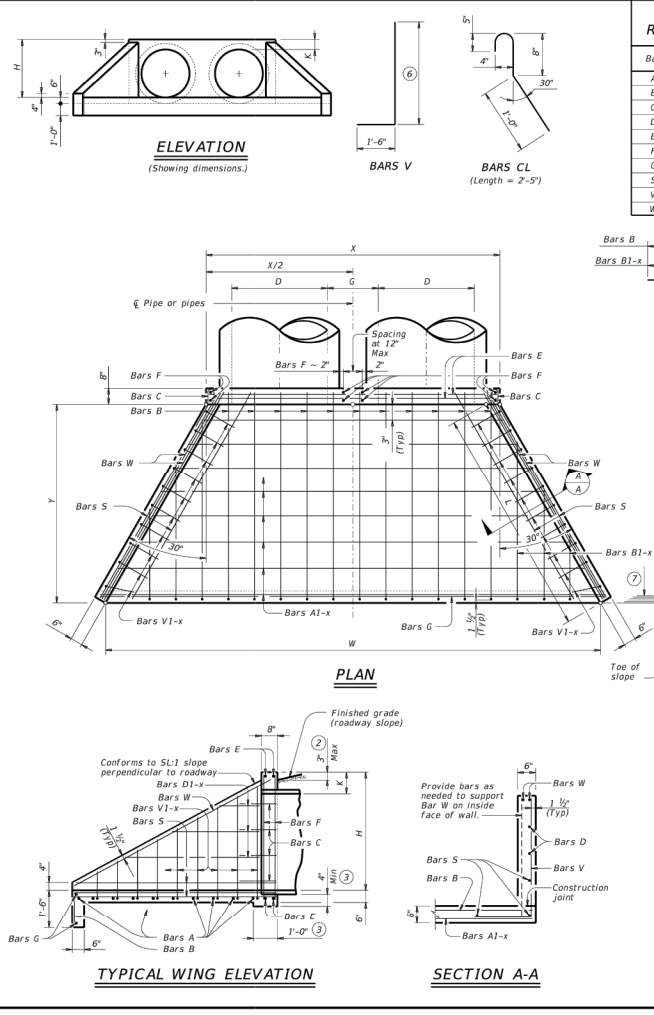


TABLE OF REINFORCING STEEL

Bar	Size	Spa	No.
A	#4	1'-0"	-
B	#3	1'-0"	-
C	#4	1'-0"	-
D	#3	1'-0"	-
E	#5	-	4
F	#5	-	-
G	#3	-	2
S	#4	-	6
V	#4	1'-0"	-
W	#5	-	4

- TABLE OF CONSTANT DIMENSIONS**
- | Dia of Pipe (D) | G | K (4) | H |
|-----------------|--------|-------|-------|
| 12" | 0'-9" | 1'-0" | 2'-0" |
| 15" | 0'-11" | 1'-0" | 2'-3" |
| 18" | 1'-2" | 1'-0" | 2'-6" |
| 21" | 1'-4" | 1'-0" | 2'-9" |
| 24" | 1'-7" | 1'-0" | 3'-0" |
| 27" | 1'-8" | 1'-0" | 3'-3" |
| 30" | 1'-10" | 1'-0" | 3'-6" |
| 33" | 1'-11" | 1'-0" | 3'-9" |
| 36" | 2'-1" | 1'-0" | 4'-0" |
| 42" | 2'-4" | 1'-0" | 4'-6" |
| 48" | 2'-7" | 1'-3" | 5'-3" |
| 54" | 3'-0" | 1'-3" | 5'-9" |
| 60" | 3'-3" | 1'-3" | 6'-3" |
| 66" | 3'-4" | 1'-3" | 6'-9" |
| 72" | 3'-4" | 1'-3" | 7'-3" |
- Quantities shown are for concrete pipe and will increase slightly for metal pipe installations.
 - For vehicle safety, construct curbs no more than 3" above finished grade. Reduce curb heights, if necessary, to meet these requirements. No changes will be made in quantities and no additional compensation will be allowed for this work.
 - Provide a 1'-0" footing as shown where required to maintain 4" minimum cover for sizes.
 - Dimensions shown are usual and maximum.
 - Quantities shown are for one structure end only (one headwall).
 - Min Length = $6' + 3' \times \left(\frac{12 \times H - 7}{12 \times L} \right)$
 Max Length = $12 \times H - 3' \times \left(\frac{12 \times H - 7}{12 \times L} \right) - 1'$
 - Lengths of wings based on SL1 slope along this line.
- MATERIAL NOTES:**
 Provide Grade 60 reinforcing steel.
 Provide Class C concrete (f'c = 3,600 psi).
- GENERAL NOTES:**
 Designed according to AASHTO LRFD Bridge Design Specifications.
 Do not mount bridge rails of any type directly to these culvert headwalls.
 This standard may not be used for wall heights, H, exceeding the values shown.
- Cover dimensions are clear dimensions, unless noted otherwise. Reinforcing dimensions are out-to-out of bars.

Texas Department of Transportation Bridge Division Standard

CONCRETE HEADWALLS WITH FLARED WINGS FOR 0° SKEW PIPE CULVERTS

CH-FW-0

Rev: CD-CH-FW-0-01p
 February 2010

REV	DATE	BY	CHK	APP	REASON

DISCLAIMER: This standard is prepared by the Texas Engineering Practice Act. No warranty or liability is made by TCEC for any purpose whatsoever. TCEC assumes no responsibility for the construction of this standard or for incorrect results or damages resulting from its use.

DATE: _____

REVISION

NO.	DATE

PROJECT # _____
 ISSUE: _____
 DATE: _____
 DRAWN BY: _____

CULVERT DETAILS

C9.02