



Change: 1/10/16
Ratified

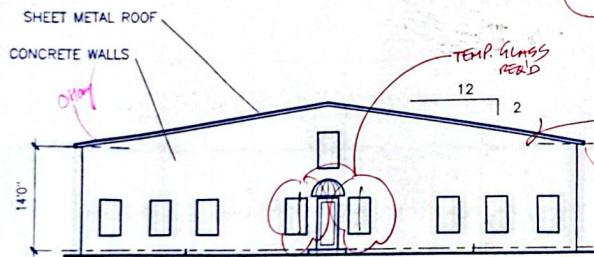

FRONT ELEVATION

SCALE: 1/8" = 1'0"

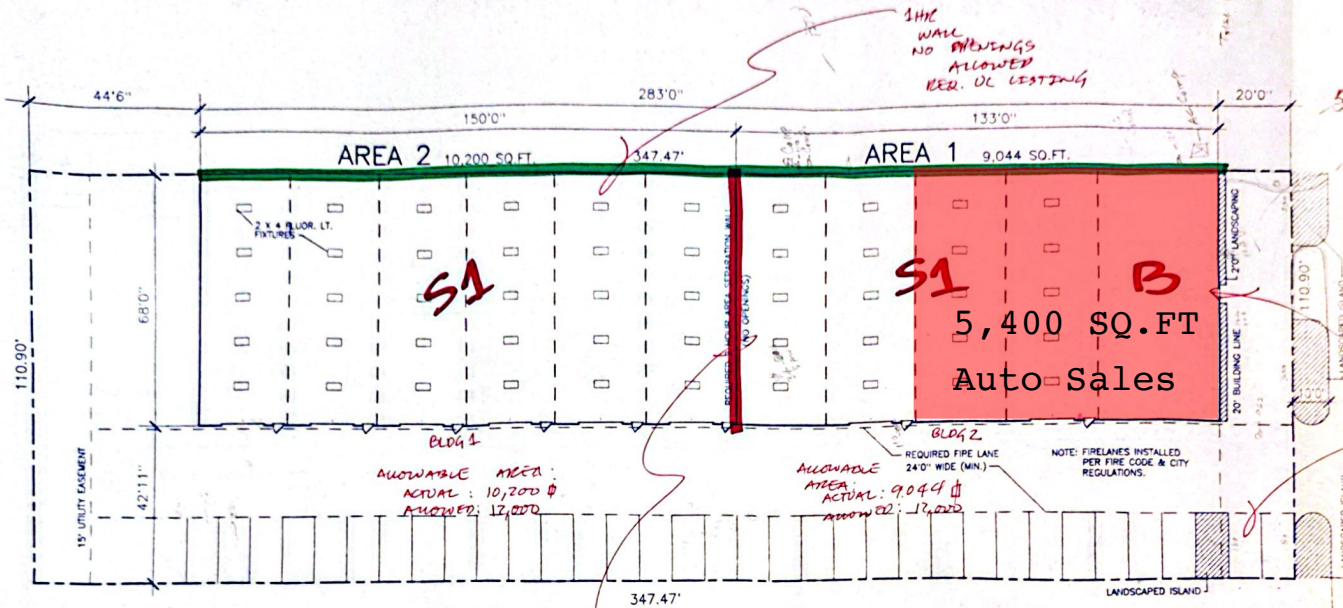

SIDE ELEVATION

SCALE: 1/16" = 1'0"

SITE PLAN
SCALE: 1/16" = 1'0" LOT - 3, BLOCK - A.

BLDG. DATA
CONST.: II-N
OCCP.: B/SA
SPRINK.: NO

* SEE REVIEW COMMENTS FOR MORE INFORMATION

APPROVED FOR CONSTRUCTION
CITY OF
WYLIE
SUBJECT TO FIELD INSPECTION
AND CODE COMPLIANCE
DATE: 1/10/16
BY: [Signature]

RDGS&
associates

architects

1 7 8 1 8
Davenport Road
Suite 119
Dallas, Texas
75252
(972) 407-6056
REVISED:



LONE STAR GRANITE
114 Regency Drive
Wylie, Texas